




Existing Ground Floor Plan
[annotated]

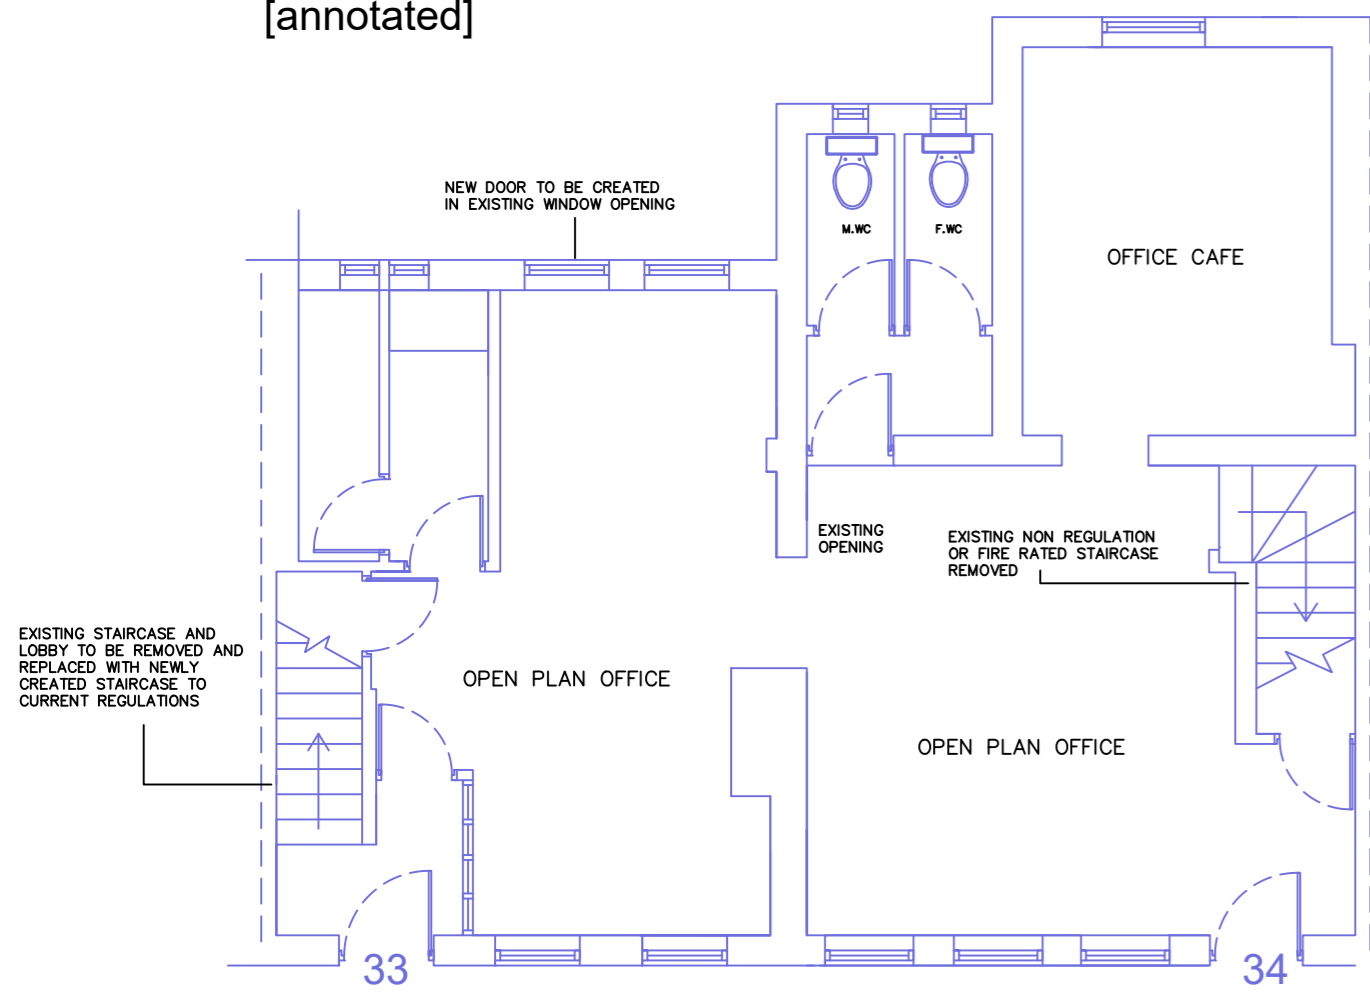


Existing First Floor Plan
[annotated]

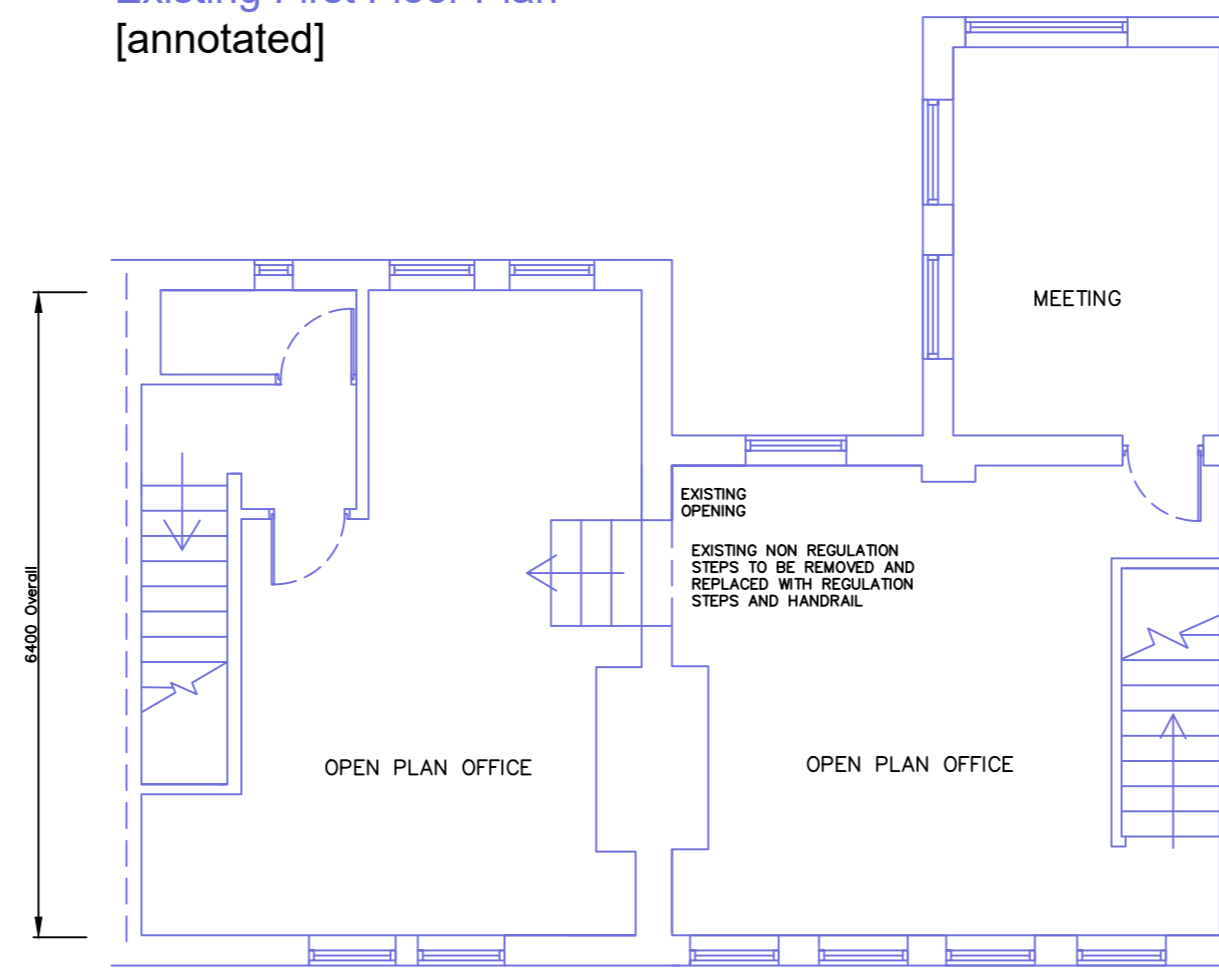


Existing loft space

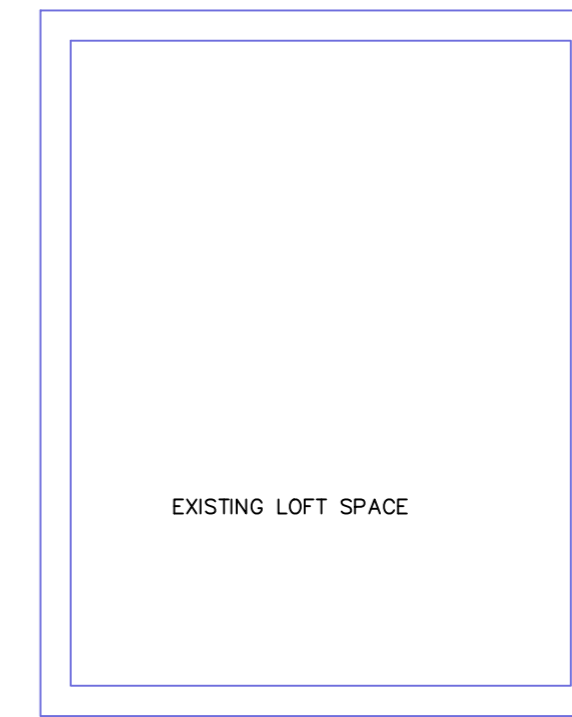



Proposed Ground Floor Plan

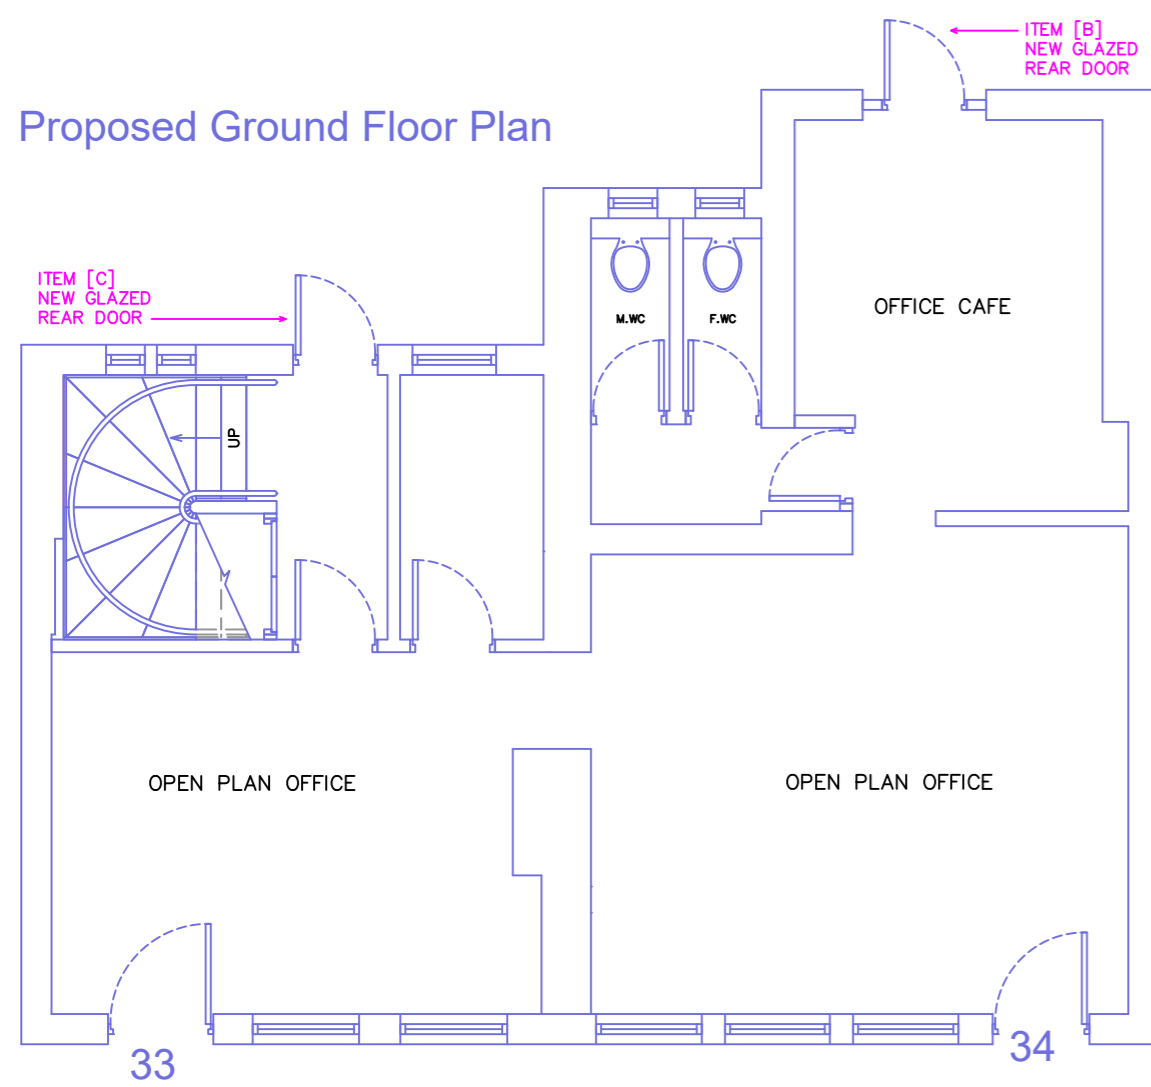

Proposed First Floor Plan

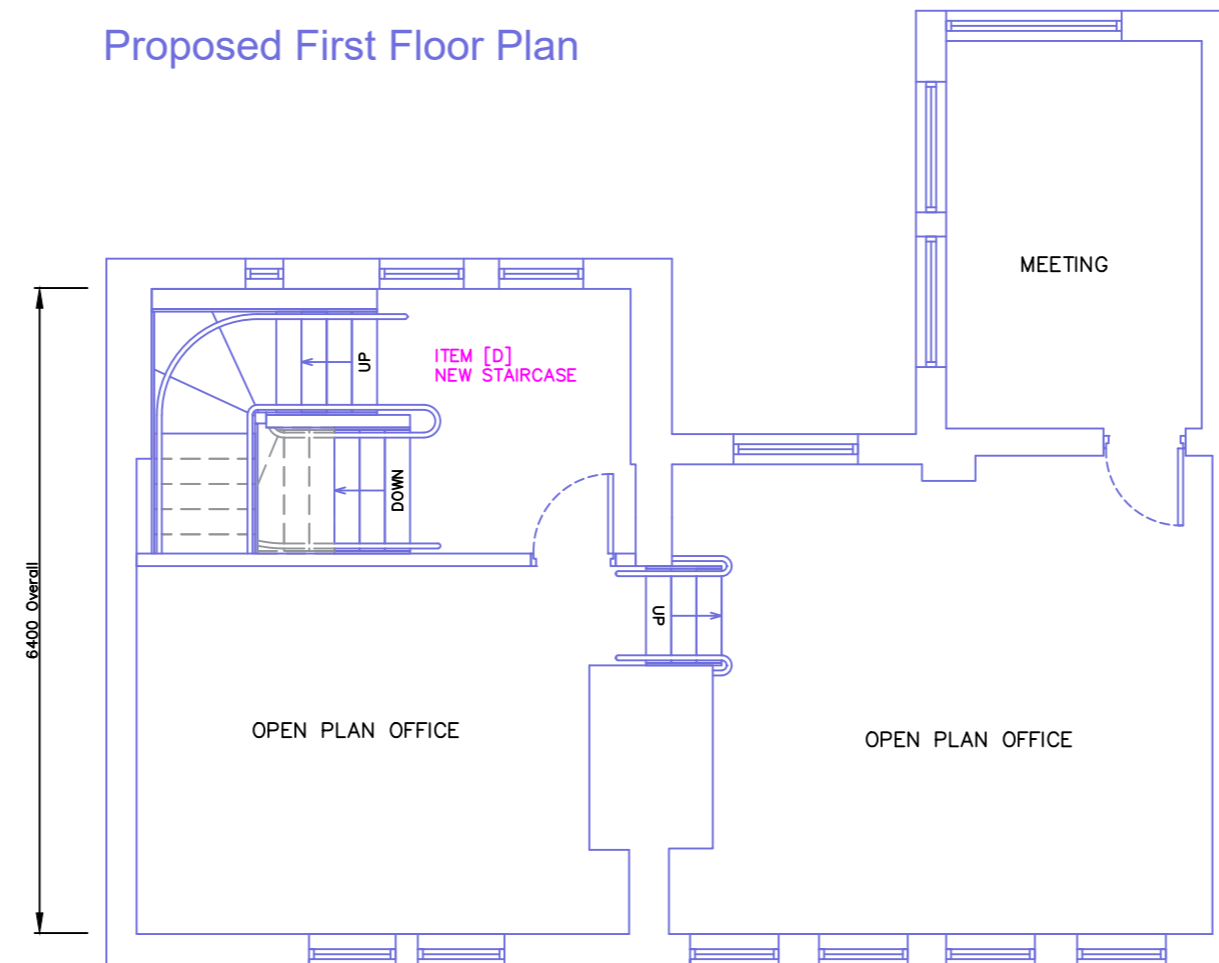

Proposed Second Floor Plan

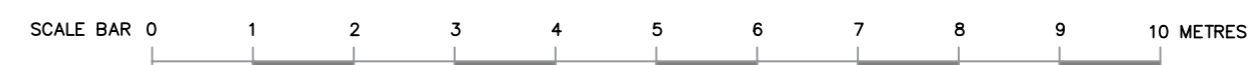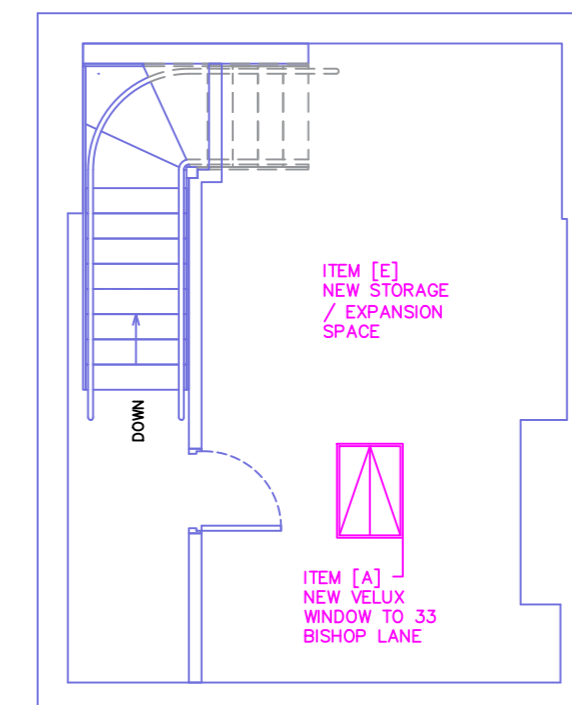

REVISION [K] First issue



RFD Interior Architecture
Commercial Office Interior Designers
www.theredfrog.com - 01482 22425

COMMENT [] APPROVAL [X] CONSTRUCTION [] AS BUILT []

PROJECT NO: S139 DATE: 28.12.20

DRAWING NO: 13 CAD FILE: 013.DWG

DRAWN: AJ OT REFERENCE: PLAN_EXIST_PROP

CLIENT: TENANT SCALE: 1:75 - A2

PROJECT: BISHOP LANE REVISION: K

ADDRESS: 33/34 BISHOP LN.

DRAWING IS COPYRIGHT OF RFD. ALL DIMENSIONS ARE APPROXIMATE AND SHOULD BE CHECKED ON SITE. RFD INTERIOR ARCHITECTURE IS A TRADING NAME OF RED FROG DESIGN LTD. HU1_11Q.