



Proposed Ground Floor Plan

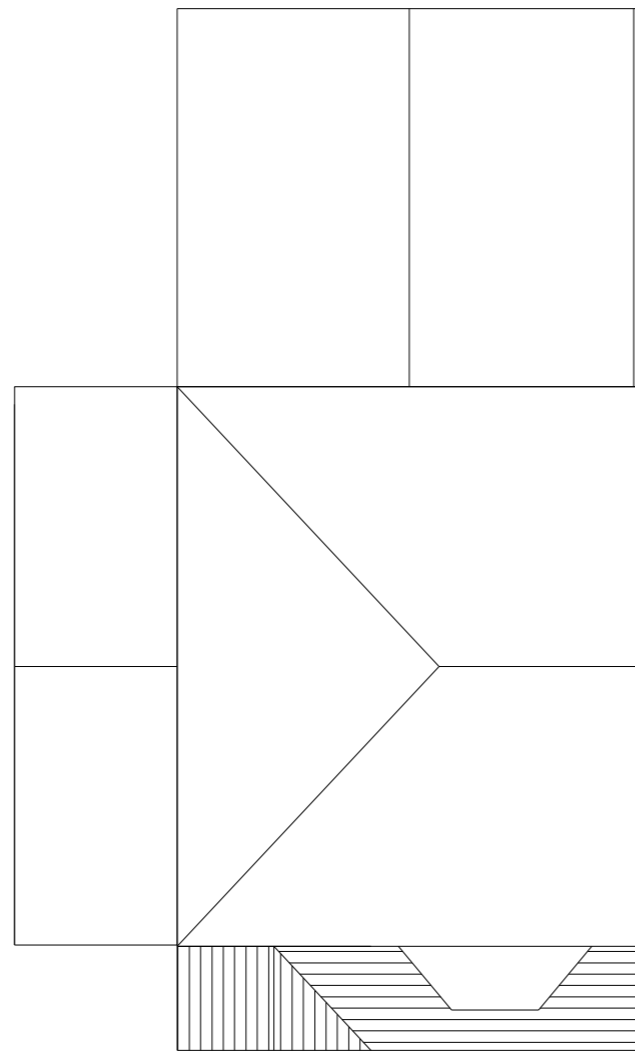



Proposed Roof plan

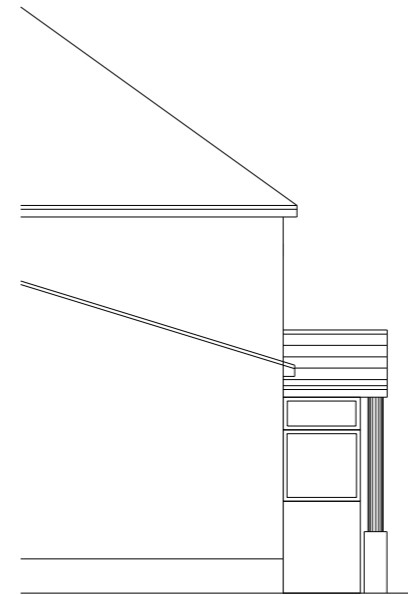

Proposed Side elevation



Proposed Rear elevation

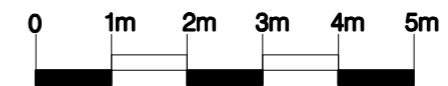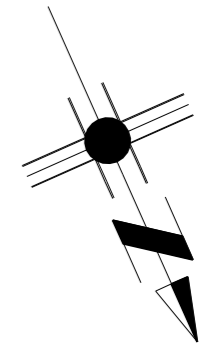

Client is to confirm if there are any public drainage pipes with 3 m of the proposed extension and then secure approval from Severn Trent to build within 3m of the pipes.

It is the responsibility of the client to serve all party wall notices to the adjoining owners 28 days prior to commencement of work on site if there is a dispute then a party wall surveyor is to be appointed

Client		Job no.	
Project	Permission to retain front porch and canopy 6 BERNARD ROAD B68 6AP	Org.no.	1
Title	As Built plans and Elevations	Rev.	
		Scale.	1:100-AS
		Date.	21.12.20

Arcon Architects Ltd
Architecture and Conservation

280 Walsall road, Great Barr, Birmingham, B42 1UB
tel- 07798 859861 - email - arcon.uk@gmail.com

