

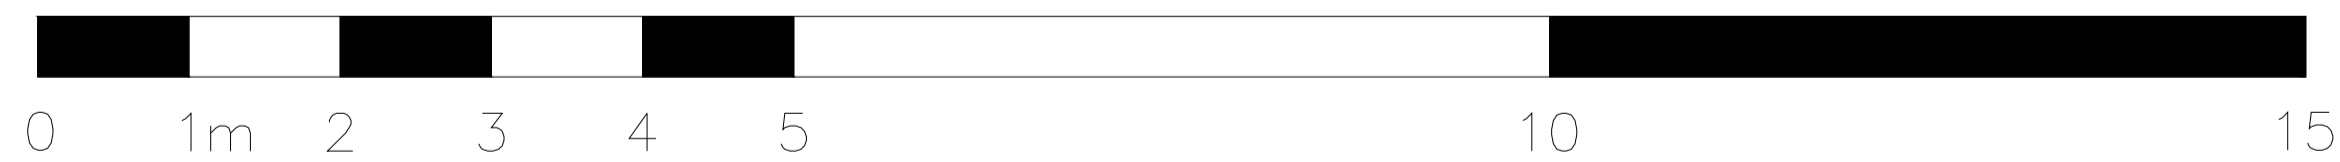
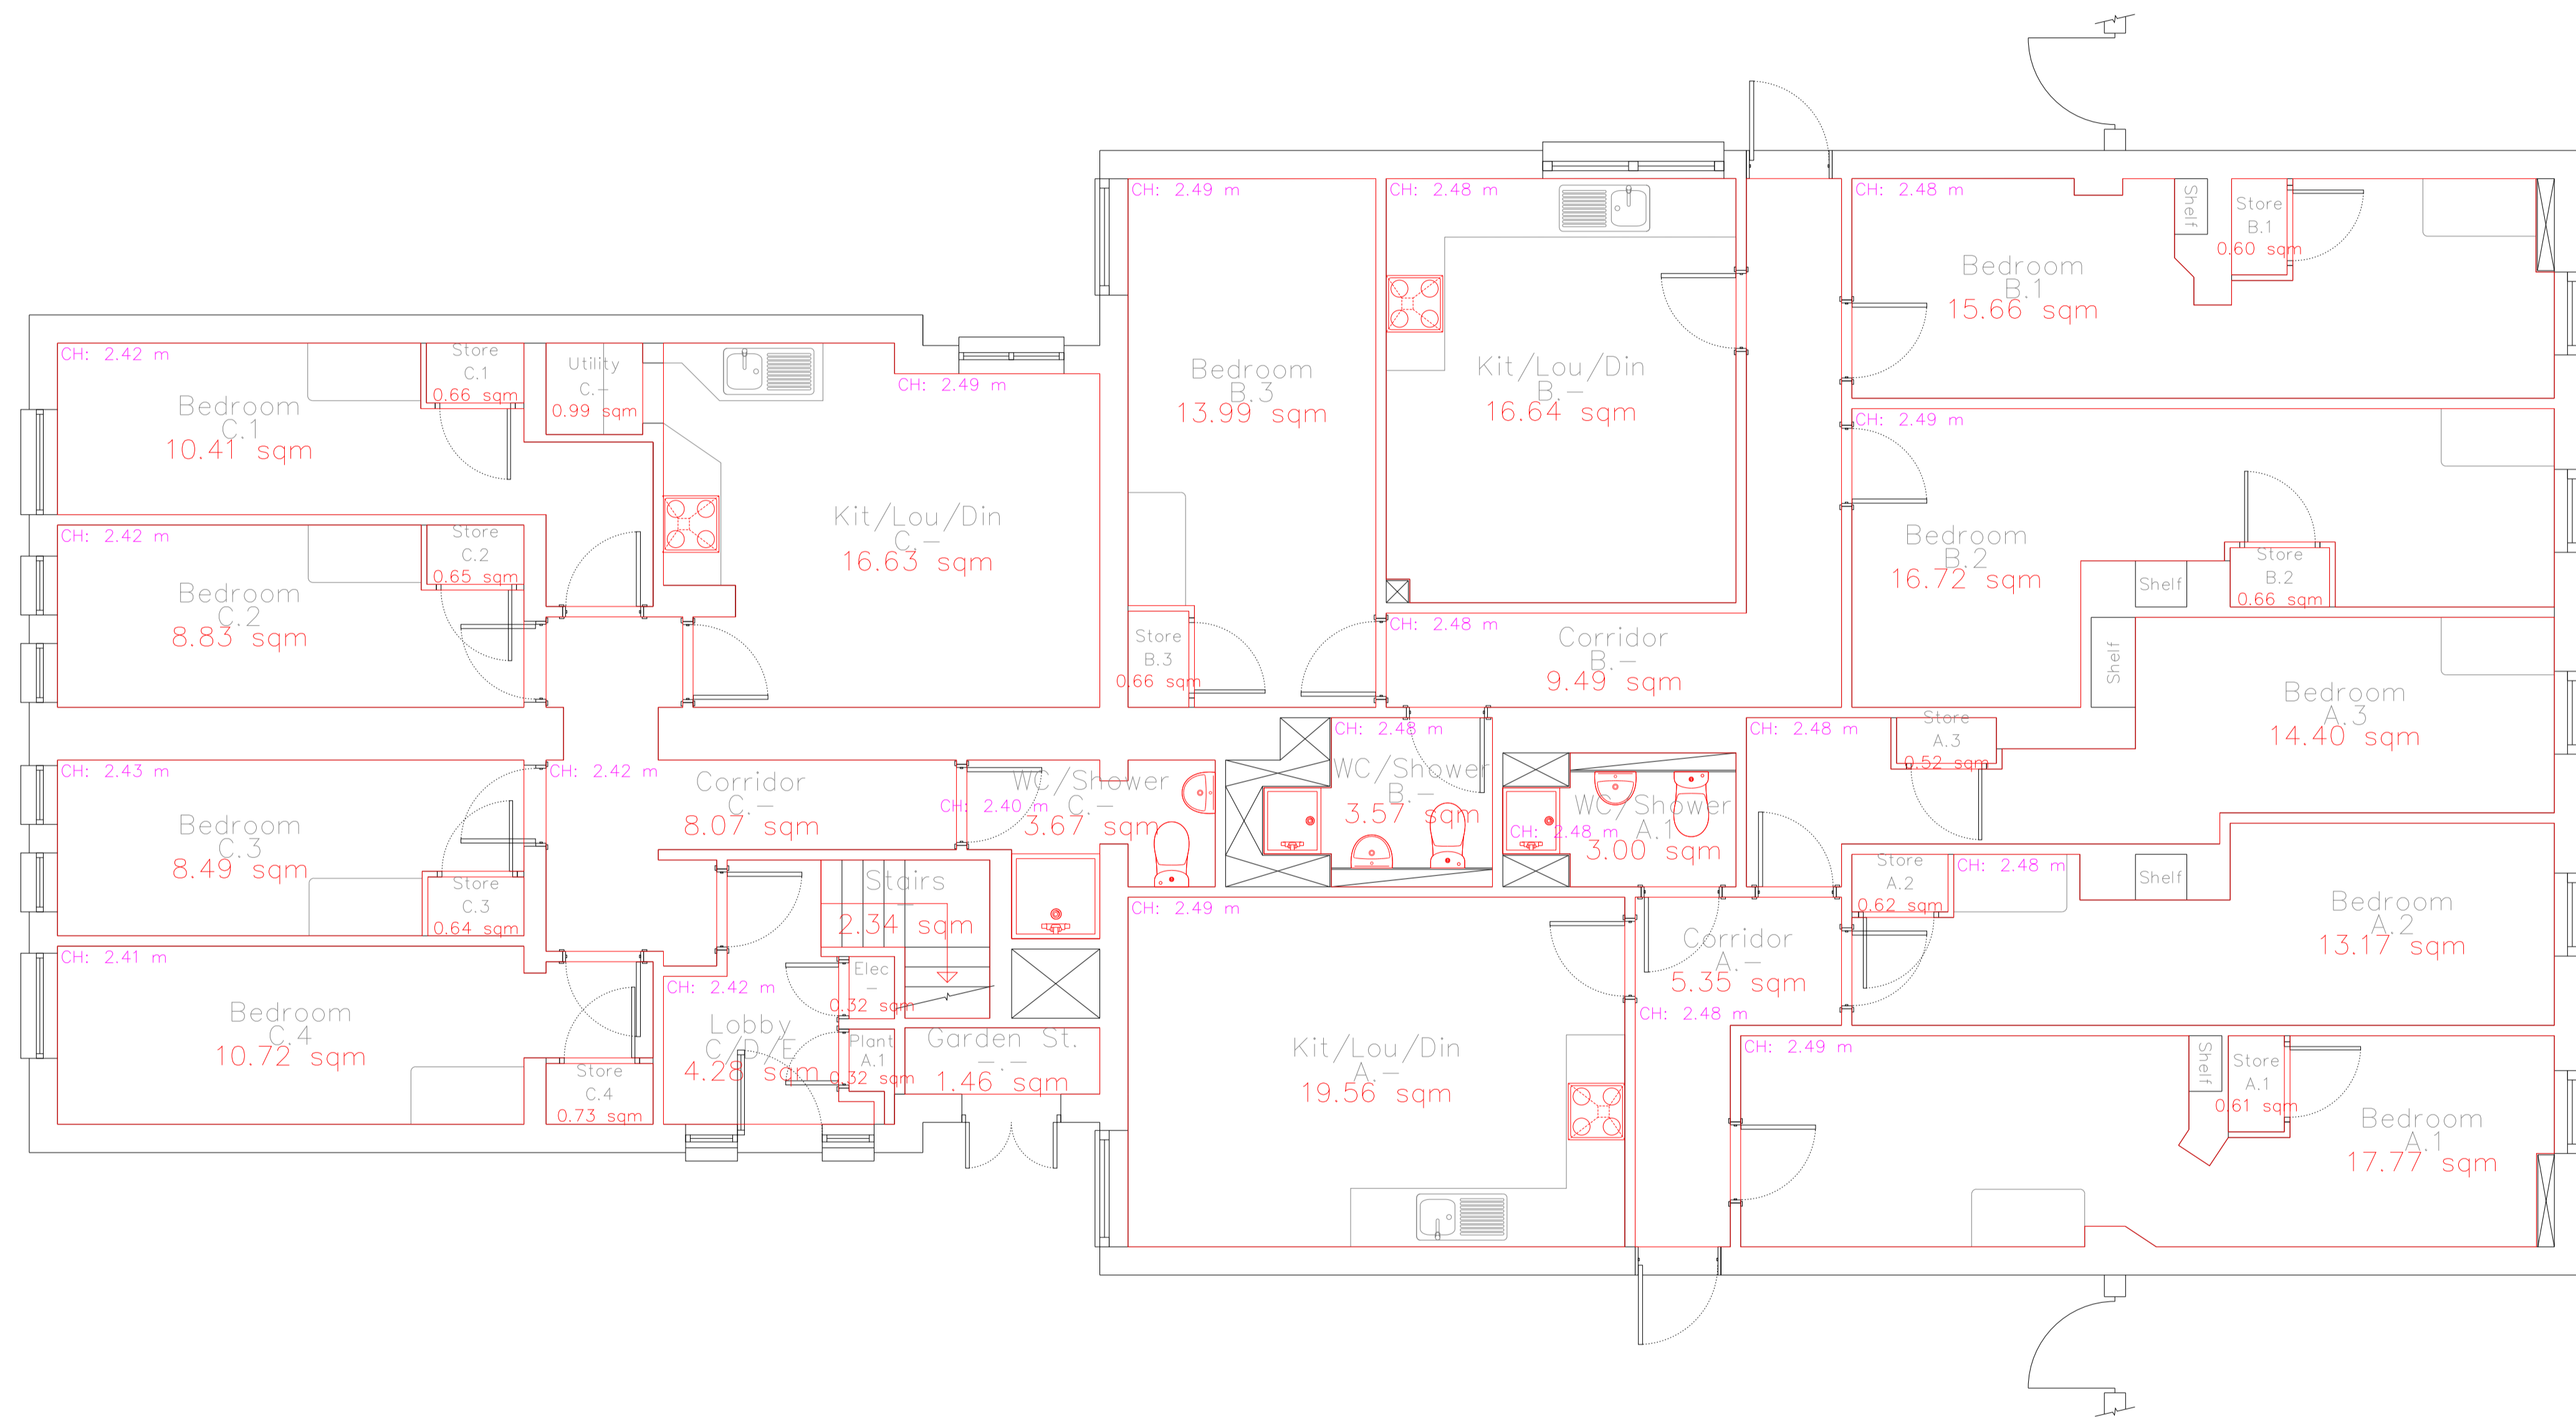


Created by:	
 Churchill Court, Palmerston Road Bournemouth, Dorset BH1 4HN Tel: 01202 443300 Fax: 01202 443301 Web: www.topscan.co.uk Email: info@topscan.co.uk	
Client:	
Portsmouth City Council Civic Offices Guildhall Square PO1 2AL	
Drawing Title:	
Elm Grove Library Site Plan	
Date:	Scale:
01/12/2020	1:100
Status:	Size:
AS BUILT	A1

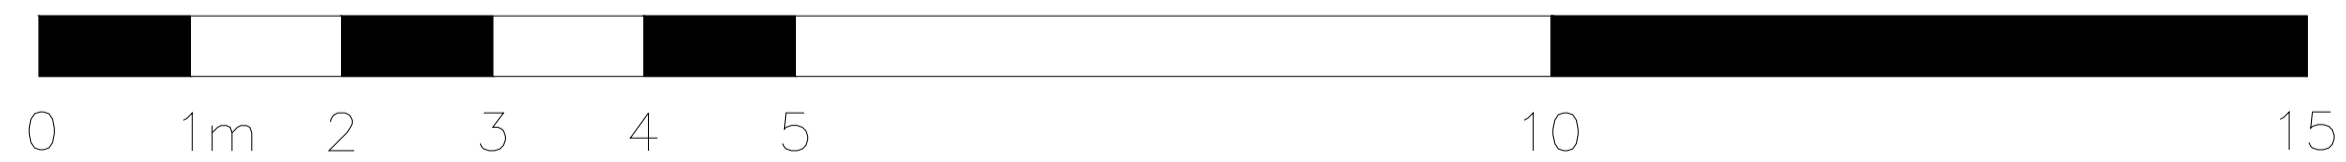

Created by:			
Churchill Court, Palmerston Road Bournemouth, Dorset BH1 4HN Tel: 01202 443300 Fax: 01202 443301 Web: www.topscan.co.uk Email: info@topscan.co.uk			
Client:		Portsmouth City Council Civic Offices Guildhall Square PO1 2AL	
Drawing Title:		Elm Grove Library Ground Floor	
Date:	01/12/2020	Scale:	1:50
Status:	AS BUILT	Size:	A1

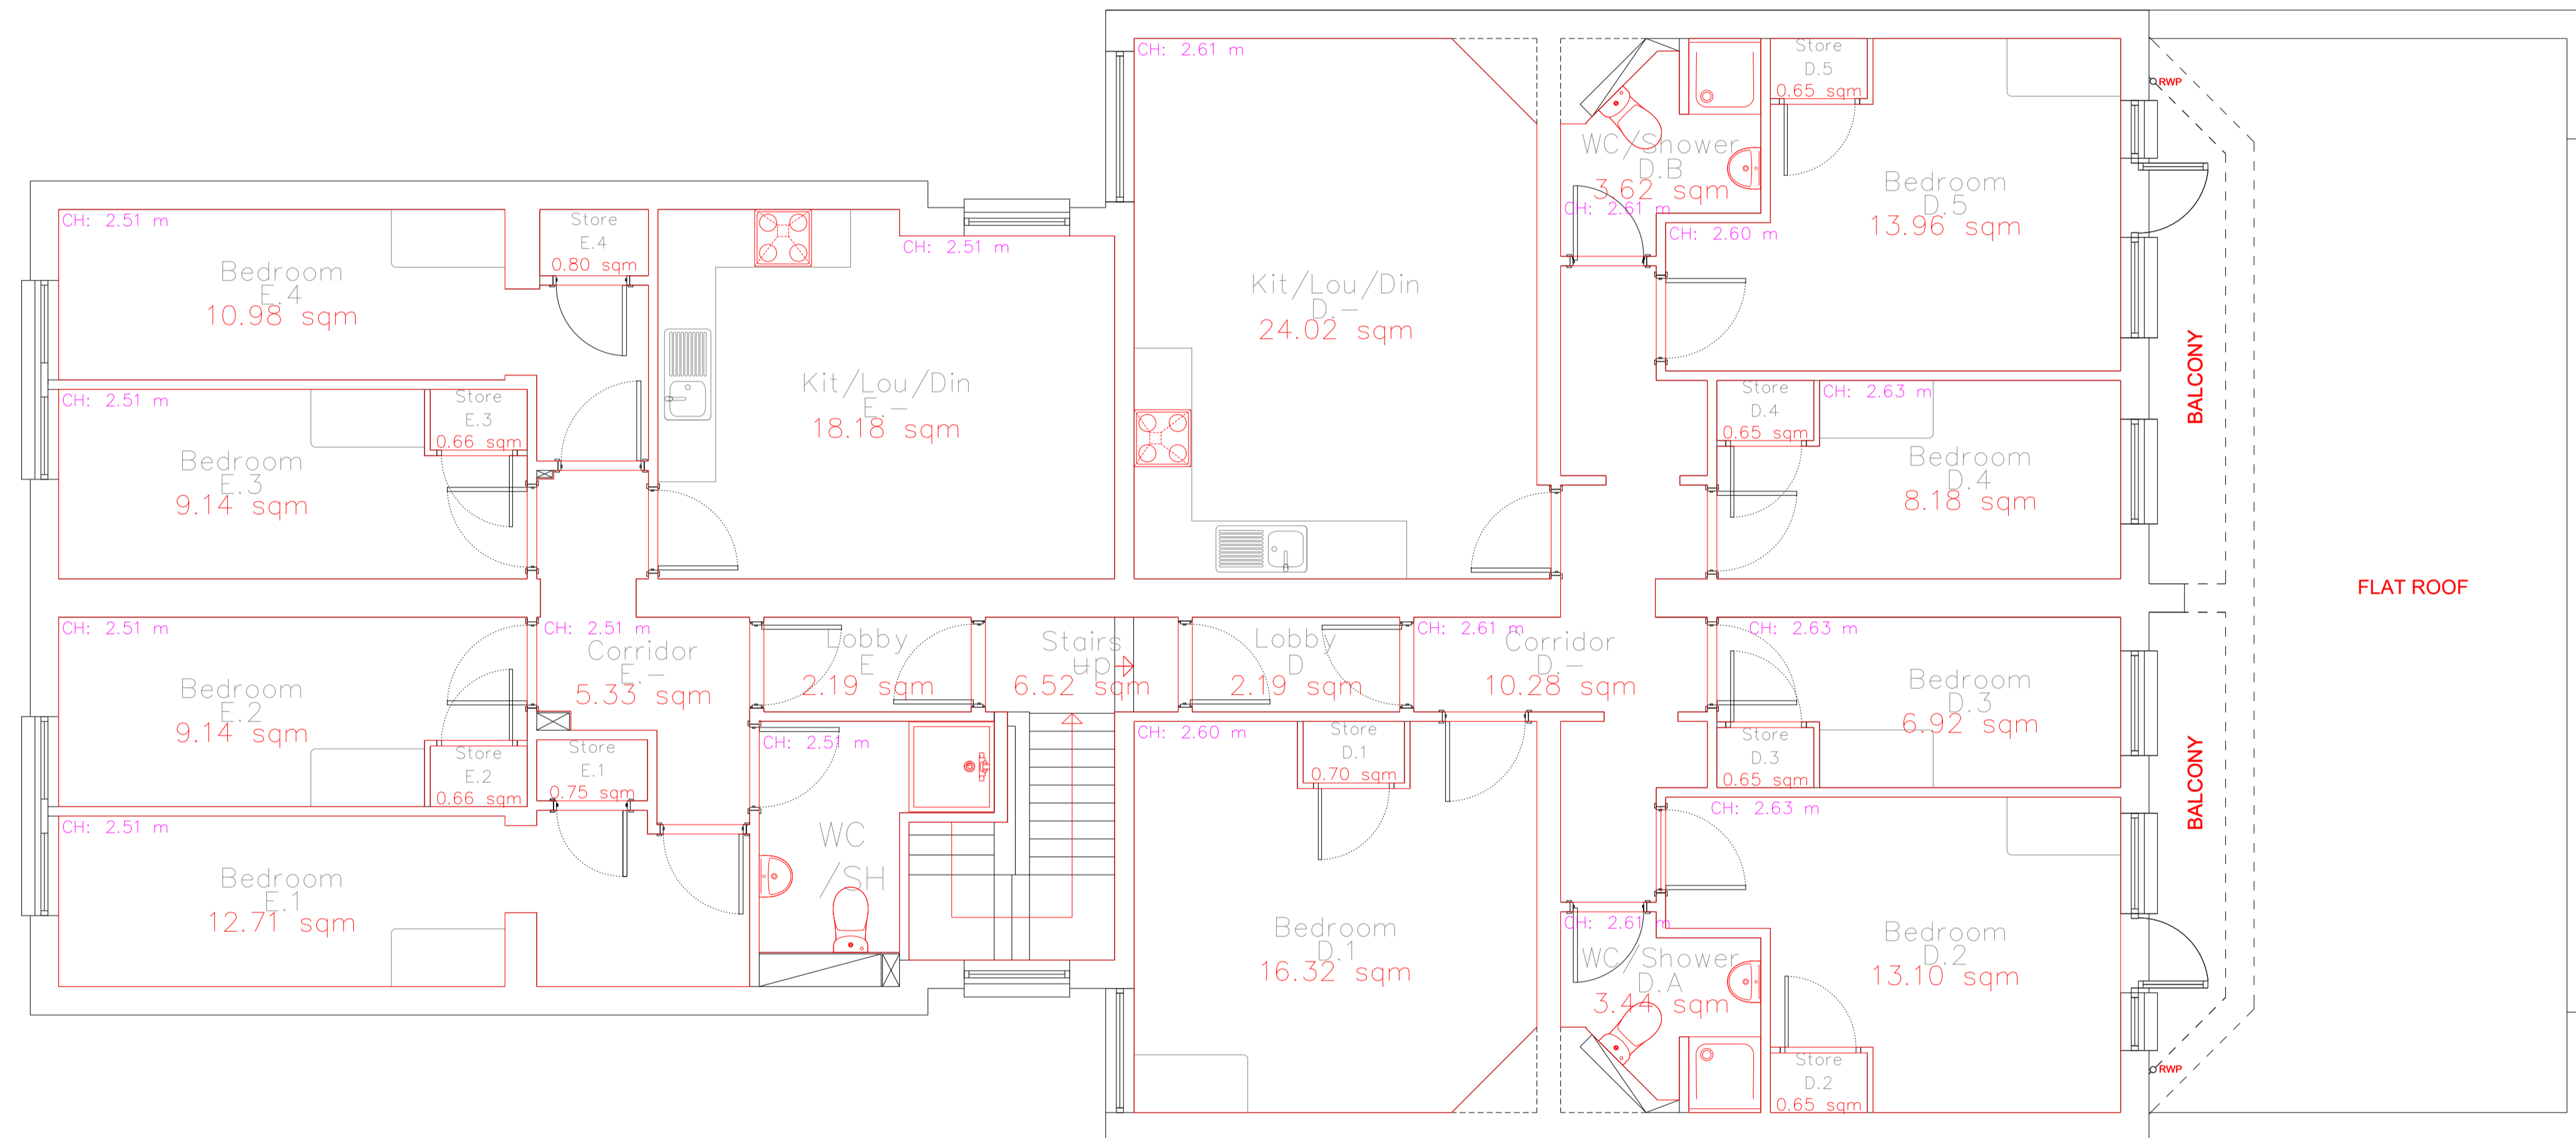

Created by:



Churchill Court, Palmerston Road  
 Bournemouth, Dorset BH1 4HN  
 Tel: 01202 443300 Fax: 01202 443301  
 Web: www.topscan.co.uk Email: info@topscan.co.uk

Client:

Portsmouth City Council  
 Civic Offices  
 Guildhall Square  
 PO1 2AL

Drawing Title:

Elm Grove Library  
 First Floor

Date:

01/12/2020

Scale:


1:50


Status:

AS BUILT

Size:


A1

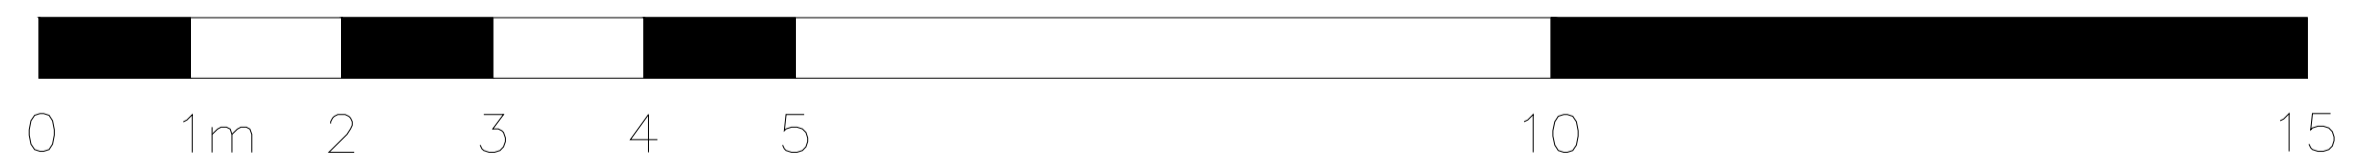

Created by:		 Churchill Court, Palmerston Road Bournemouth, Dorset BH1 4HN Tel: 01202 443300 Fax: 01202 443301 Web: www.topscan.co.uk Email: info@topscan.co.uk	
Client:		Portsmouth City Council Civic Offices Guildhall Square PO1 2AL	
Drawing Title:		Elm Grove Library Roof Layout	
Date:	01/12/2020	Scale:	1:50
Status:	AS BUILT	Size:	A1



ELEVATION A (North)

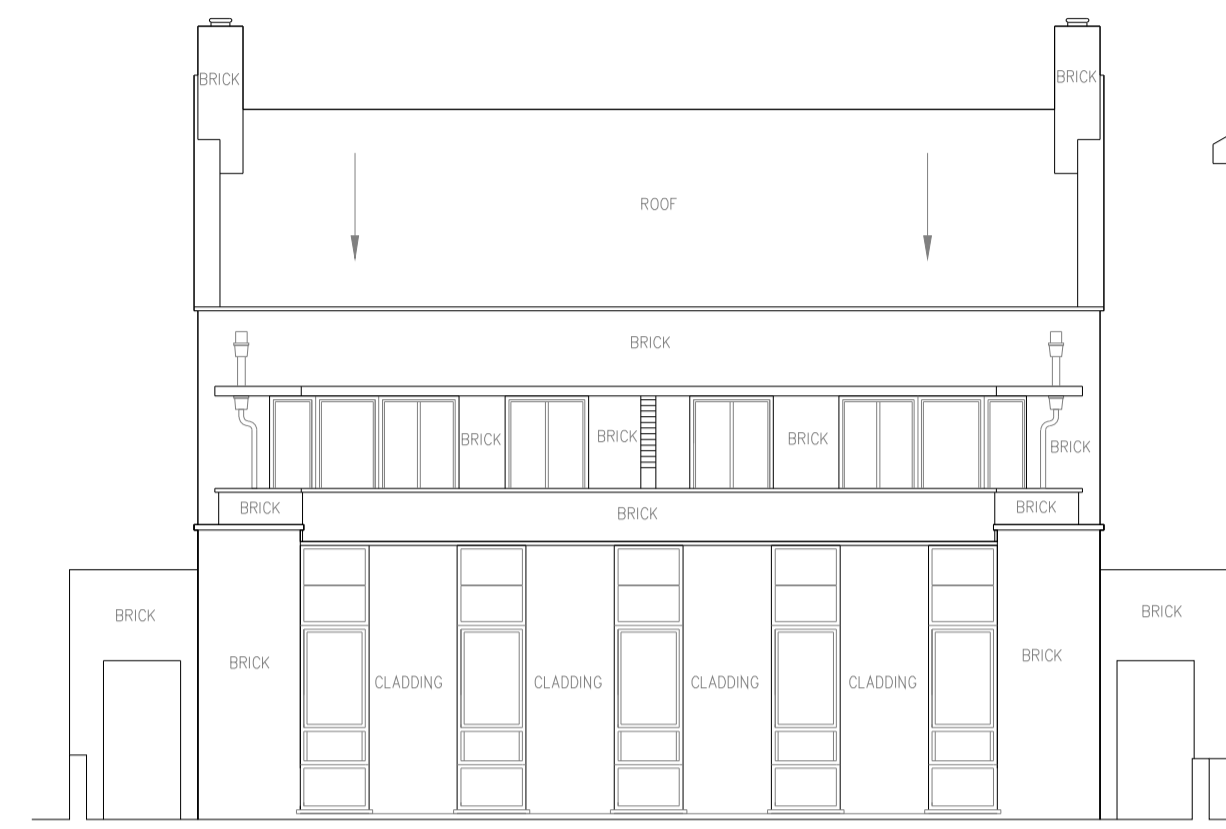

ELEVATION C (South)

Local Datum 0.00m





ELEVATION B (East)

Local Datum 0.00m



ELEVATION D (West)

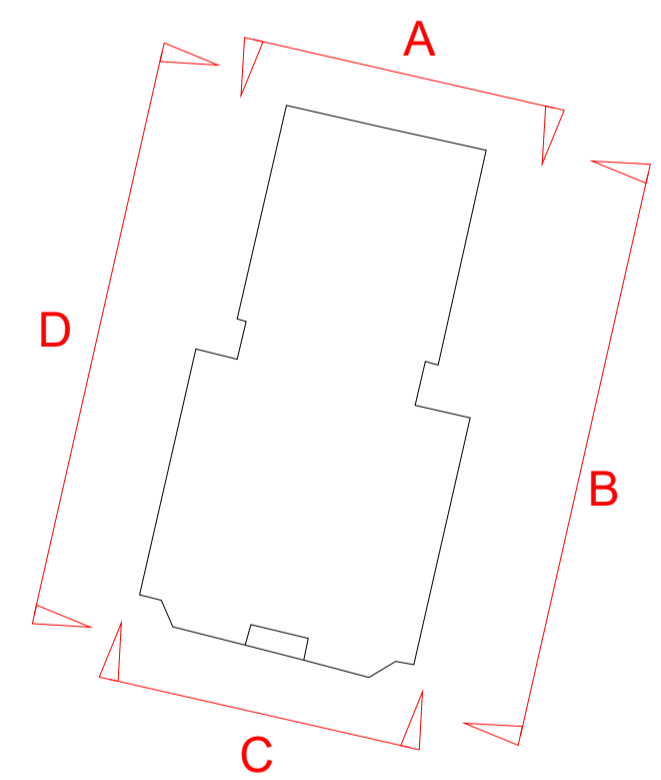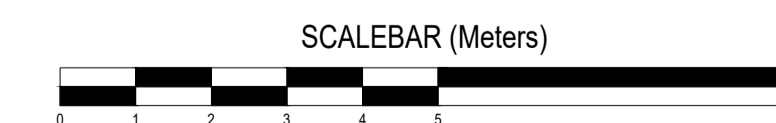

Created by:



Churchill Court, Palmerston Road  
Bournemouth, Dorset, BH1 4HN  
Tel: 01202 443300 Fax: 01202 443301  
Web: www.topscan.co.uk Email: info@topscan.co.uk

Client:

Portsmouth City Council  
Civic Offices  
Guildhall Square  
PO1 2AL

Drawing Title:

Elm Grove Library  
ELEVATIONS

Date:

01/12/2020

Scale:

1:100

Status:

AS BUILT

Size:

A1