



Location of signage


Rev	A	Issue for planning	SPK	05.02.20
Rev		Description	By	Date
Client	Zurich Assurance Ltd			
Job	Three Barrington Road - Altrincham			
Drawing	Site Location Plan			
Rev	P4961_1003		Rev	A
4961-PAL-20-00-DR-A-1003				
Date	03/02/20	Scale	1 : 1250	
SPK		SPK		SOR
Project Stage	Planning	Tender	Construction	
	Design	Contract	As Built	

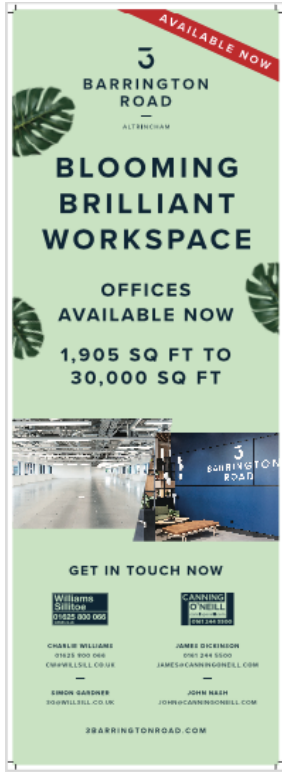

SIGNAGE DESIGN
 W 2500mm
 H 7000mm
 Not illuminated
 Positioned flat against the wall

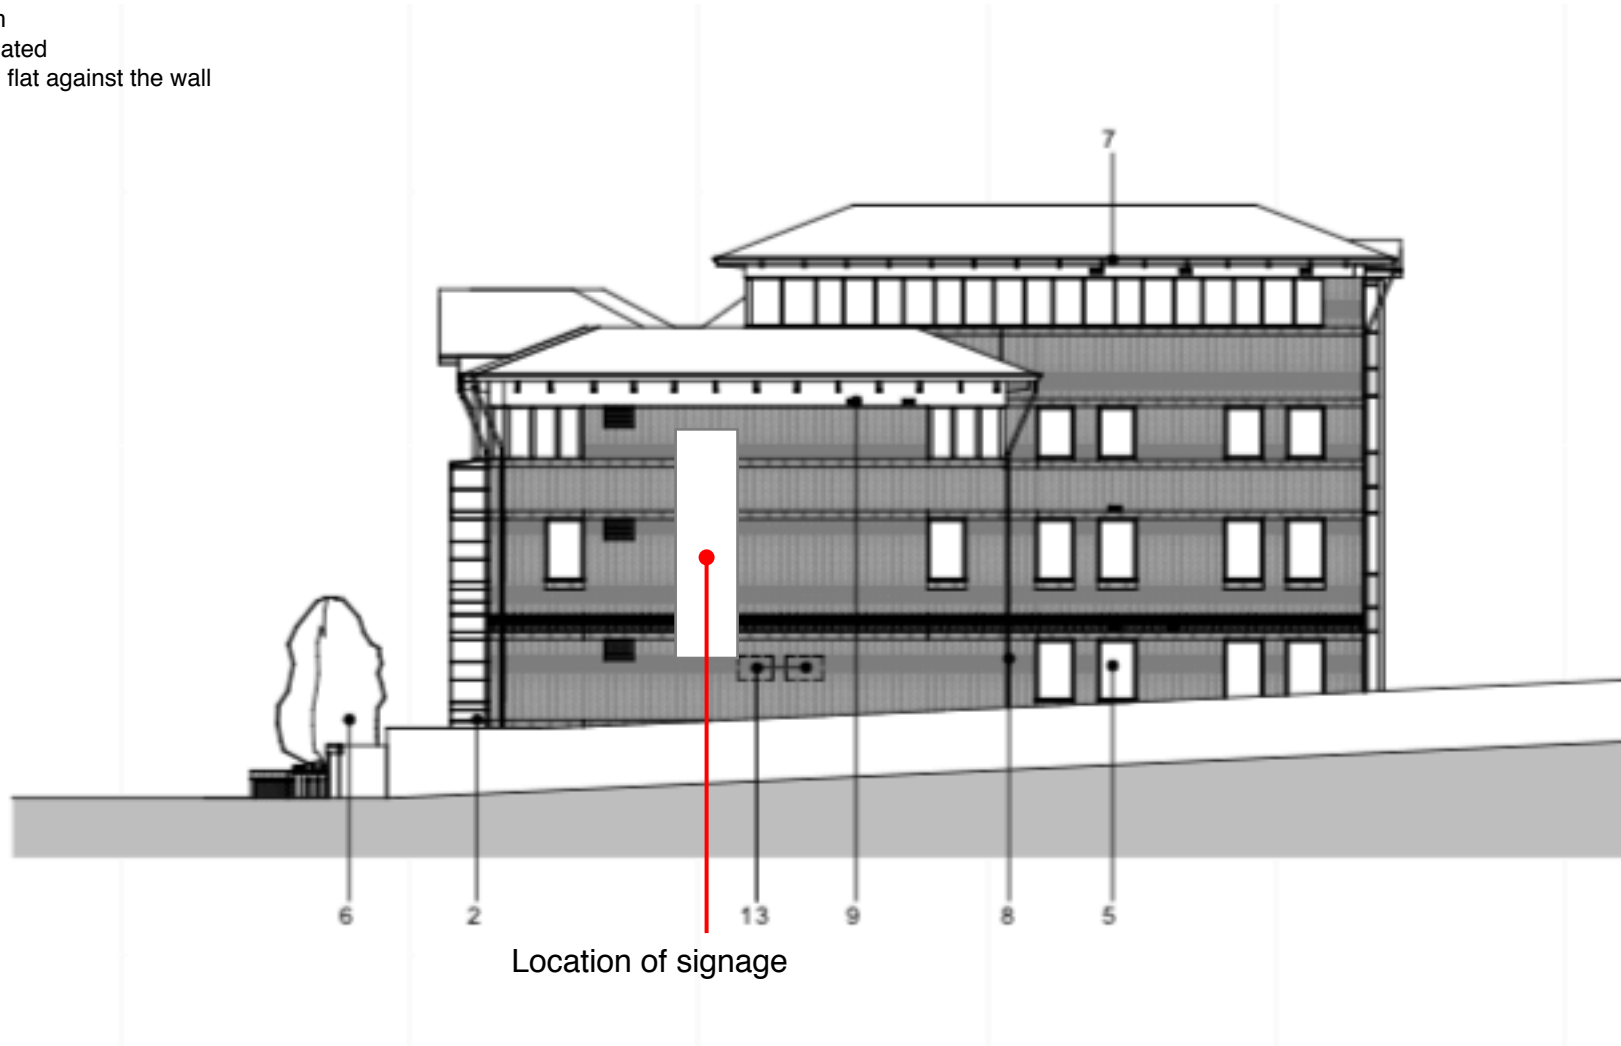

Rev	Description	By	Date
J	Updated to include secure plant compound cages, acoustic screen and slatted screen fixed to existing wall. Issued for Planning	SPK	23.04.20
Client	Zurich Assurance Ltd		
Job	Three Barrington Road - Altrincham		
Drawing	Proposed GA Elevations North South		
Sheet No	P4961_3001	Rev	J
Project No	4961-PAL-18-XX-DR-A-3001		
Date	19/03/18	Scale	1:100 @ A1
Prepared by	SPK	Checked by	SPK
Approved by	JW	Project No	
Project Stage	Planning	Tender	Construction
	Design	Contract	As Built
pozoni			
London House 115 Golden Lane London EC1Y 0TJ		Woodville House 2 Woodville Road Altrincham WA14 2FH	
+44 20 7078 0079 architect@pozoni.co.uk		+44 161 928 7848 www.pozoni.co.uk	

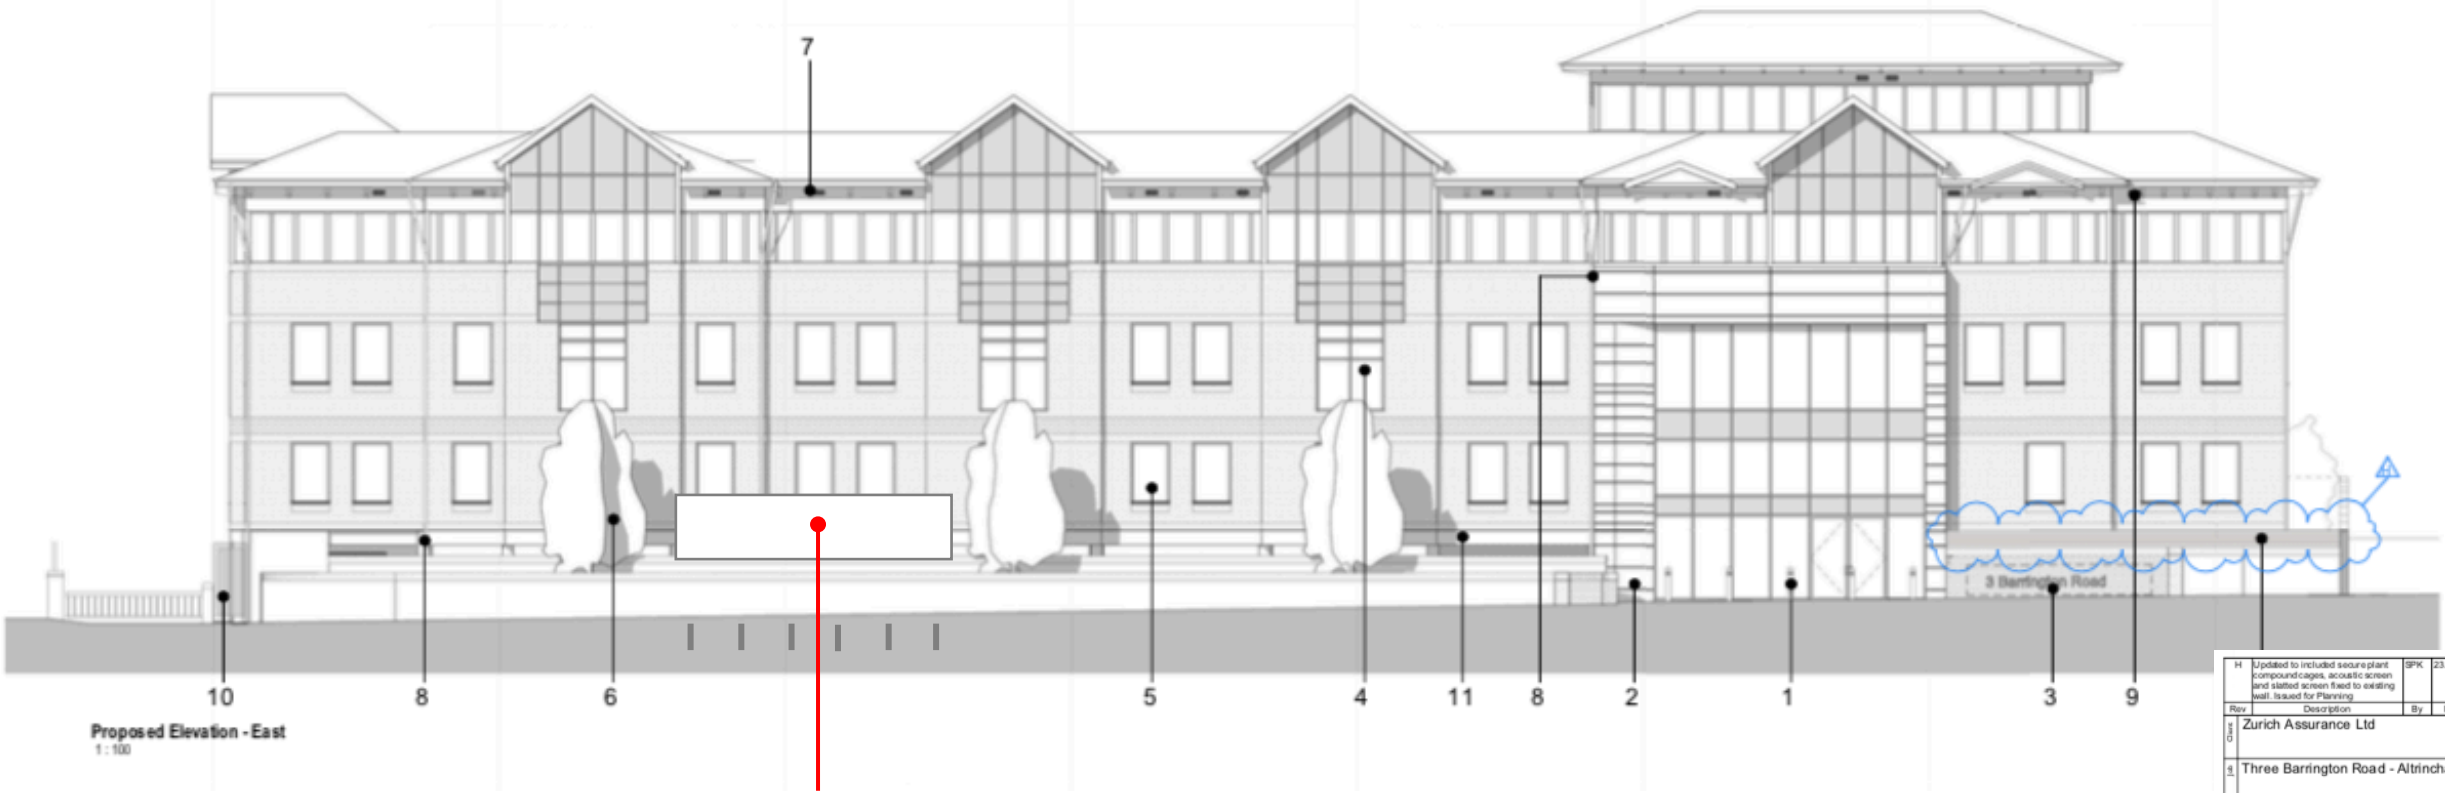

Proposed Elevation - East
1 : 100

Location of signage

Rev	Description	By	Date
H	Updated to include secure plant compound cages, acoustic screen and slatted screen fixed to existing wall. Issued for Planning	SPK	23/04/20
Zurich Assurance Ltd			
Three Barrington Road - Altrincham			
Proposed GA Elevations East West			
P4961_3000			H
4961-PAL-18-XX-DR-A-3000			
Date	Scale	Sheet	Size
19/03/18	1 : 100		@ A1
Prepared by	Checked by	Approved by	
SPK	SPK	JW	
Planning	Tender	Construction	
Design	Contract	As Built	
pozzoni			
London House 115 Golden Lane London EC1Y 0TJ		Woodville House 2 Woodville Road Altrincham WA14 2PH	
+44 20 7078 0079 architects@pozzoni.co.uk		+44 161 938 7848 www.pozzoni.co.uk	

GET IT TOUCH NOW

CHIEF OFFICER
OPERATIONS
3 BARRINGTON ROAD
ALTRINCHAM
WA14 2PH
0161 938 7848
www.pozzoni.co.uk

CHIEF OFFICER
OPERATIONS
3 BARRINGTON ROAD
ALTRINCHAM
WA14 2PH
0161 938 7848
www.pozzoni.co.uk

SALES MANAGER
OPERATIONS
3 BARRINGTON ROAD
ALTRINCHAM
WA14 2PH
0161 938 7848
www.pozzoni.co.uk

3 BARRINGTON ROAD

BLOOMING

BRILLIANT WORKSPACE

1,905 SQ FT TO 30,000 SQ FT AVAILABLE NOW

AVAILABLE NOW

SIGNAGE DESIGN
W 9000mm
H 1500mm
Distance from ground (1000mm)
Not illuminated