




NORTH WEST ELEVATION

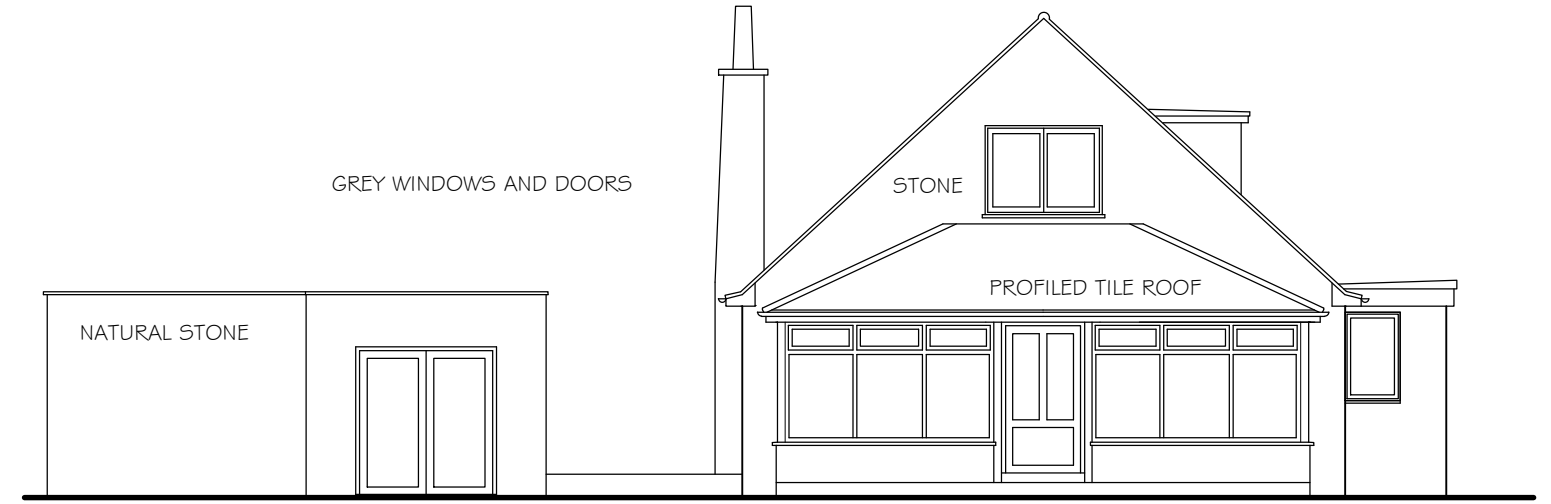


SOUTH WEST ELEVATION

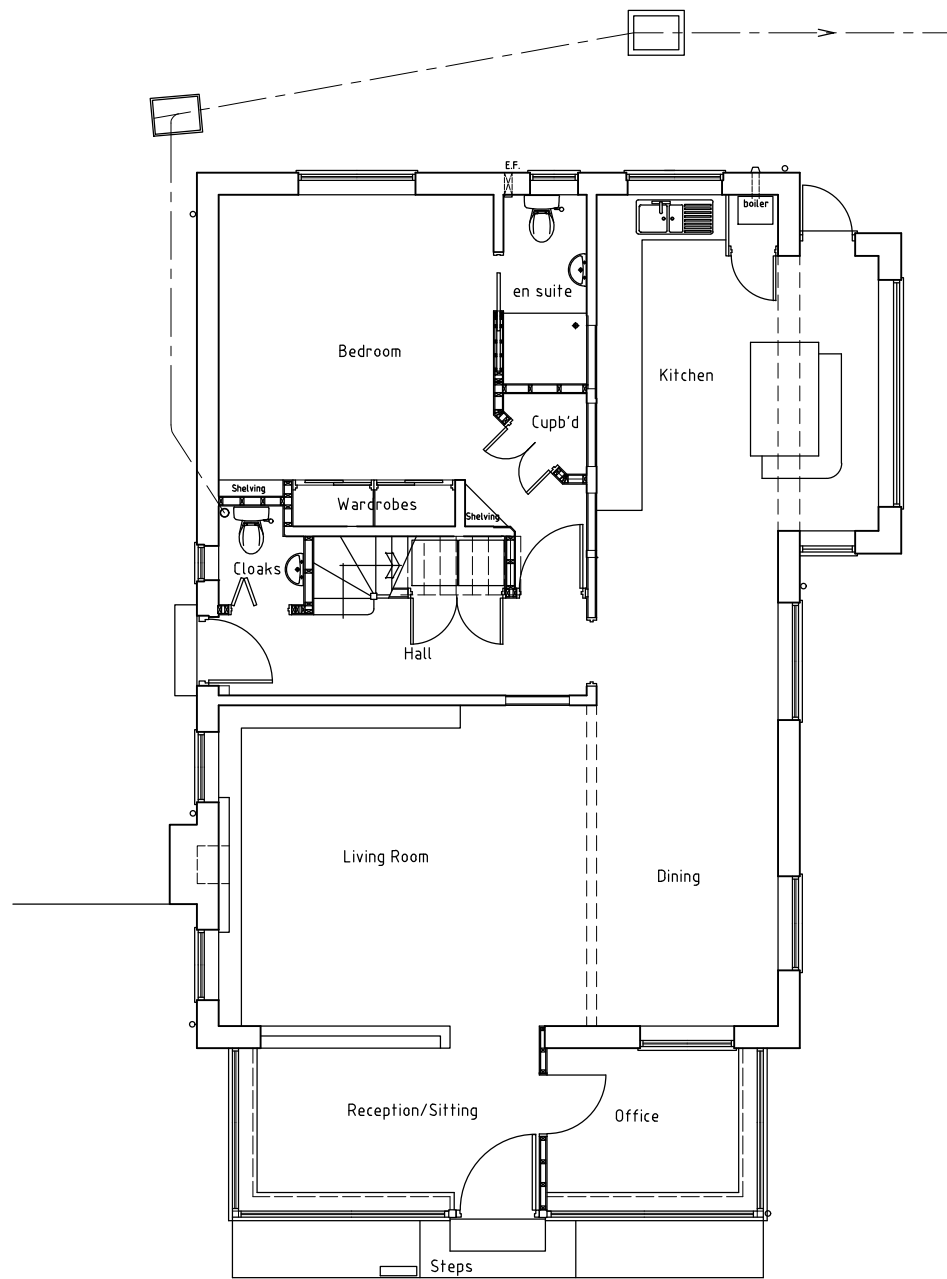

GROUND FLOOR PLAN

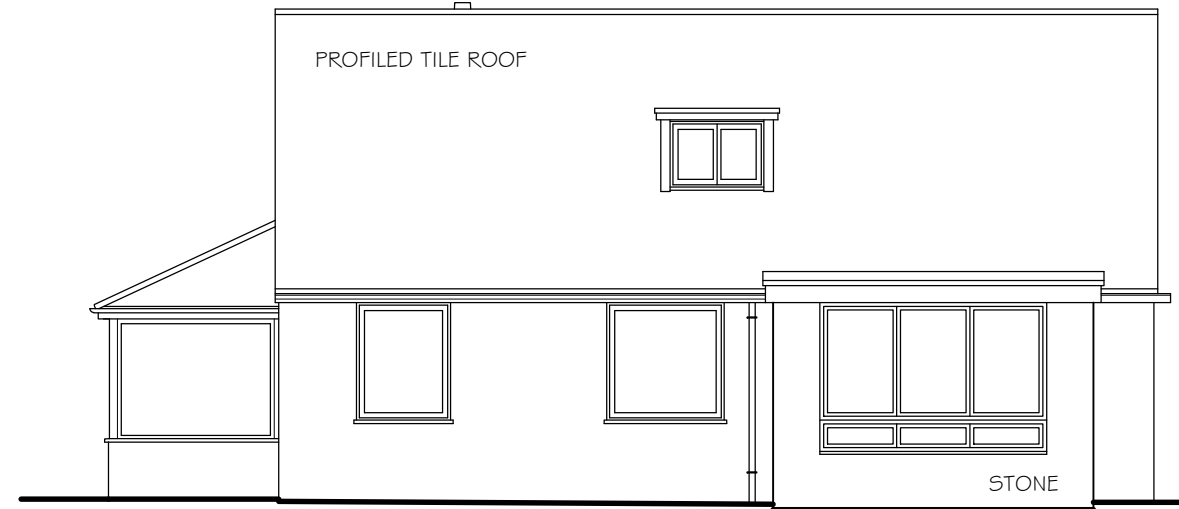

SOUTH EAST ELEVATION - assumed

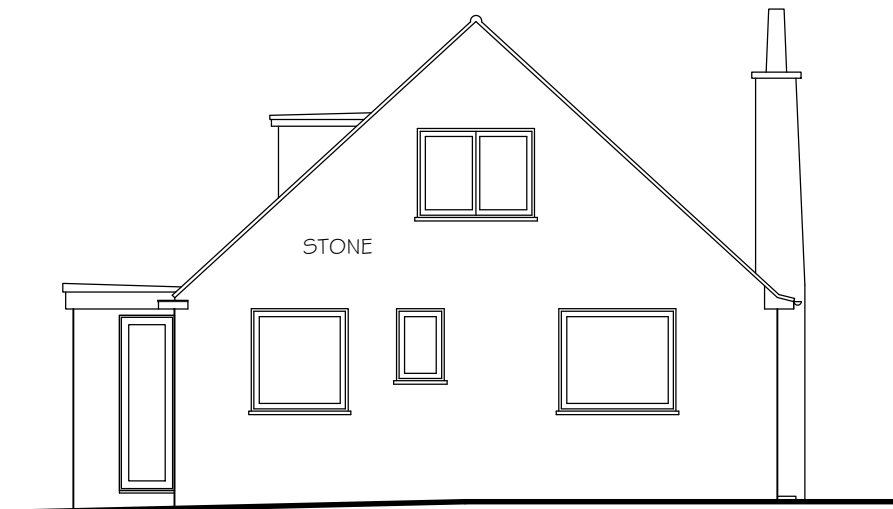

NORTH EAST ELEVATION - assumed

This drawing has been prepared from drawings prepared by others and visual interpretation from a limited amount of photographs making an as built set of existing plans - verify all items on site prior to putting work in hand.

0 10 20 30 40 50mm @ A3 1:1

JM ARCHITECTURE LTD

EXTENSIONS & ALTERATIONS
 GALLEONS LAP
 GREENHAYES, SHIPTON GORGE, DORSET
 PLANS OF THE EXISTING

SCALE 1:100 | NOV 20 | DRG No 1166/S1

9 CHANCERY LANE • BRIDPORT • DORSET DT6 3PX

TEL 01308 427224

101220