

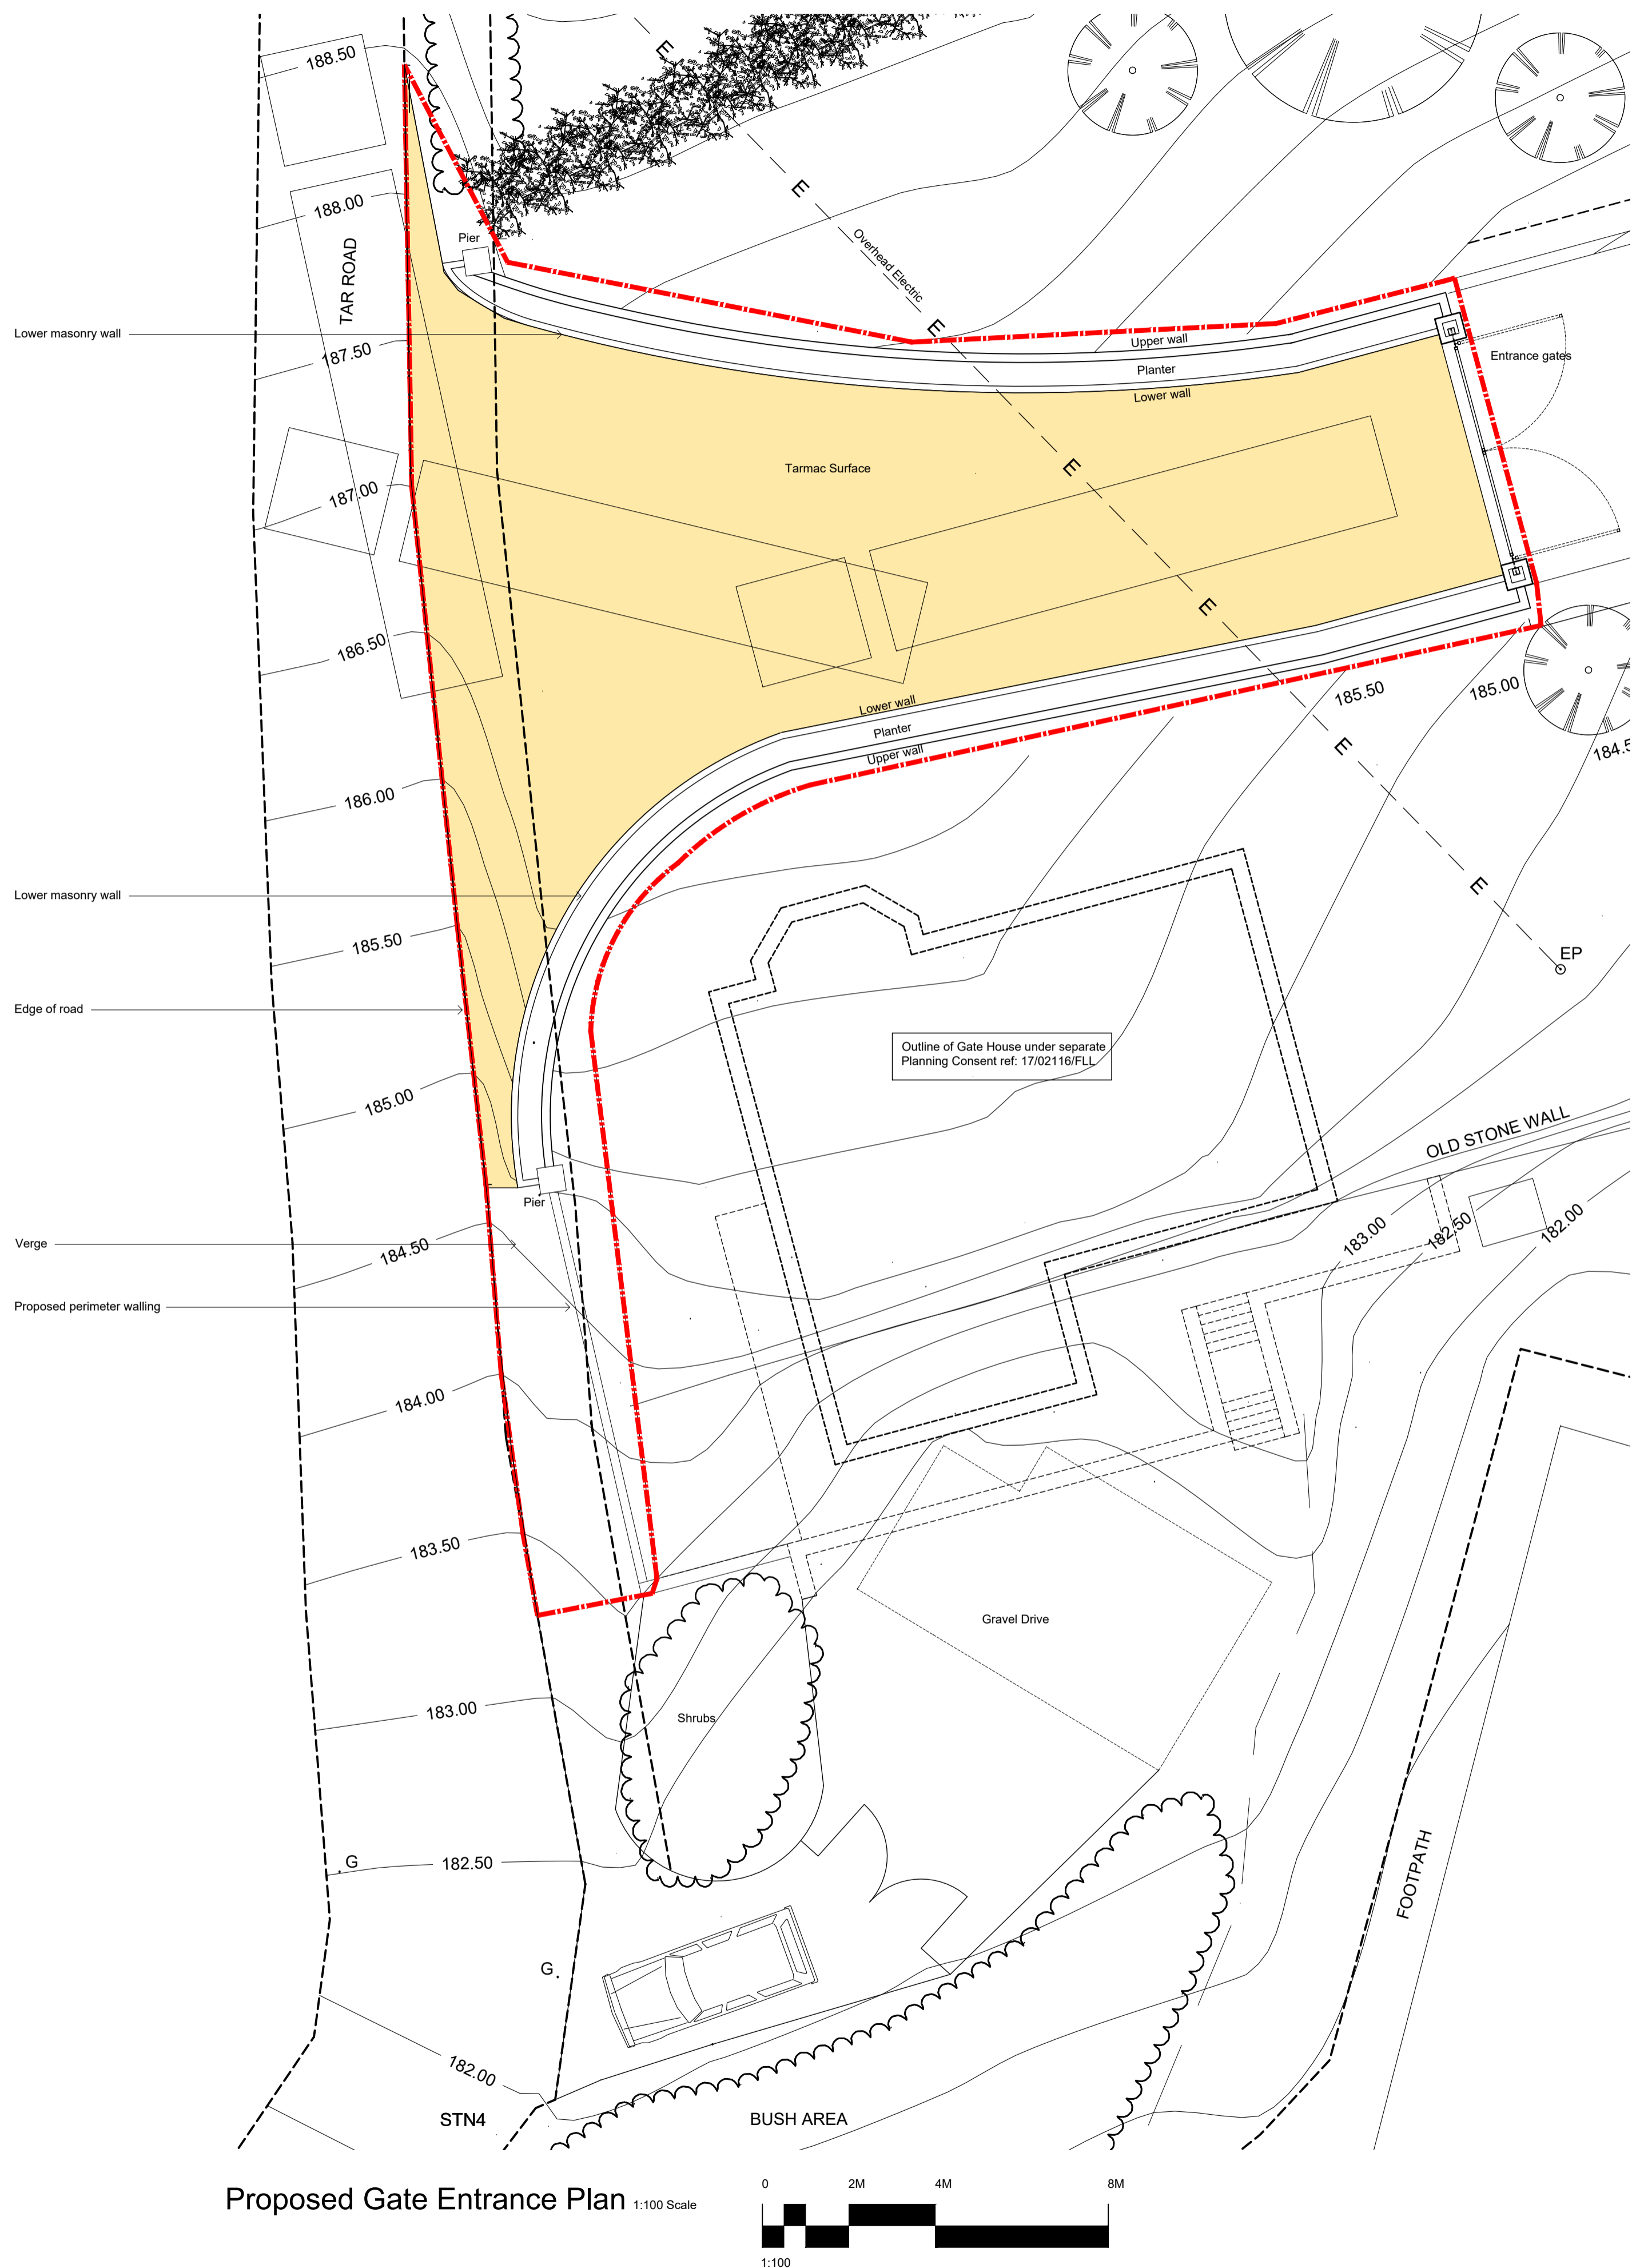



1. All boundaries, dimensions and levels are to be checked on site before construction and any discrepancies are to be reported to Orchil. 2. This drawing is copyright and may not be reproduced or used for any purpose other than that intended without the prior written agreement from Orchil Architectural Consultants.

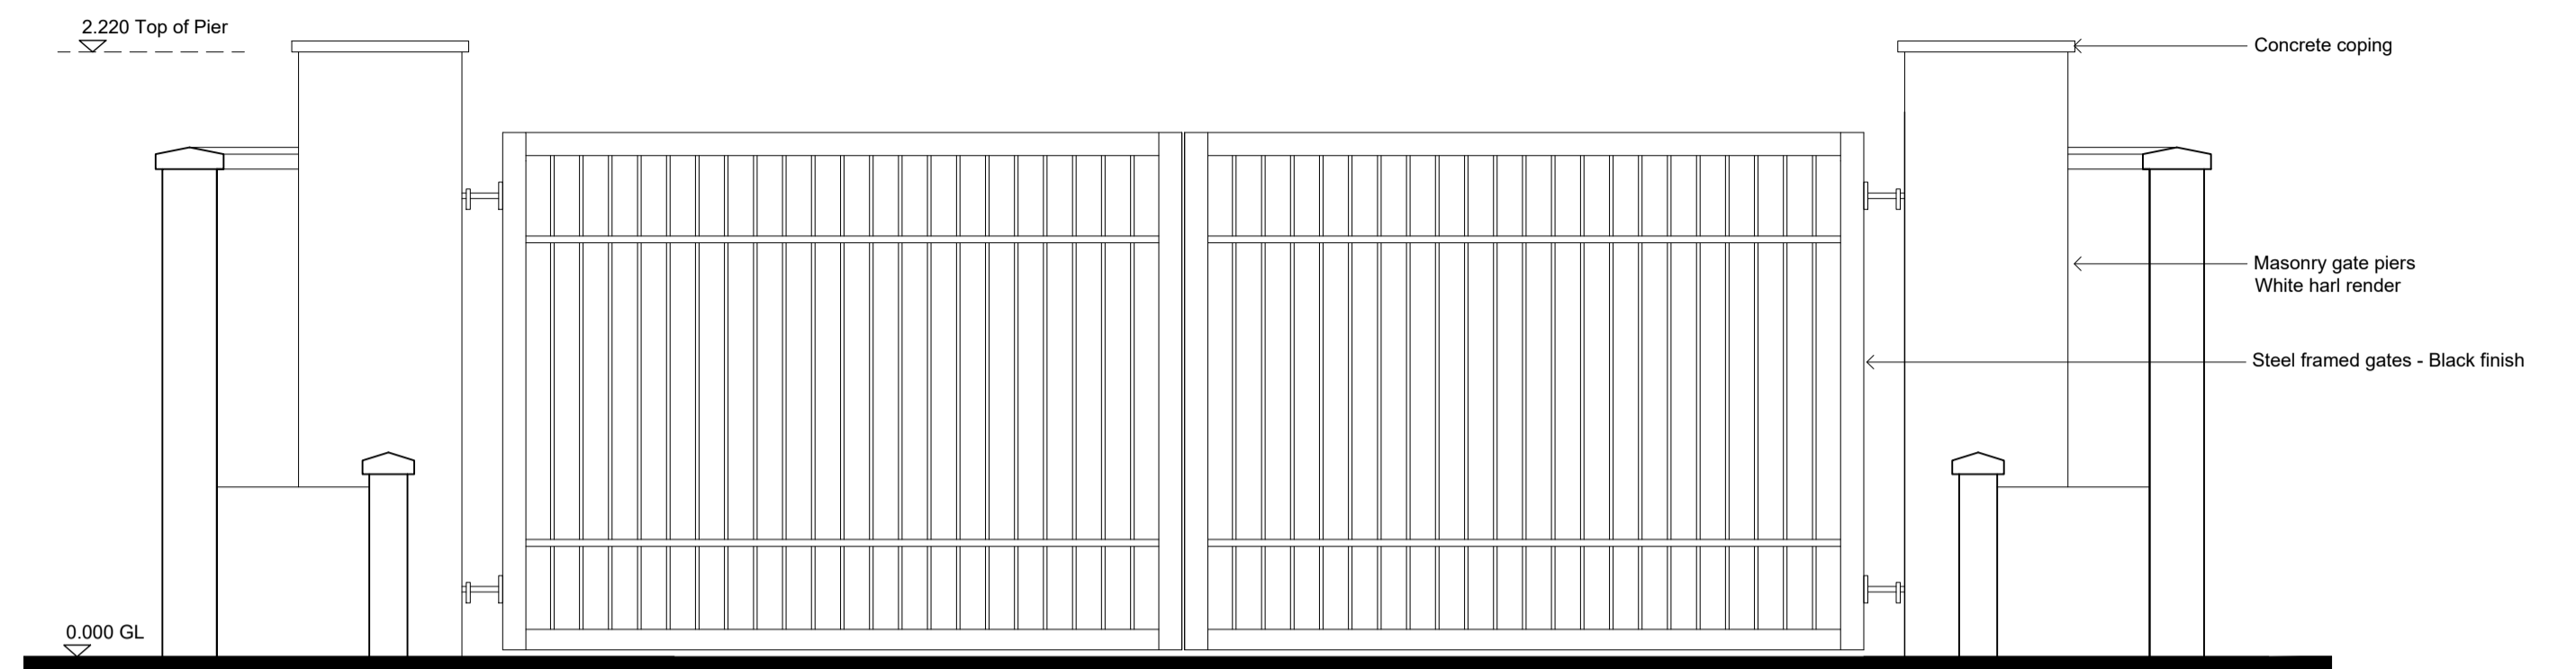


Proposed Gate Entrance Plan 1:100 Scale

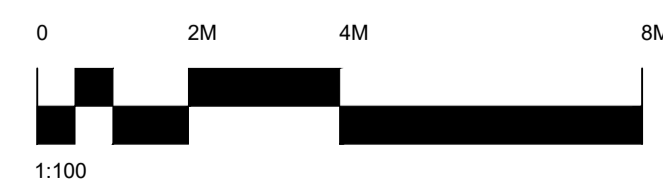

Elevation of Gates 1:25 Scale


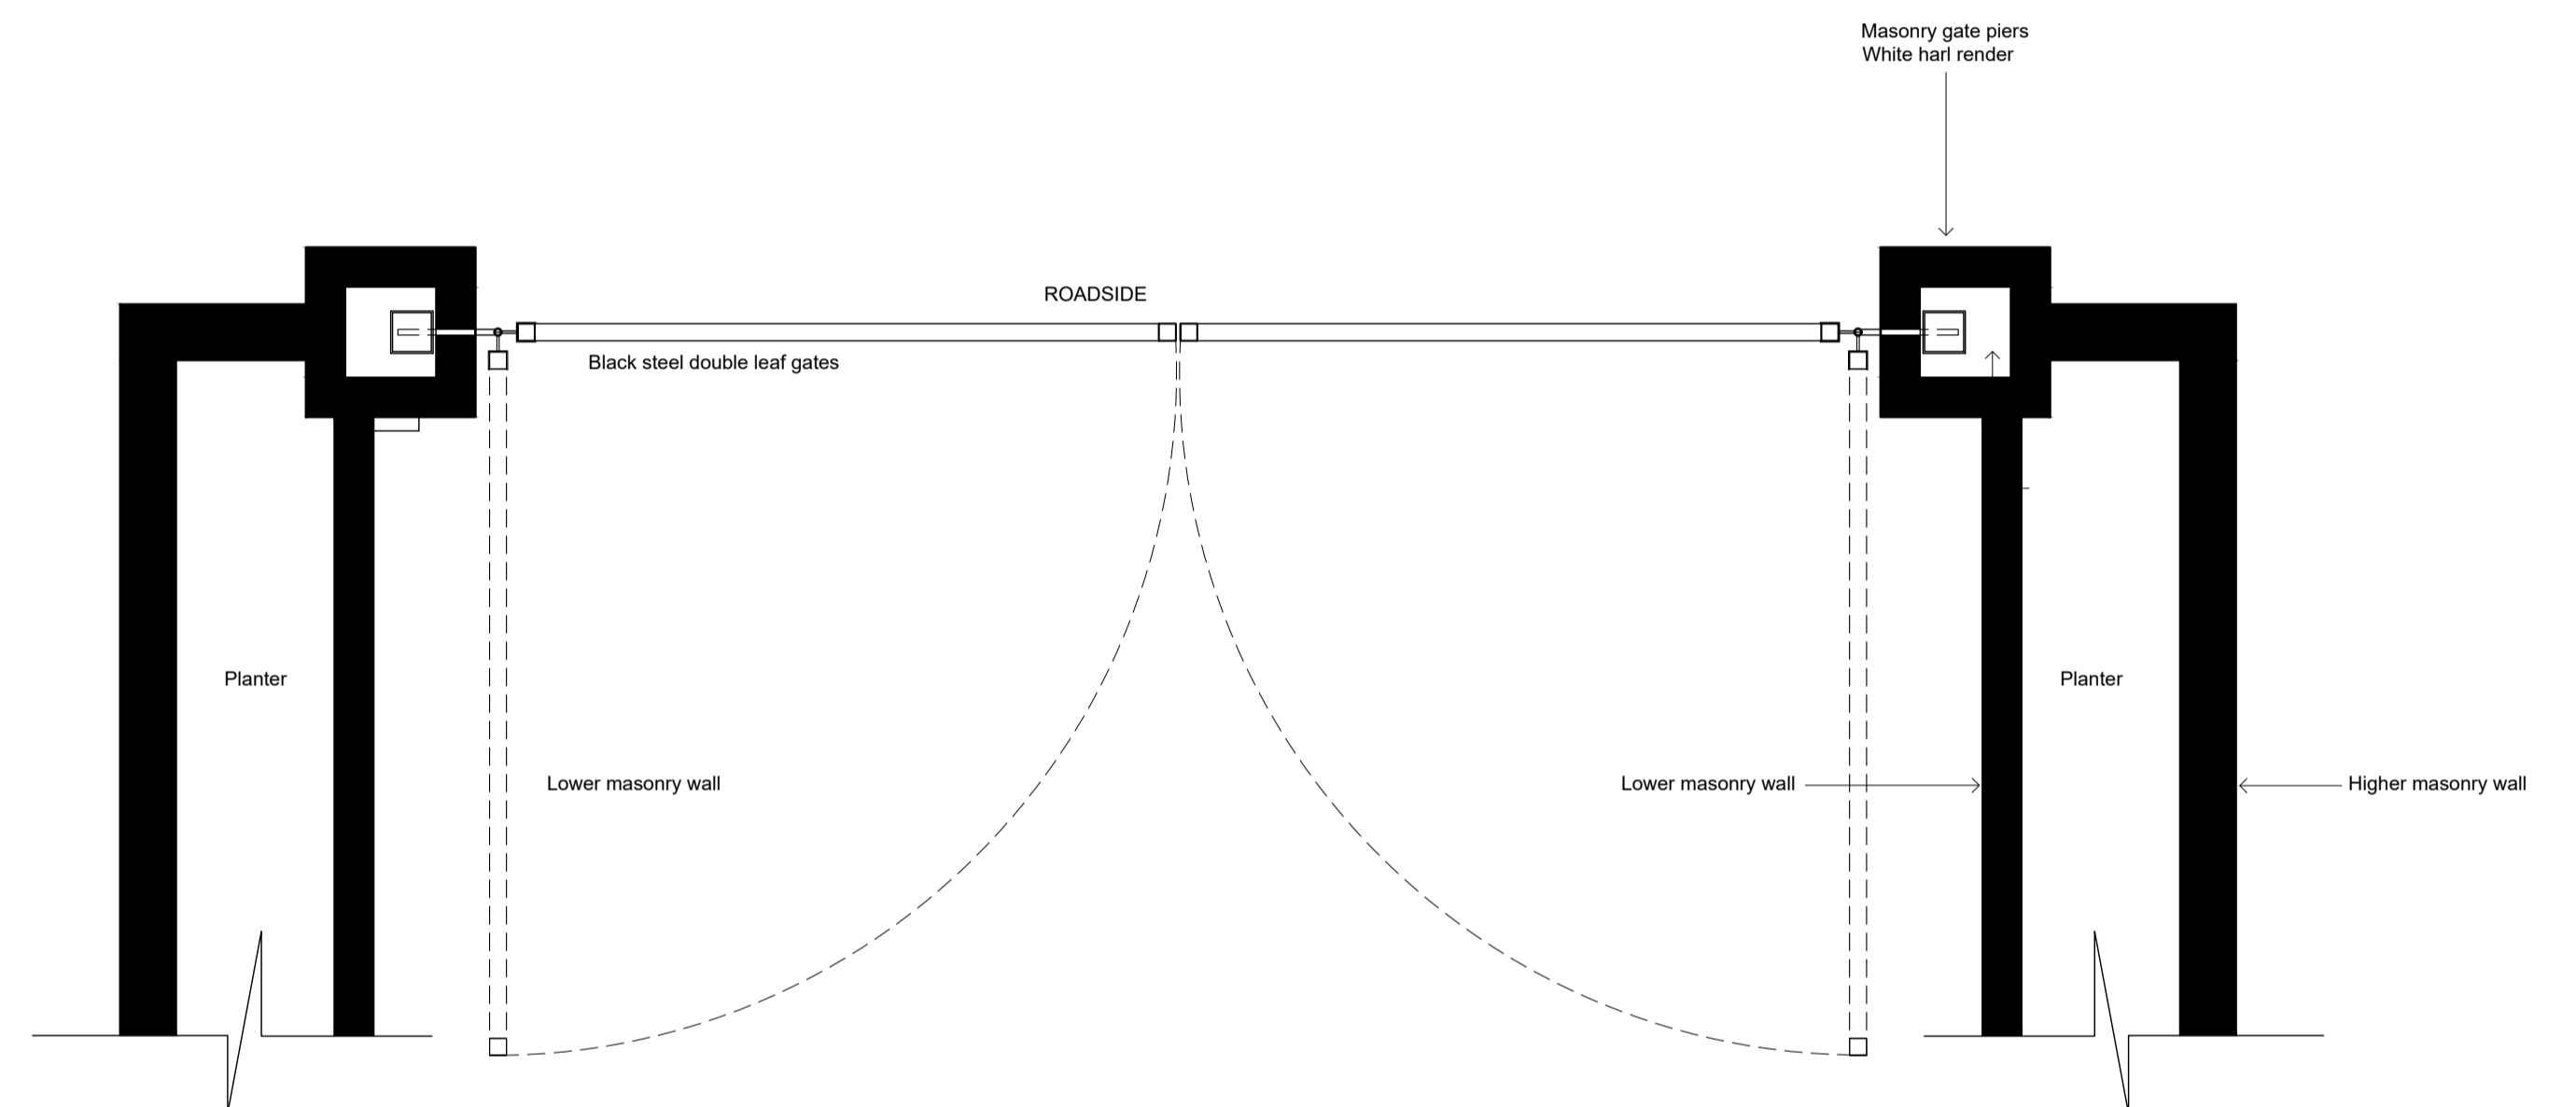


Plan of Gates 1:25 Scale

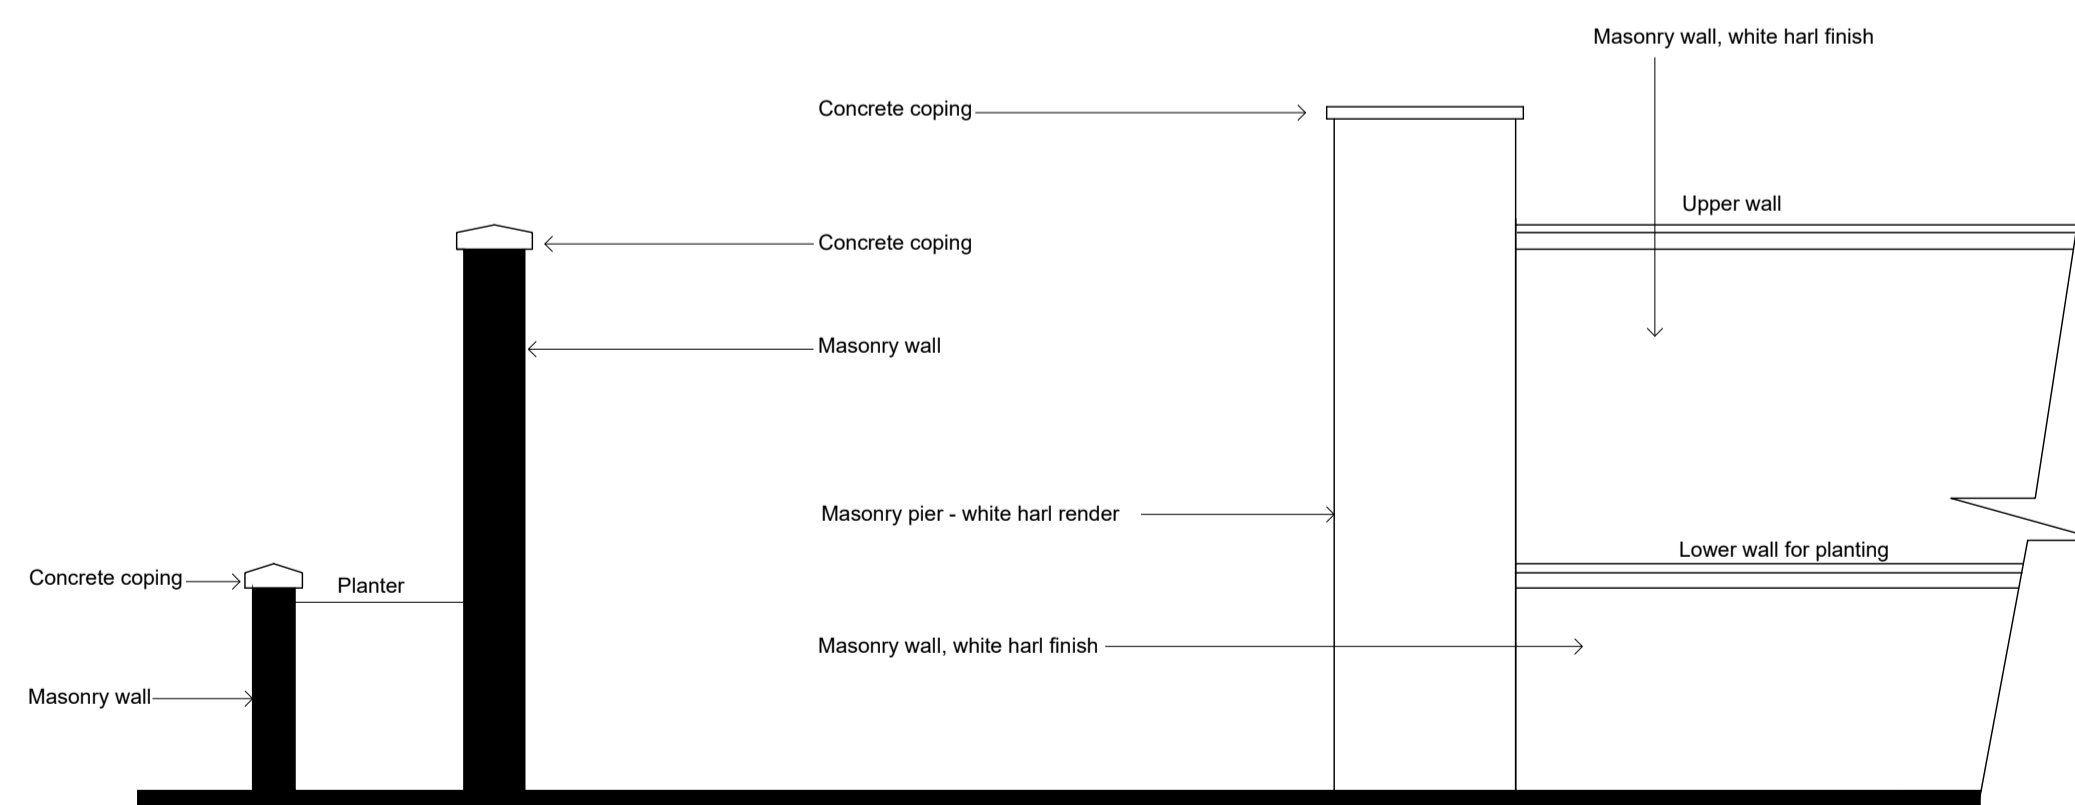

Section of Walls 1:25 Scale

Elevation of Walls 1:25 Scale

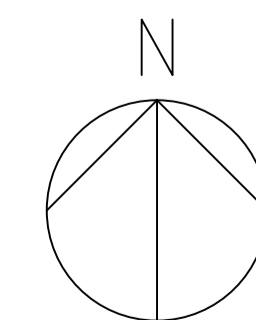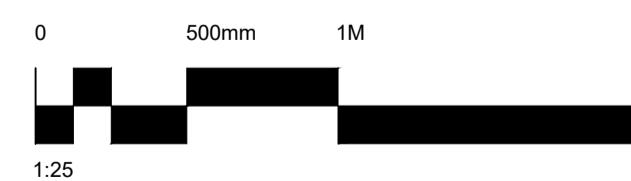

B	11.12.20	As Built walls & gates	JH	BH
A	13.11.17	Amendment to walls	JH	BH
Rev	Date	Description	By	Chk

**Orchil**  
Architectural Consultants  
The Barn, Mains of Orchil  
Killicrankie  
Pitlochry  
Perthshire  
PH16 5LR  
t: 01796 470082  
e: mail@orchilarch.co.uk  
w: www.orchilarch.co.uk

Client:  
Signatory Vintage Scotch Whisky Co. Ltd.  
Edradour Distillery, Pitlochry, PH16 5JP

Project:  
New Gate Entrance & Walls

Drawing title:  
Proposed Plans & Elevations

Scale(s): see drg	Size: A1	First issue: 09/11/17	Drawn: JH	Checked: BH
----------------------	-------------	--------------------------	--------------	----------------

Job no: 245	Drawing no: 02	Rev: B
----------------	-------------------	-----------