


39, Crabwood Road, Southampton, City Of Southampton, SO16 9FD

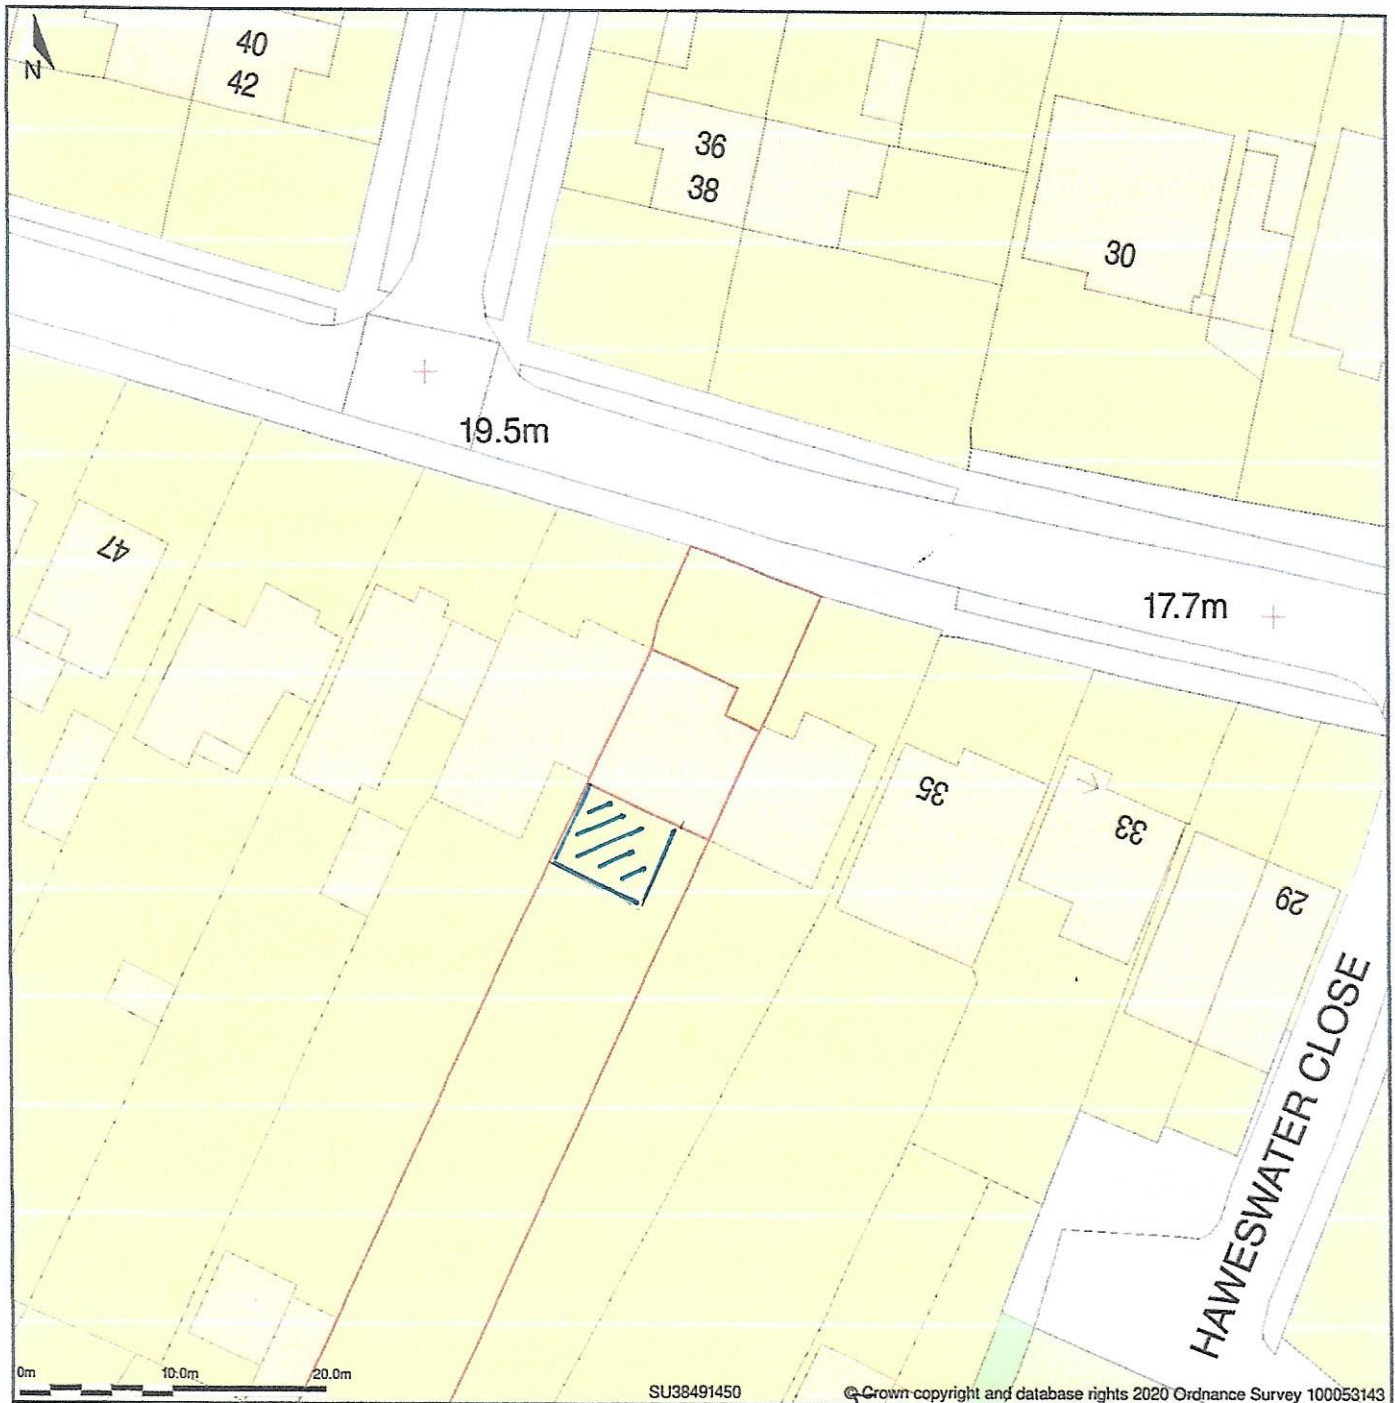


Block Plan shows area bounded by: 438446.95, 114458.03 438536.95, 114548.03 (at a scale of 1:500), OSGridRef: SU38491450. The representation of a road, track or path is no evidence of a right of way. The representation of features as lines is no evidence of a property boundary.

Produced on 11th Nov 2020 from the Ordnance Survey National Geographic Database and incorporating surveyed revision available at this date. Reproduction in whole or part is prohibited without the prior permission of Ordnance Survey. © Crown copyright 2020. Supplied by www.buyaplan.co.uk a licensed Ordnance Survey partner (100053143). Unique plan reference: #00574413-531B14

Ordnance Survey and the OS Symbol are registered trademarks of Ordnance Survey, the national mapping agency of Great Britain. Buy A Plan logo, pdf design and the www.buyaplan.co.uk website are Copyright © Pass Inc Ltd 2020

REVISED PLAN SHOWING PROPOSED EXTENSION REDUCED
TO THE WIDTH OF THE MAIN HOUSE 6M DEPTH 6.8M WIDE
HATCHED IN BLUE 20-11-20

39, Crabwood Road, Southampton, City Of Southampton, SO16 9FD

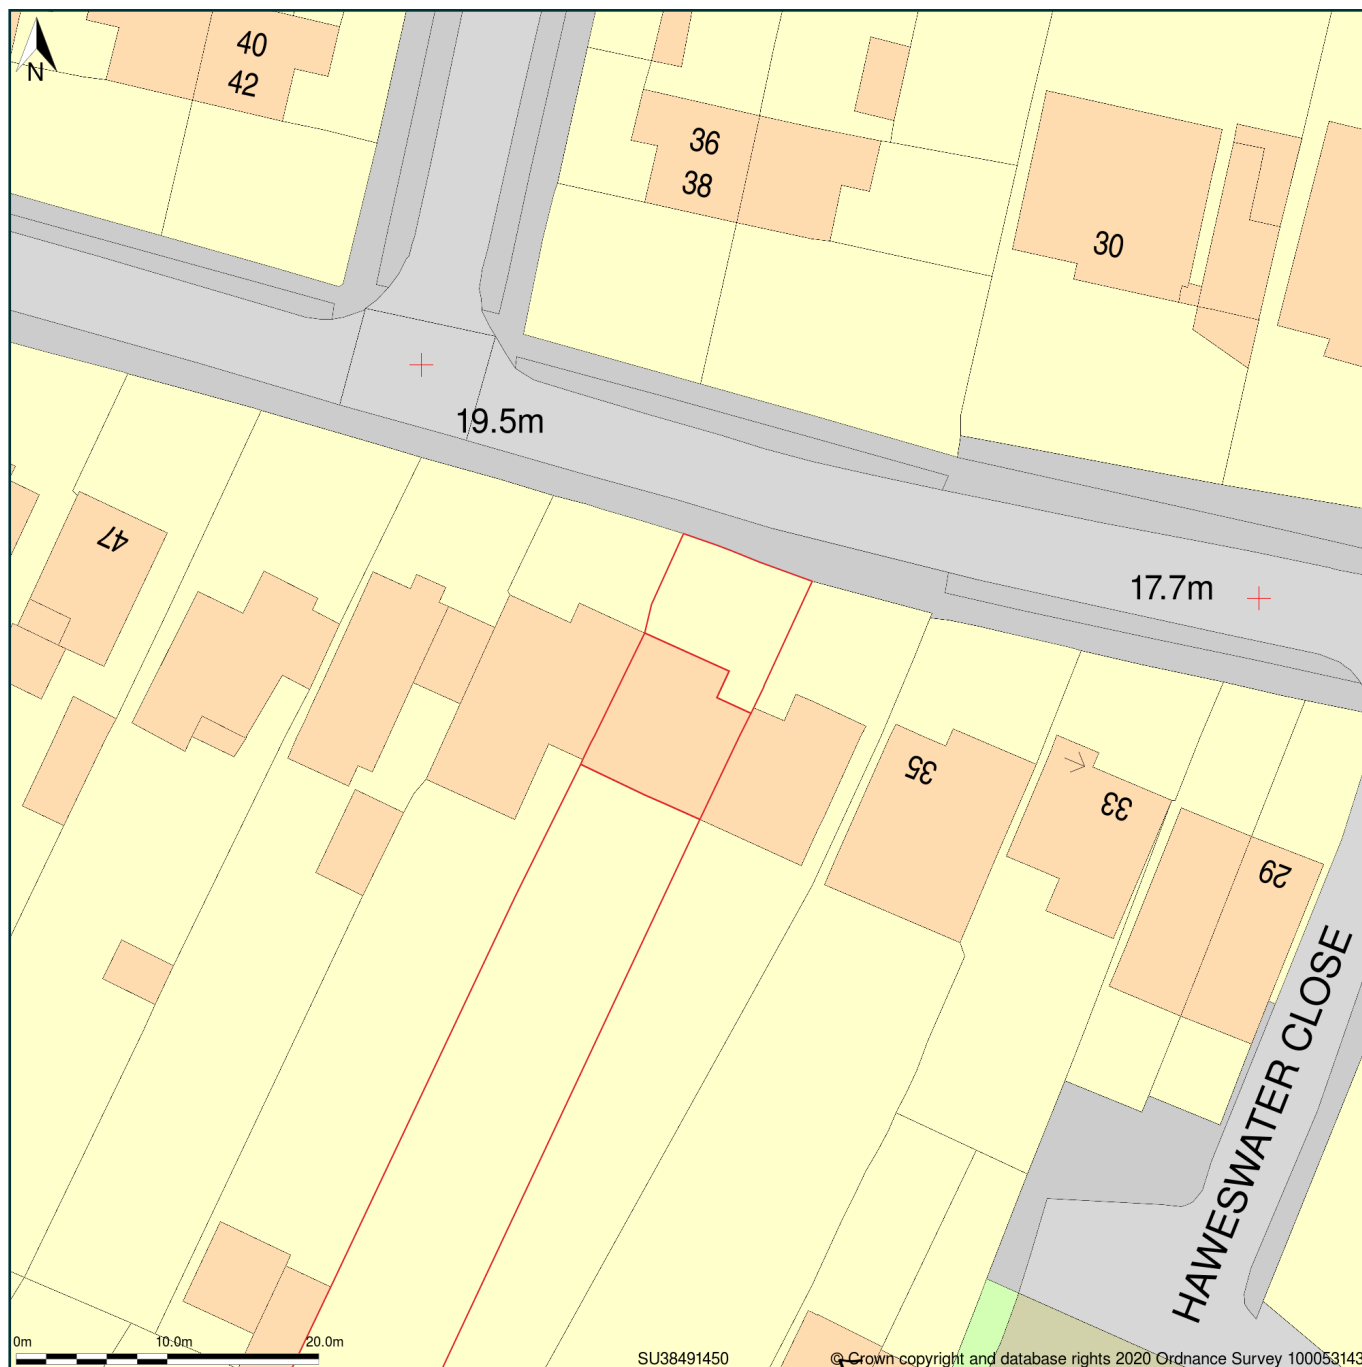


Block Plan shows area bounded by: 438446.95, 114458.03 438536.95, 114548.03 (at a scale of 1:500), OSGridRef: SU38491450. The representation of a road, track or path is no evidence of a right of way. The representation of features as lines is no evidence of a property boundary.

Produced on 11th Nov 2020 from the Ordnance Survey National Geographic Database and incorporating surveyed revision available at this date. Reproduction in whole or part is prohibited without the prior permission of Ordnance Survey. © Crown copyright 2020. Supplied by www.buyaplan.co.uk a licensed Ordnance Survey partner (100053143). Unique plan reference: #00574413-531B14

Ordnance Survey and the OS Symbol are registered trademarks of Ordnance Survey, the national mapping agency of Great Britain. Buy A Plan logo, pdf design and the www.buyaplan.co.uk website are Copyright © Pass Inc Ltd 2020

39, Crabwood Road, Southampton, City Of Southampton, SO16 9FD

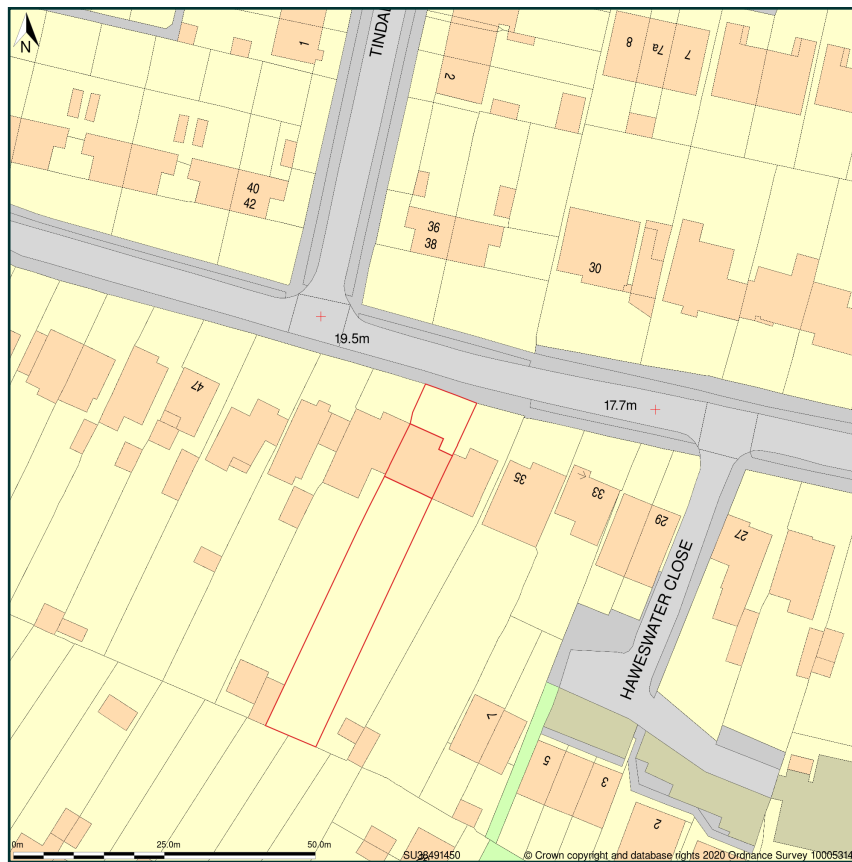

Site Plan shows area bounded by: 438422.56, 114434.15 438563.99, 114575.57 (at a scale of 1:1250), OSGridRef: SU38491450. The representation of a road, track or path is no evidence of a right of way. The representation of features as lines is no evidence of a property boundary.

Produced on 11th Nov 2020 from the Ordnance Survey National Geographic Database and incorporating surveyed revision available at this date. Reproduction in whole or part is prohibited without the prior permission of Ordnance Survey. © Crown copyright 2020. Supplied by www.buyaplan.co.uk a licensed Ordnance Survey partner (100053143). Unique plan reference: #00574414-CEE122


Ordnance Survey and the OS Symbol are registered trademarks of Ordnance Survey, the national mapping agency of Great Britain. Buy A Plan logo, pdf design and the www.buyaplan.co.uk website are Copyright © Pass Inc Ltd 2020

NOTES

1. THIS DRAWING SHOULD NOT BE SCALED.
2. ALL DIMENSIONS ARE IN MILLIMETRES AND LEVELS IN METRES


*Proposed
Revised Width*

Proposed cavity wall construction:-
Internal leaf 3.6N/mm² blockwork,
50mm insulation, 50mm air gap,
external leaf 3.6N/mm² blockwork
with rendered finish

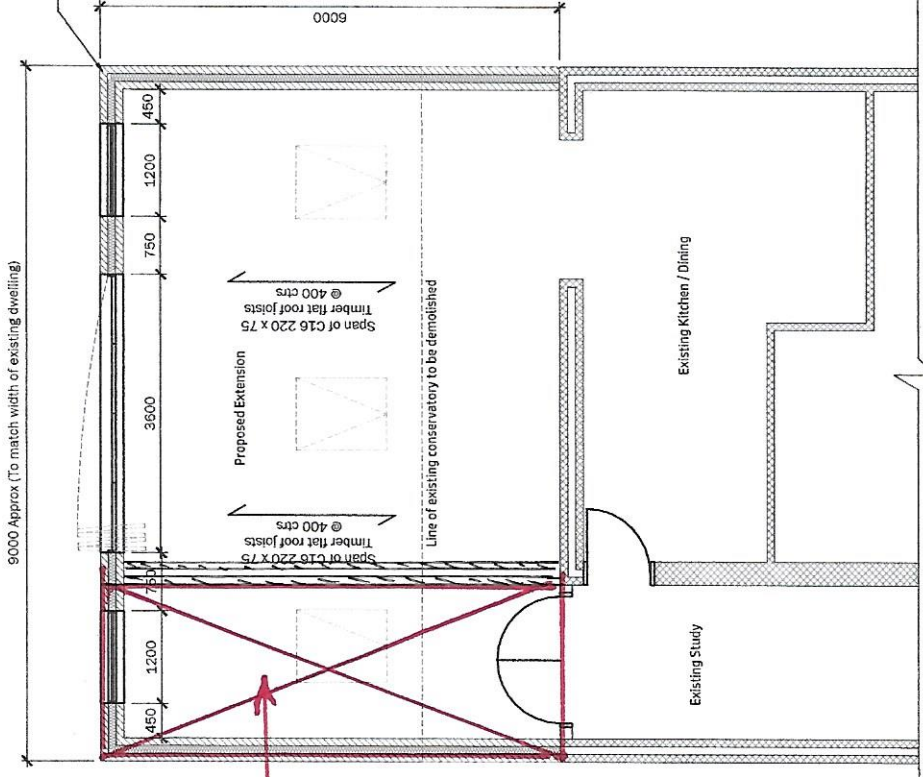

Proposed Ground Floor Layout
Scale 1:50


*Proposed Extension Reduced BY 1.3
Shown in Red*

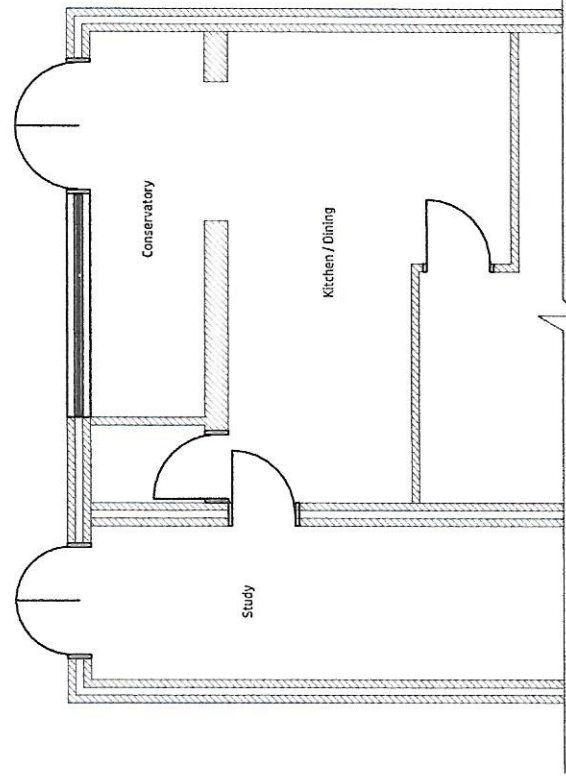

Existing Ground Floor Layout
Scale 1:50

Revised 20.11.20



Client MR & MRS COCKS	Title FLOOR PLANS	Drawing status PLANNING	Date JUN '20	Drawn RAB
		Drawing No. 01	Scale AS SHOWN	Rev. P1
Project 39 CRABWOOD RD EXTENSION				
Rev By P1 RAB	Date 17.06.20	Revisions PLANNING		

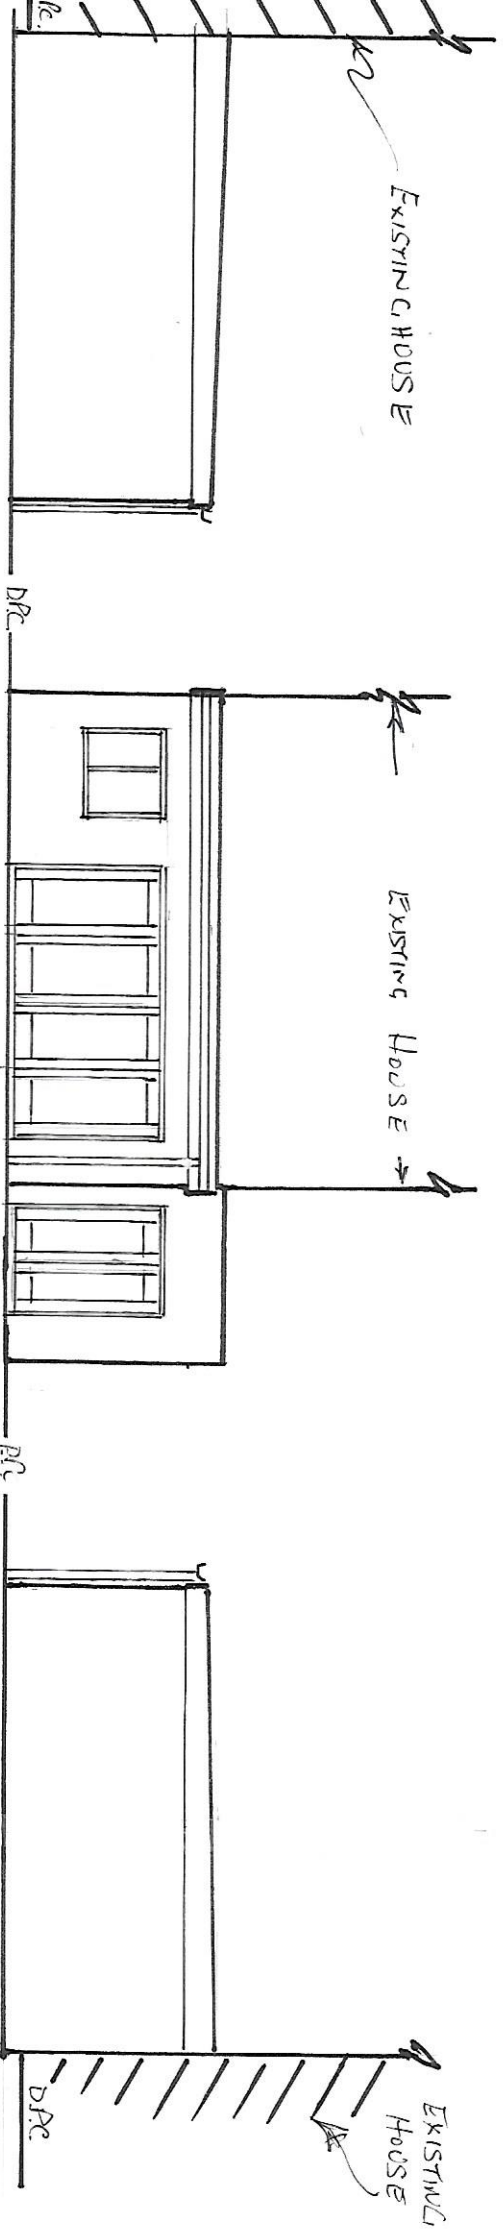

Proposed Side Elevation

Proposed Rear Elevation North

Proposed Side Elevation

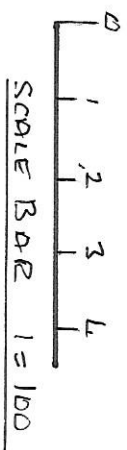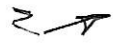

	<p>MR. MAS COLLS</p>	<p>PROPOSED EXTENSION REAR & SIDE ELEVATIONS</p>	<p>DATE 9-12-20 SCALE 1 = 100</p>	
<p>39 CRANWOOD ROAD</p>	<p>REVISED</p>		<p>DRAW NO 03</p>	