


SOUTH Elevation

EAST Elevation


NORTH Elevation

SECTION THRO

Harwood Close
Gosport, Hampshire.

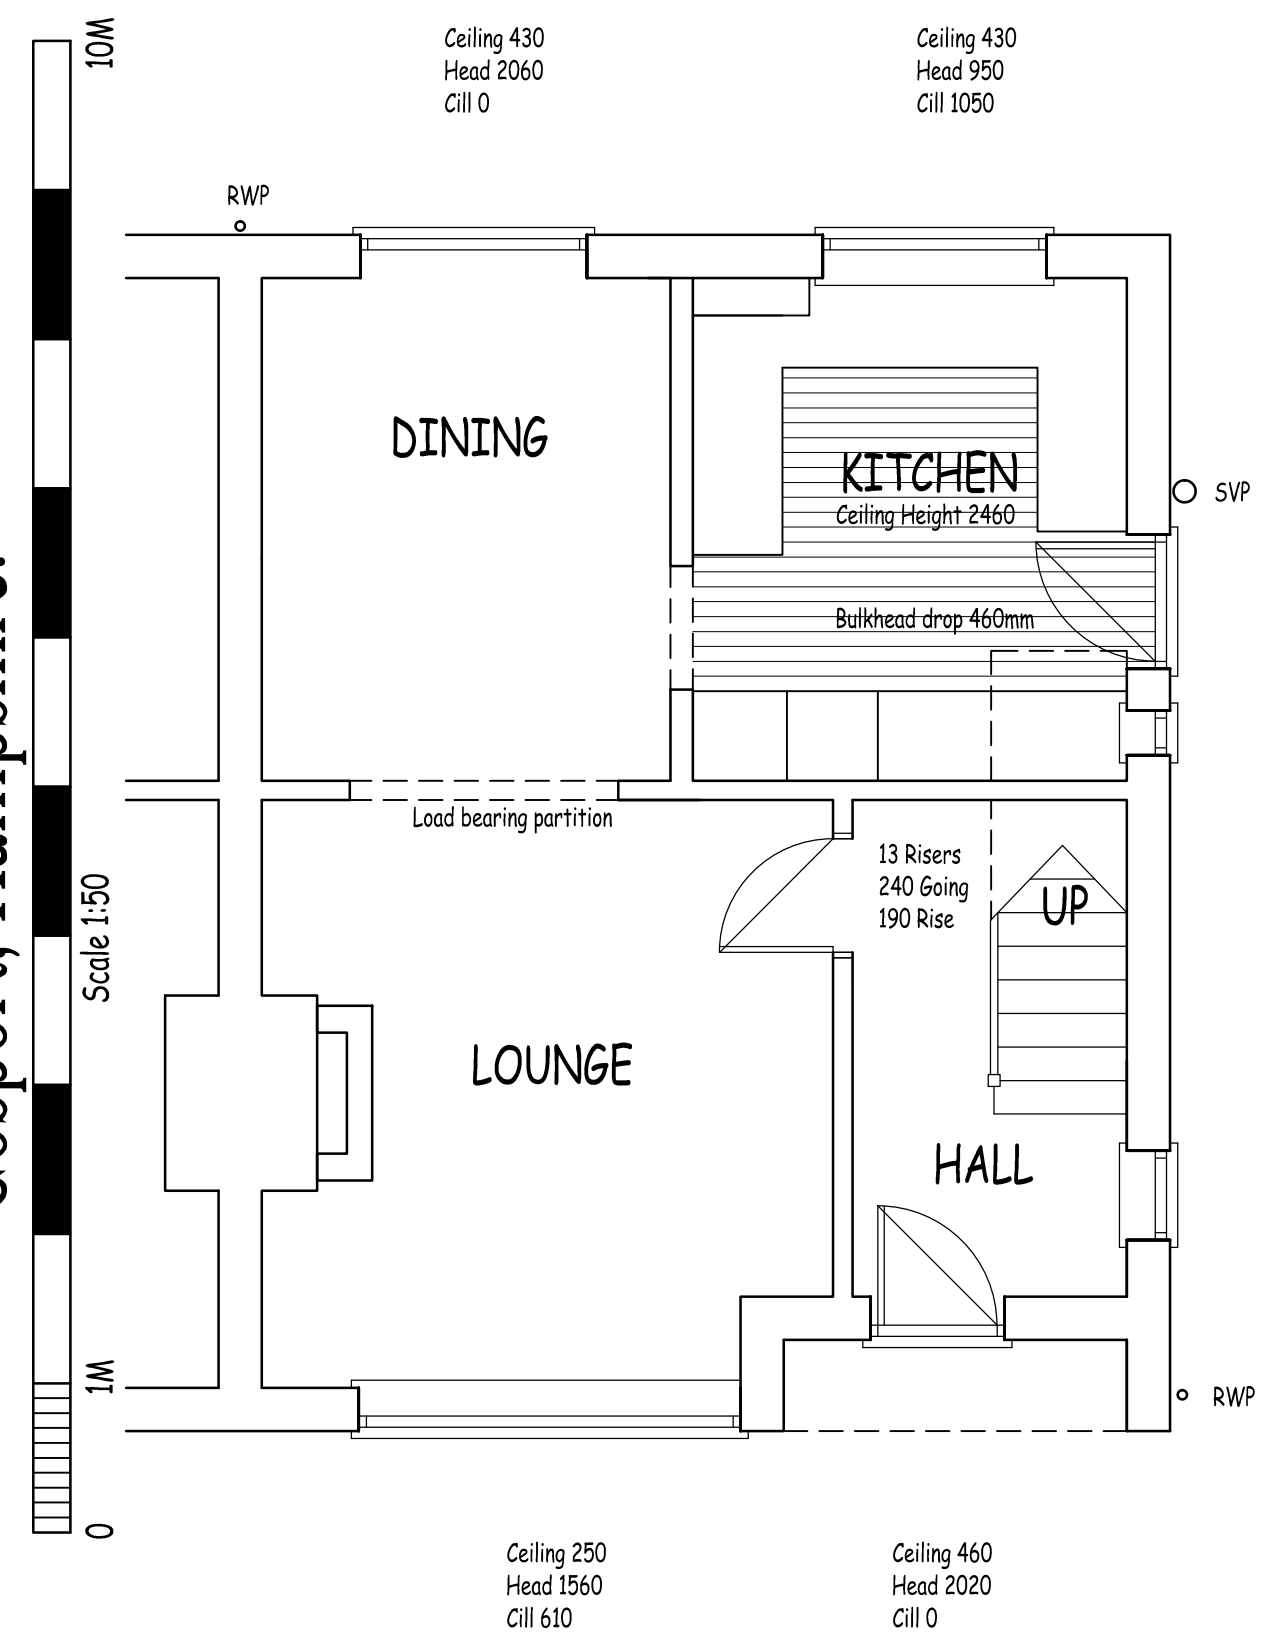

GROUND FLOOR PLAN

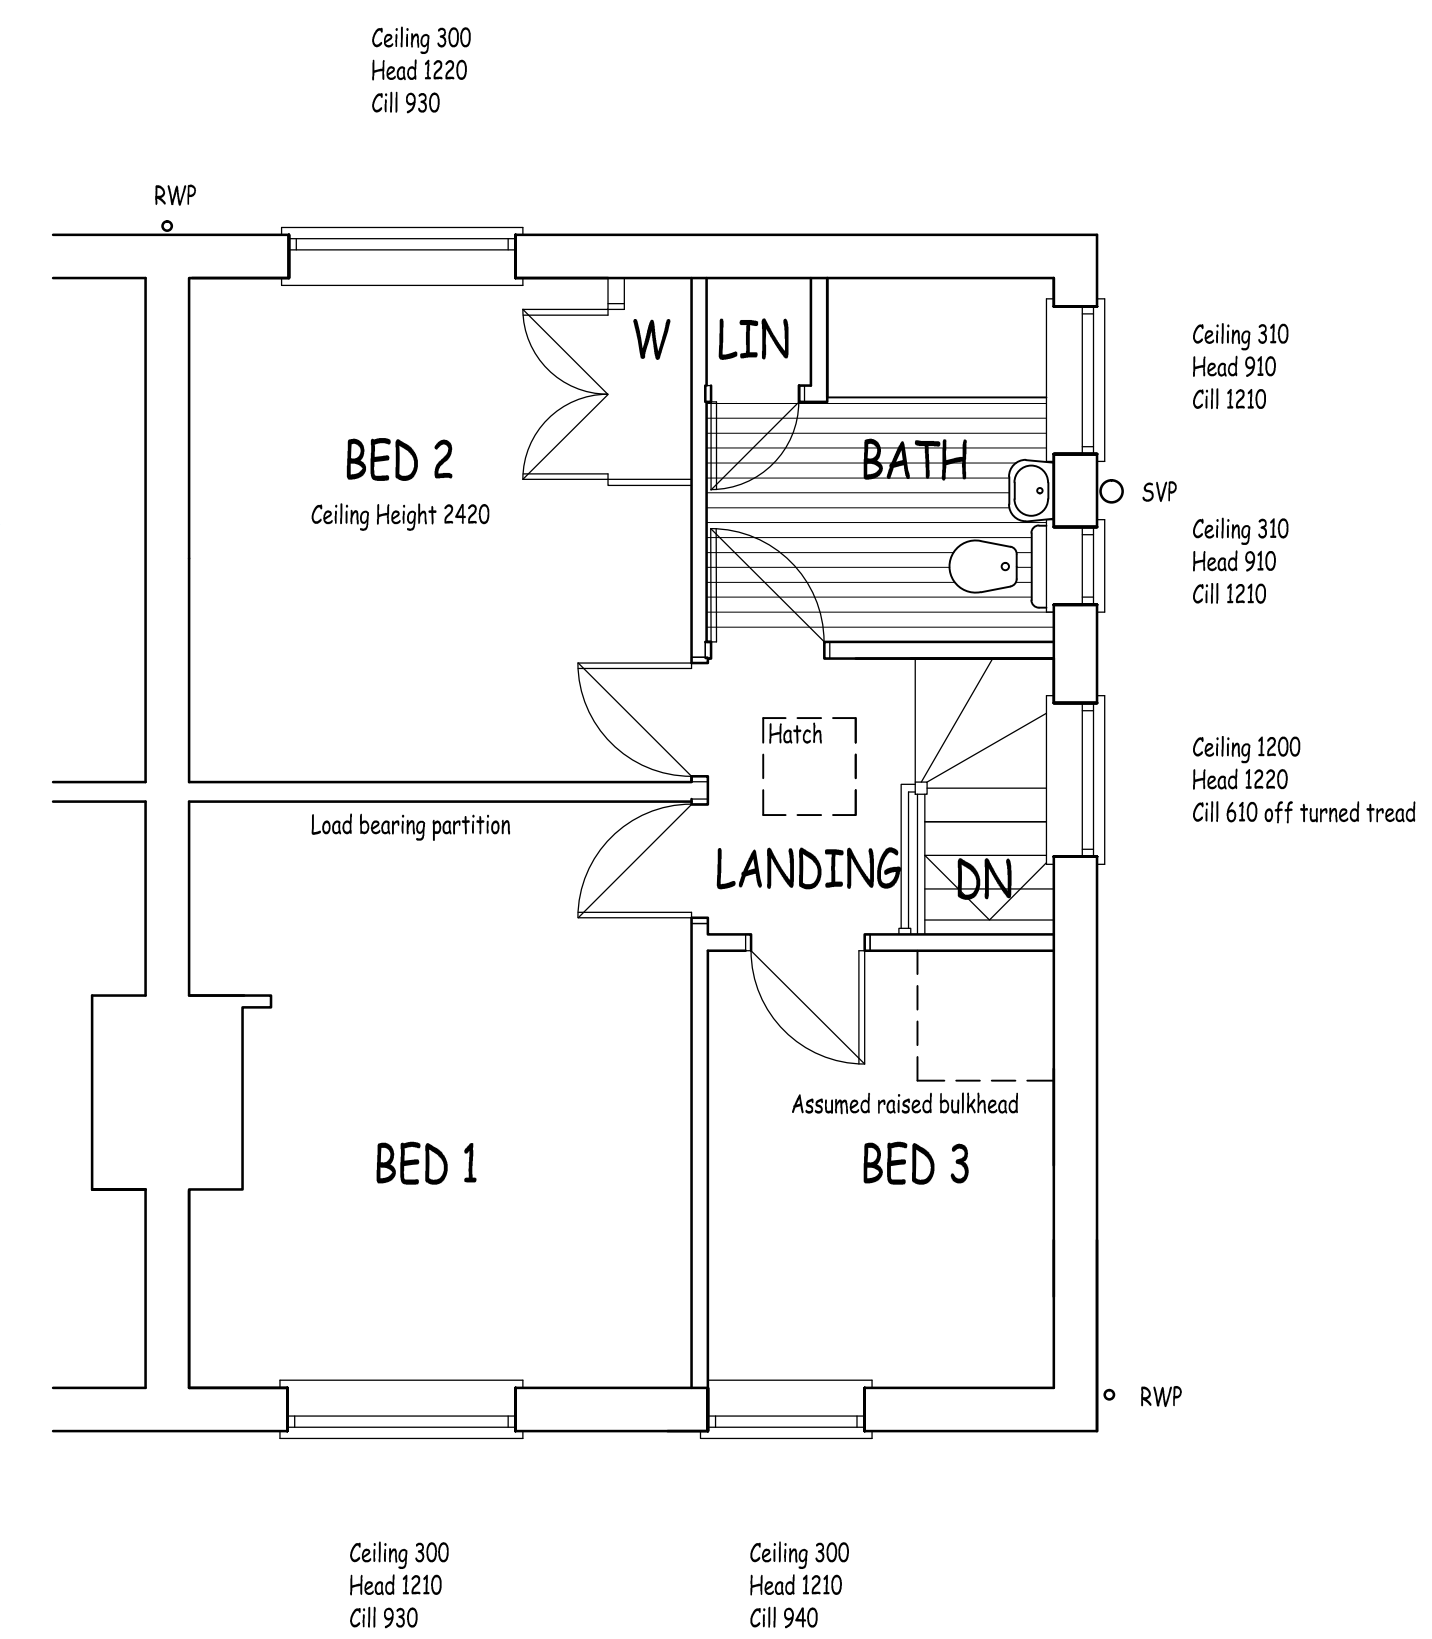

FIRST FLOOR PLAN

* This drawing is protected by copyright and may not be copied or disclosed to third parties without the expressed permission of Town & Country Architecture.
Preference should be given to written figured dimensions over scale measurements.
Discrepancies of any kind must be reported to Town & Country Architecture.

TOWN & COUNTRY ARCHITECTURE
ARCHITECTURAL TECHNOLOGISTS
4 FOGLIOVES THE MEADOWS FAREHAM HAMPSHIRE PO16 8UN
TELEPHONE: (01329) 238482 FACSIMILE: (01329) 238482

PROJECT
AS BUILT PLAN
13 Harwood Close
Gosport
Hampshire

CLIENT
Mr. & Mrs. D. Trivett

SCALE: 1:50 (A1)
DATE: -
DRAWN: P.T.E MCIAT
CHECKED: -
DRWG. NO.: 20/18/01
REVISION: *