


Weatherboard Replacement




EXISTING FRONT ELEVATION



EXISTING REAR ELEVATION

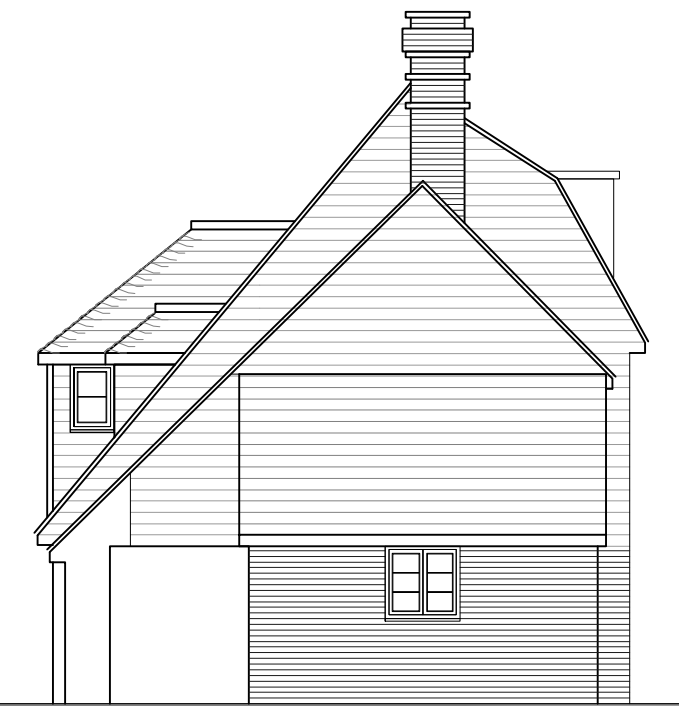

EXISTING SIDE ELEVATION

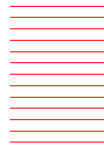 Area marked in red:  
Weatherboarding to be replaced

Existing Elevations  
Scale: 1:100 @ A2  
Drawing No: FC2021 - 4

Forge Cottage  
The Green  
Matfield

Jan 2021