


Scale
0 1 2 3 4 5 6 7 8 9 10 Metres

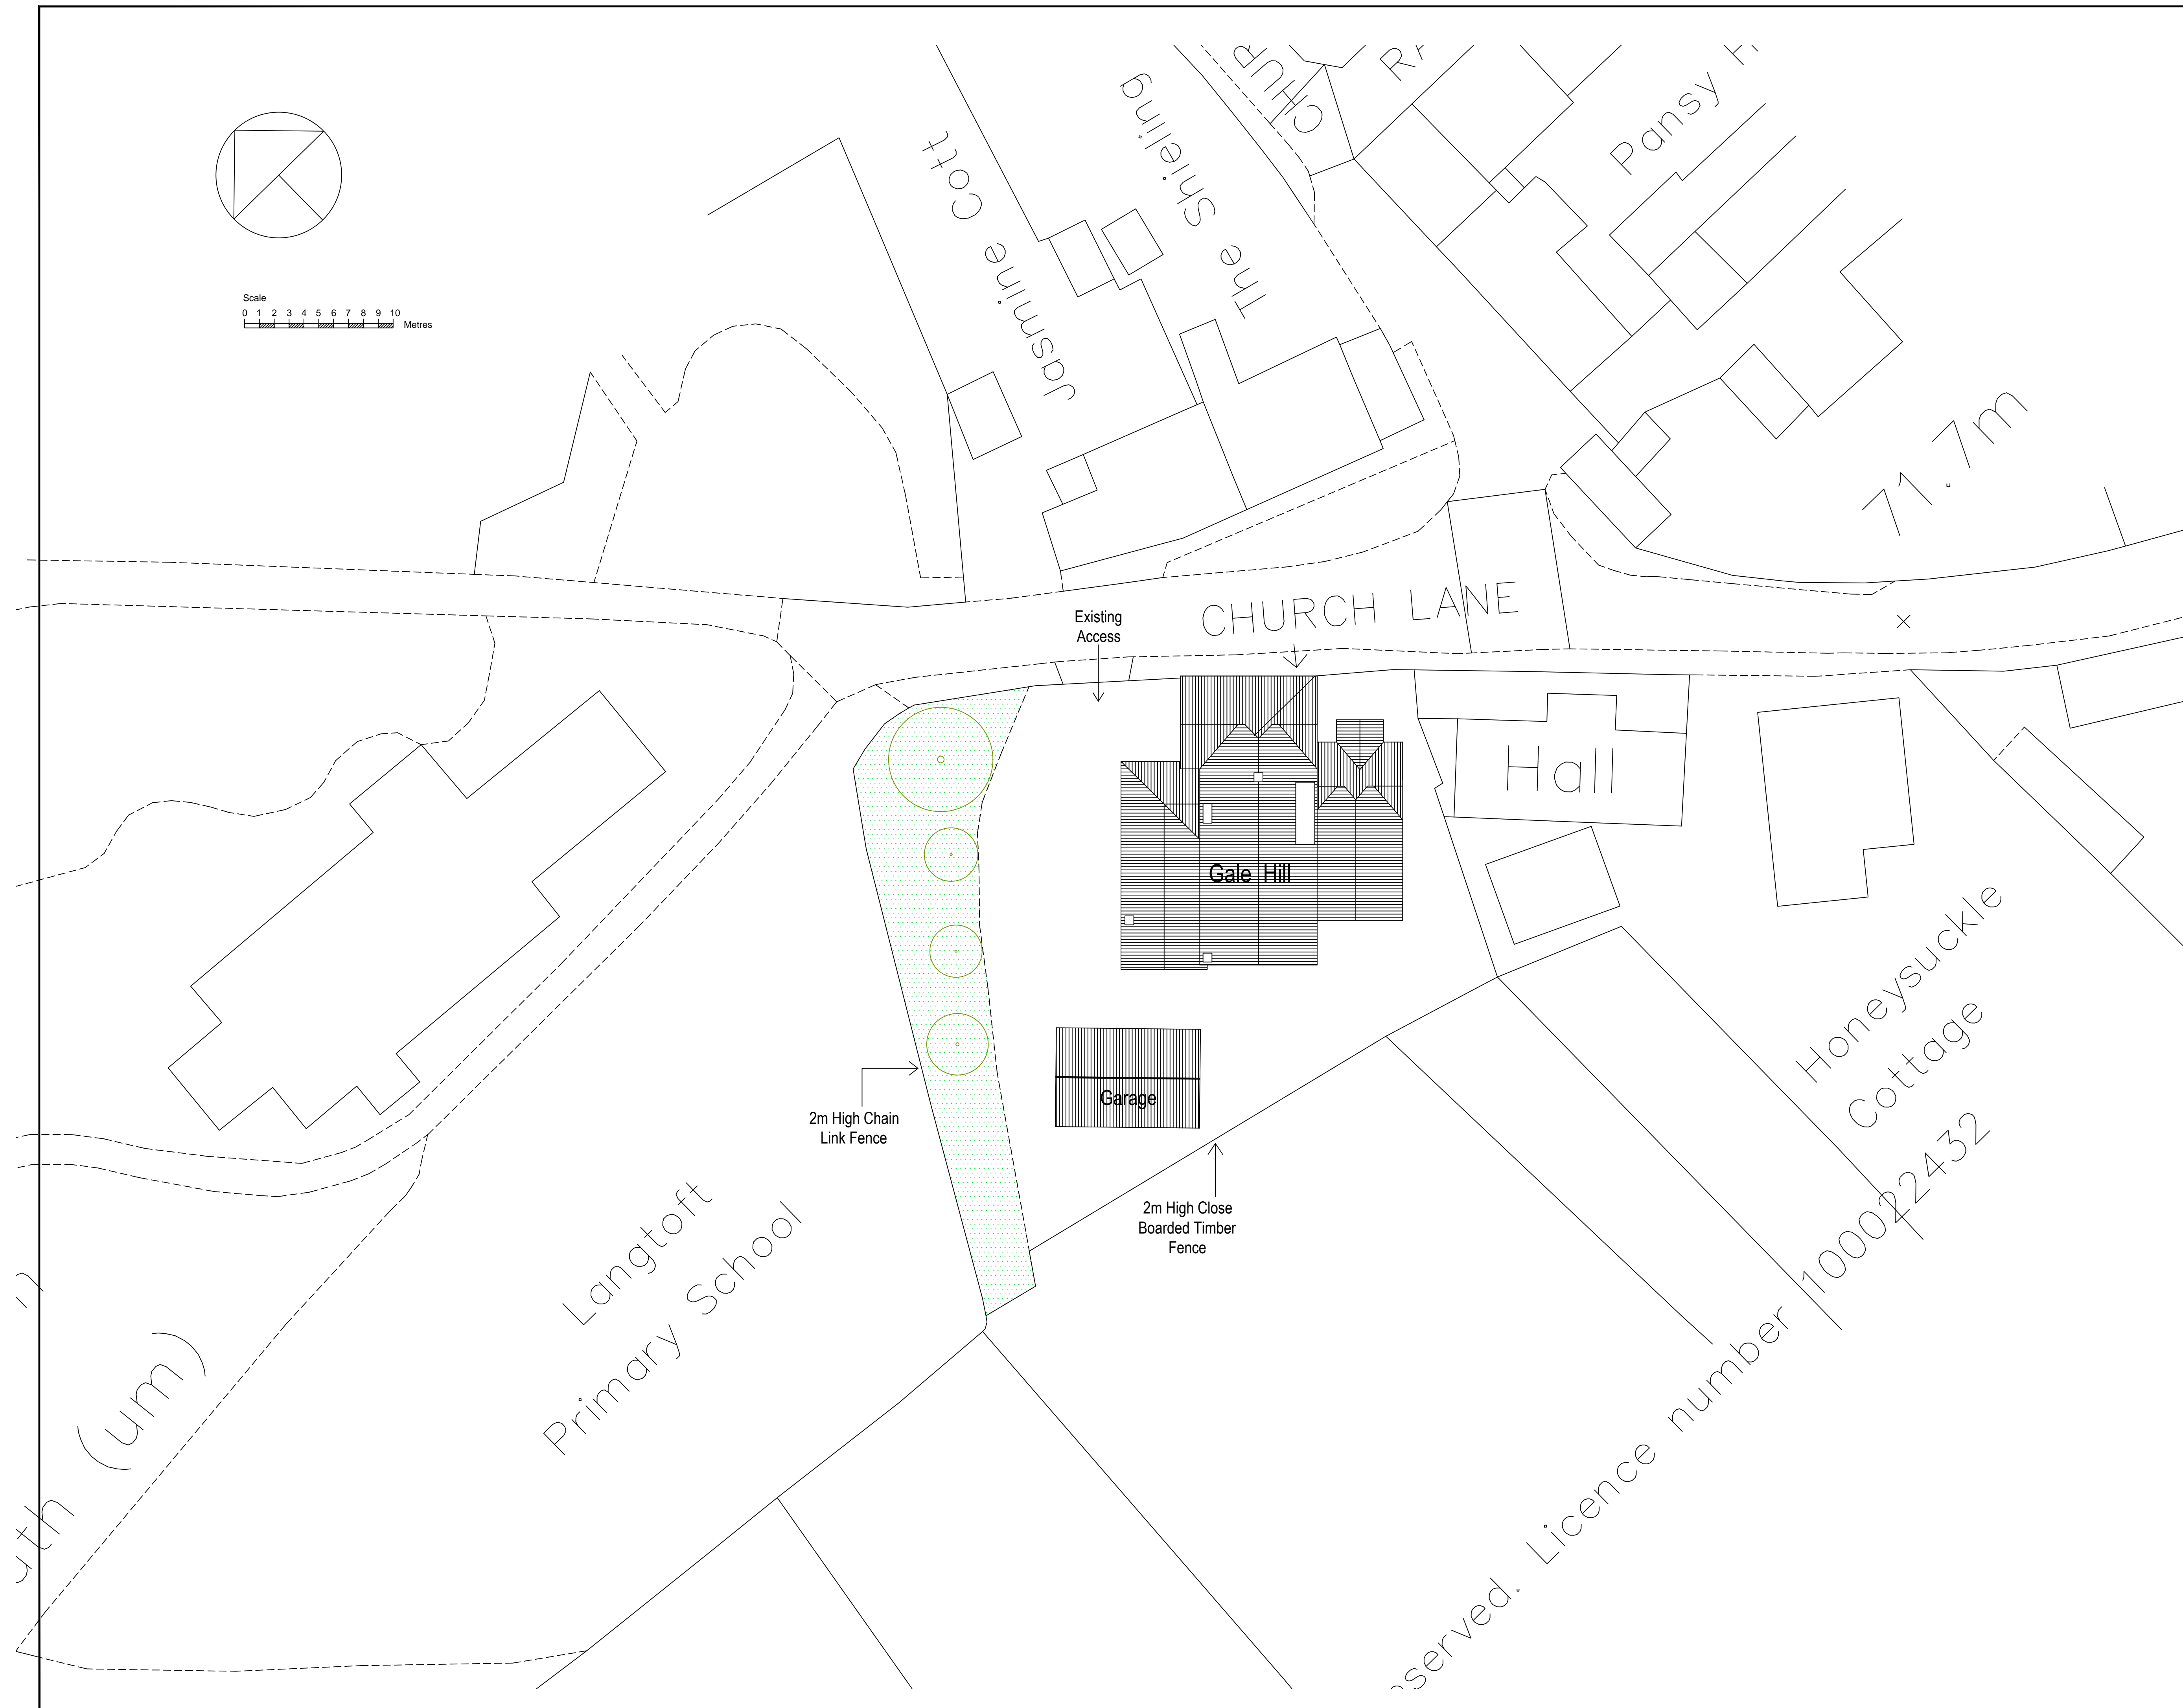

All dimensions must be checked on site and not scaled from this drawing
© copyright

A	Date	Revisions

piercy design

Architects ■ Designers ■ Project Managers ■ Planning Supervisors

Quaker Meeting Rooms
4 Piercy Street, Hull
East Yorkshire
HU2 8HH

Telephone: 01482 326415
Fax: 01482 218001
E-mail: user@piercydesign.co.uk

Client
David Evans

Job Title
**Detached Garage ,
Gale Hill,
Church Lane,
Langtoft
YO25 3TN**

Drawing Title
**Site Layout Plan
'As Built'**

Status
Planning

Date **Feb 2021** Scale **1:200 @ A1**

Drawn **H.P.** Checked Approved

Drg No. **4/201444** Rev. **B**