



DEMOLISHED EXISTING BUILDING AND
 NEWLEY BUILT GARAGE AT TINKER POT LANE
 WEST KINGSDOWN, TN15 6AD Drawing No- TR/02

Scale- 1:100


AS BUILT PLANS AND SECTION

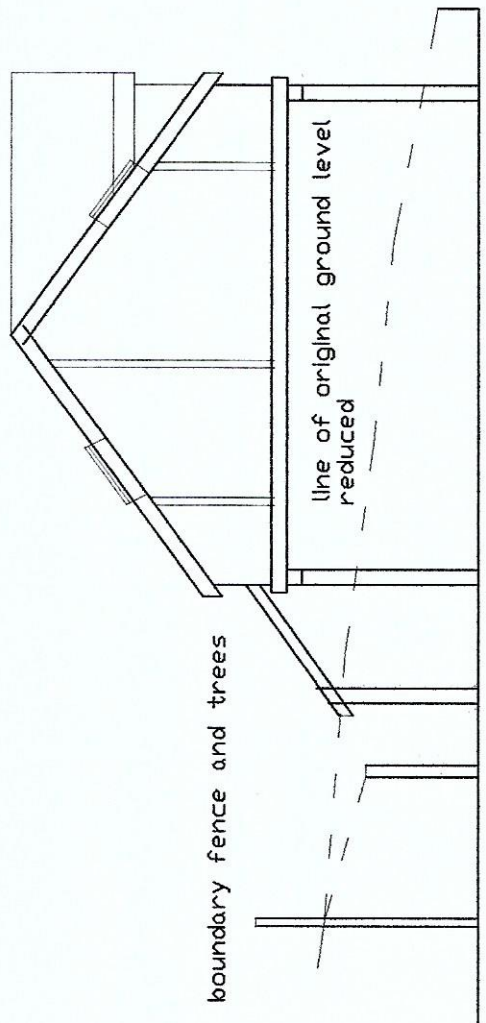

storage of logs
 SECTION
 retaining wall

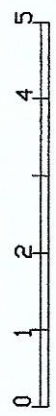


boundary fence and trees

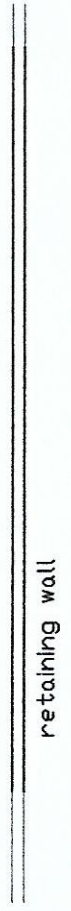


retaining wall



storage of logs

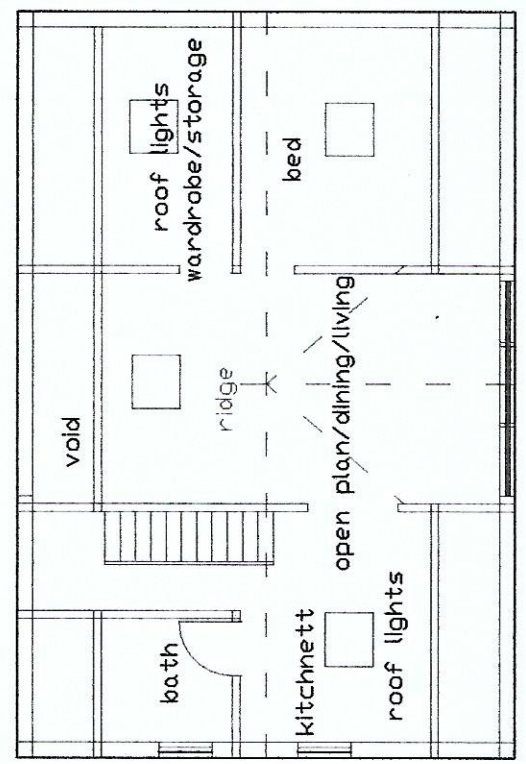

ROOMS AT LOFT SPACE

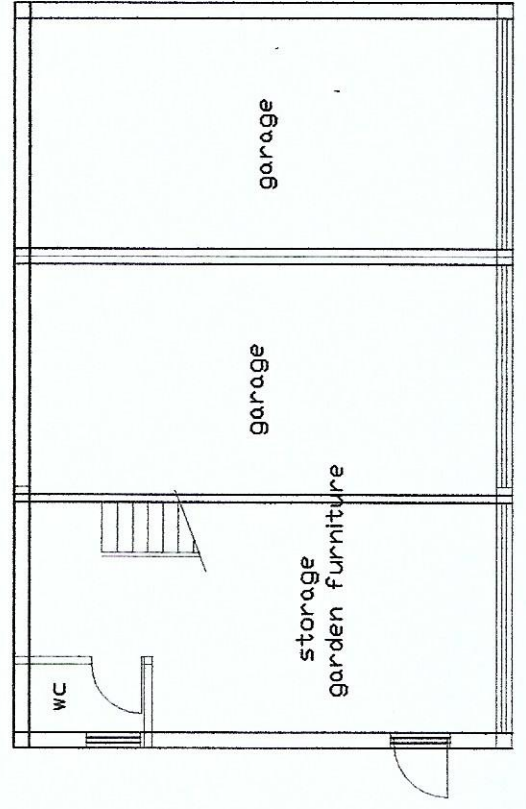

GROUND FLOOR PLAN