


DEMOLISHED EXITING BUILDING AND

NEWLEY BUILT GARAGE AT TINKER POT LANE

WEST KINGSDDOWN, TN15 6AD


Scale - 1:100

AS BUILT ELEVATIONS

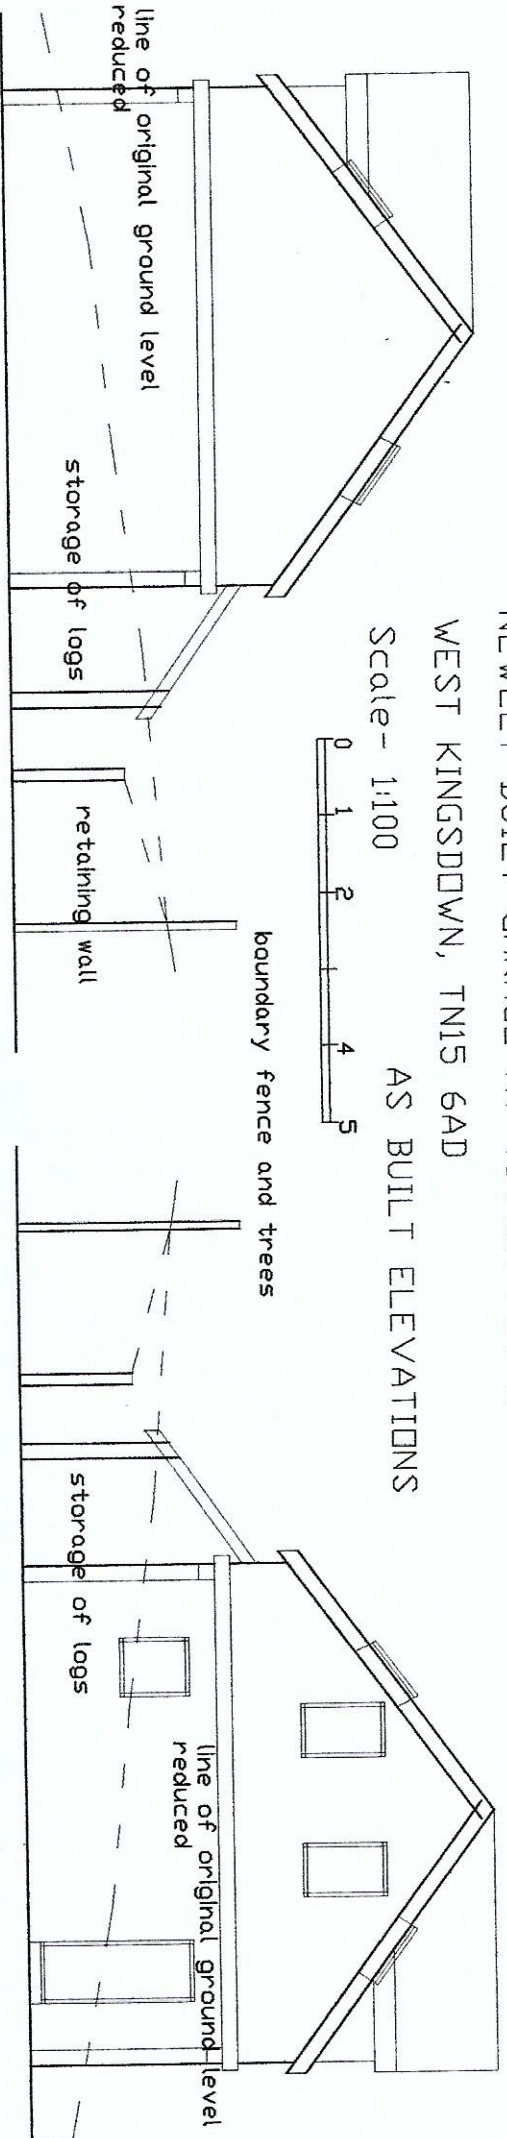

EAST ELEVATION

WEST ELEVATION

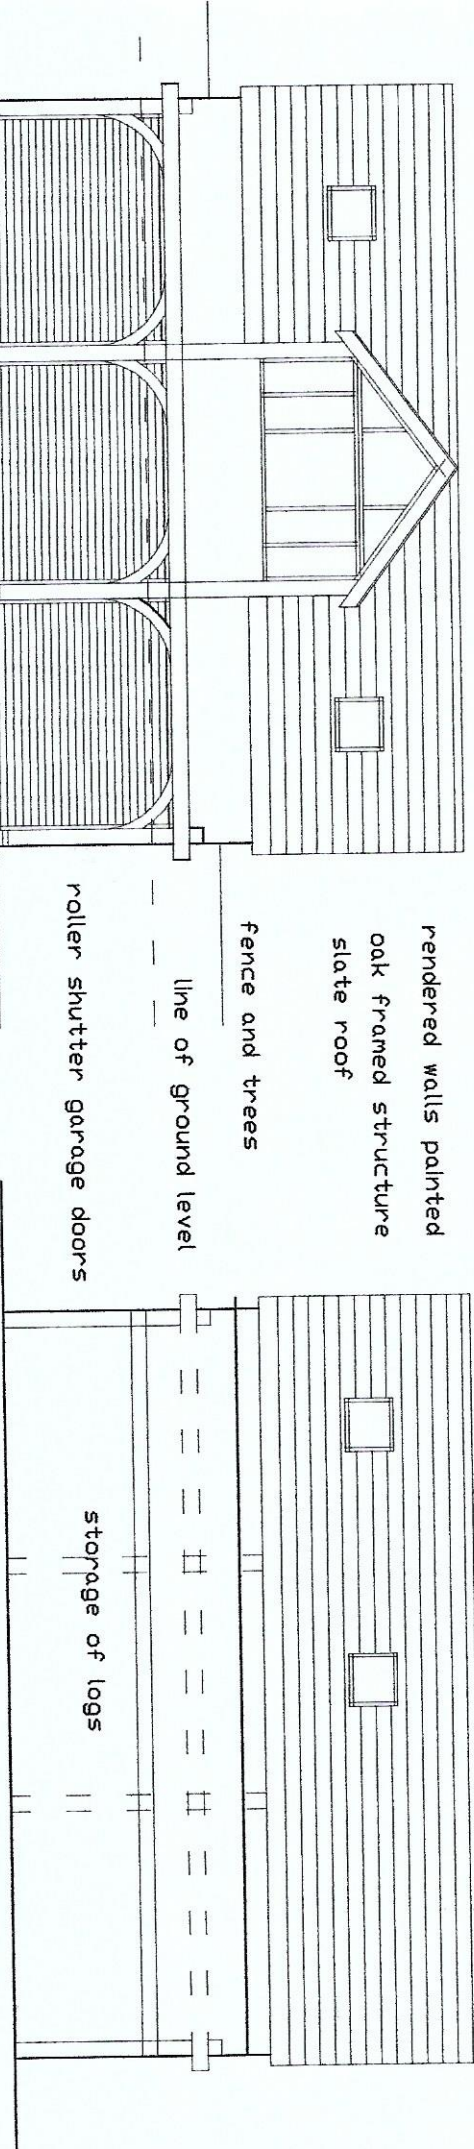

SOUTH ELEVATION FRONT

NORTH ELEVATION REAR

rendered walls painted
oak framed structure
slate roof
fence and trees

line of ground level
roller shutter garage doors

storage of logs