

LOCATION PLAN
SHOWING RED LINE
OF SITE 1:1250 SCALE


Drg No. 012/A

302

302



SITE BLOCK PLAN AT 1:500

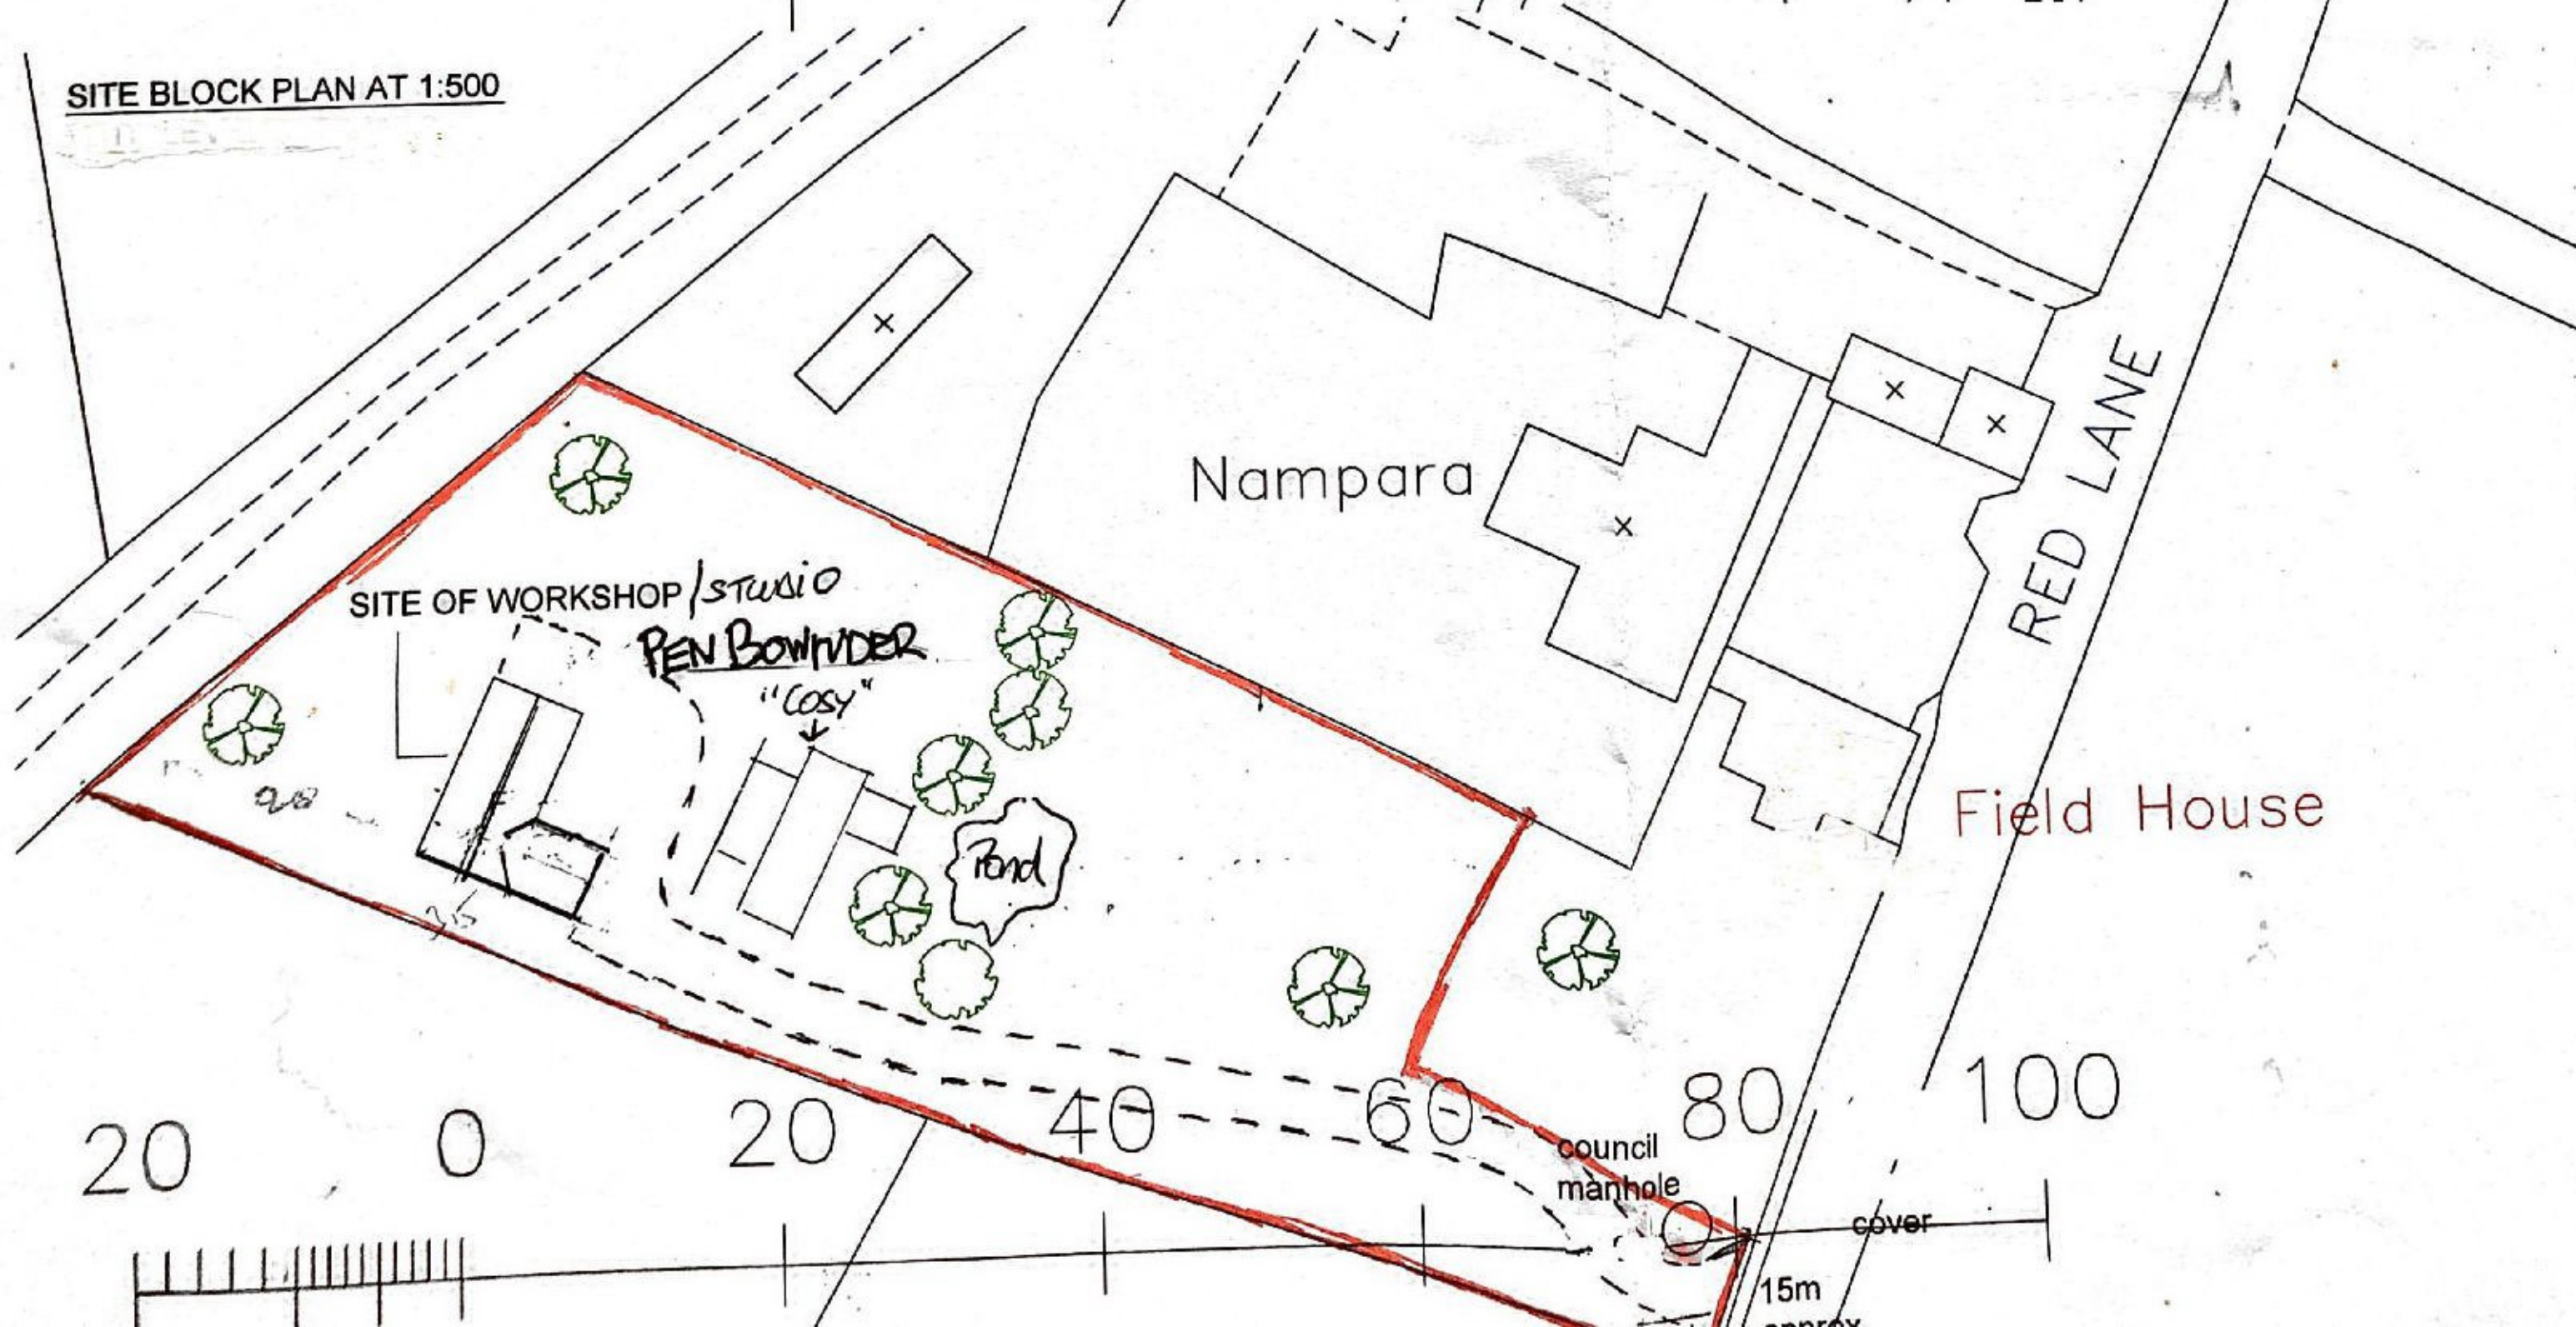

20

0

20

40

60

80

100

council manhole

cover

15m approx