


GENERAL NOTES

THIS DRAWING IS THE COPYRIGHT OF WSD DRAUGHTING AND CANNOT BE PRINTED OR REPRODUCED WITHOUT PRIOR PERMISSION.




AS BUILT REAR ELEVATION

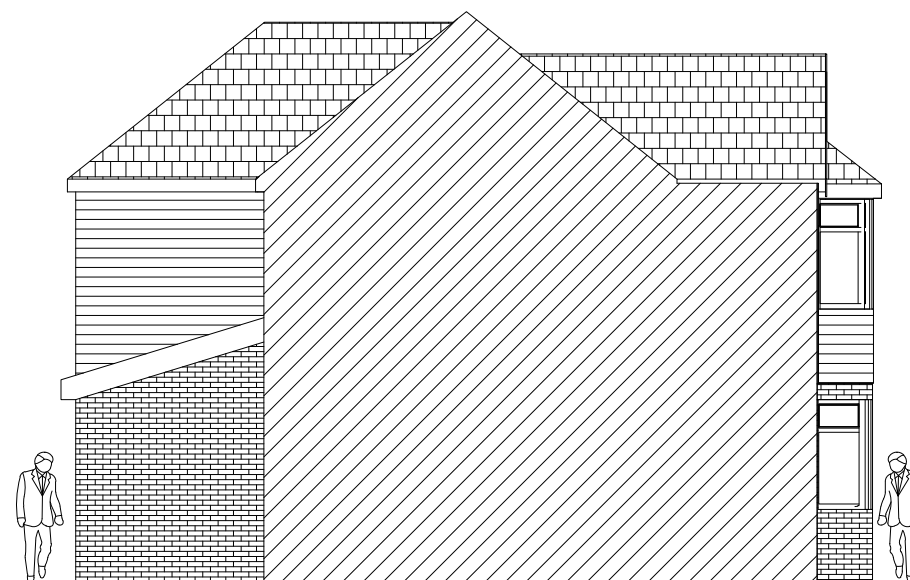

AS BUILT LEFT FLANK ELEVATION



AS BUILT FRONT ELEVATION

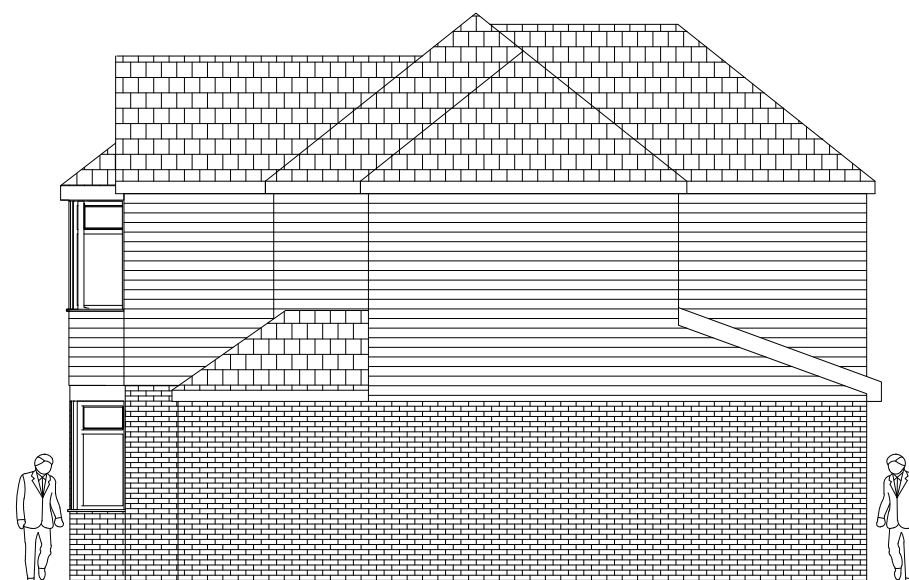

AS BUILT RIGHT FLANK ELEVATION



MINOR MATERIAL AMENDMENT TO 17/01428/HHA

REV	BY	DESCRIPTION	DATE	CHKD.
-	Wayne	ISSUED TO PLANNING FOR APPROVAL	04.03.2021	

Client Sarah Kirk



145 WHITMORE AVENUE, STIFFORD CLAYS, GRAYS, ESSEX. RM16 2HU.
Tel:- Office 01375 397181
Mobile 07702 407653
website:- wsd-draughting.co.uk
email:- wayne@wsd-draughting.co.uk

Contract 76 Blackshots Lane, Grays, RM16 2JU
Description AS BUILT ELEVATIONS SHOWING CLADDING INSTALLED

DRAWN BY	SCALE	DATE
Wayne Stear	1:100 @ A3	March 2021

DRAWING ISSUE CODES					
<input type="checkbox"/>	1. ISSUED FOR RECORD PURPOSES	<input checked="" type="checkbox"/>	4. ISSUED FOR APPROVAL	<input type="checkbox"/>	5. FOR CO-ORDINATION
<input type="checkbox"/>	2. CONSTRUCTION/MANUFACTURE ISSUE	<input type="checkbox"/>	3. ISSUED FOR RE-APPROVAL	<input type="checkbox"/>	6. FOR INFORMATION ONLY
CHECKED AND AUTHORISED FOR ISSUE AS INDICATED ABOVE					DATE

DRG.NO. Bld-1999-2 Sht. 2 of 2 REV -