


- Residential accommodation
- Let accommodation
- Boundary line
- Location of proposed works

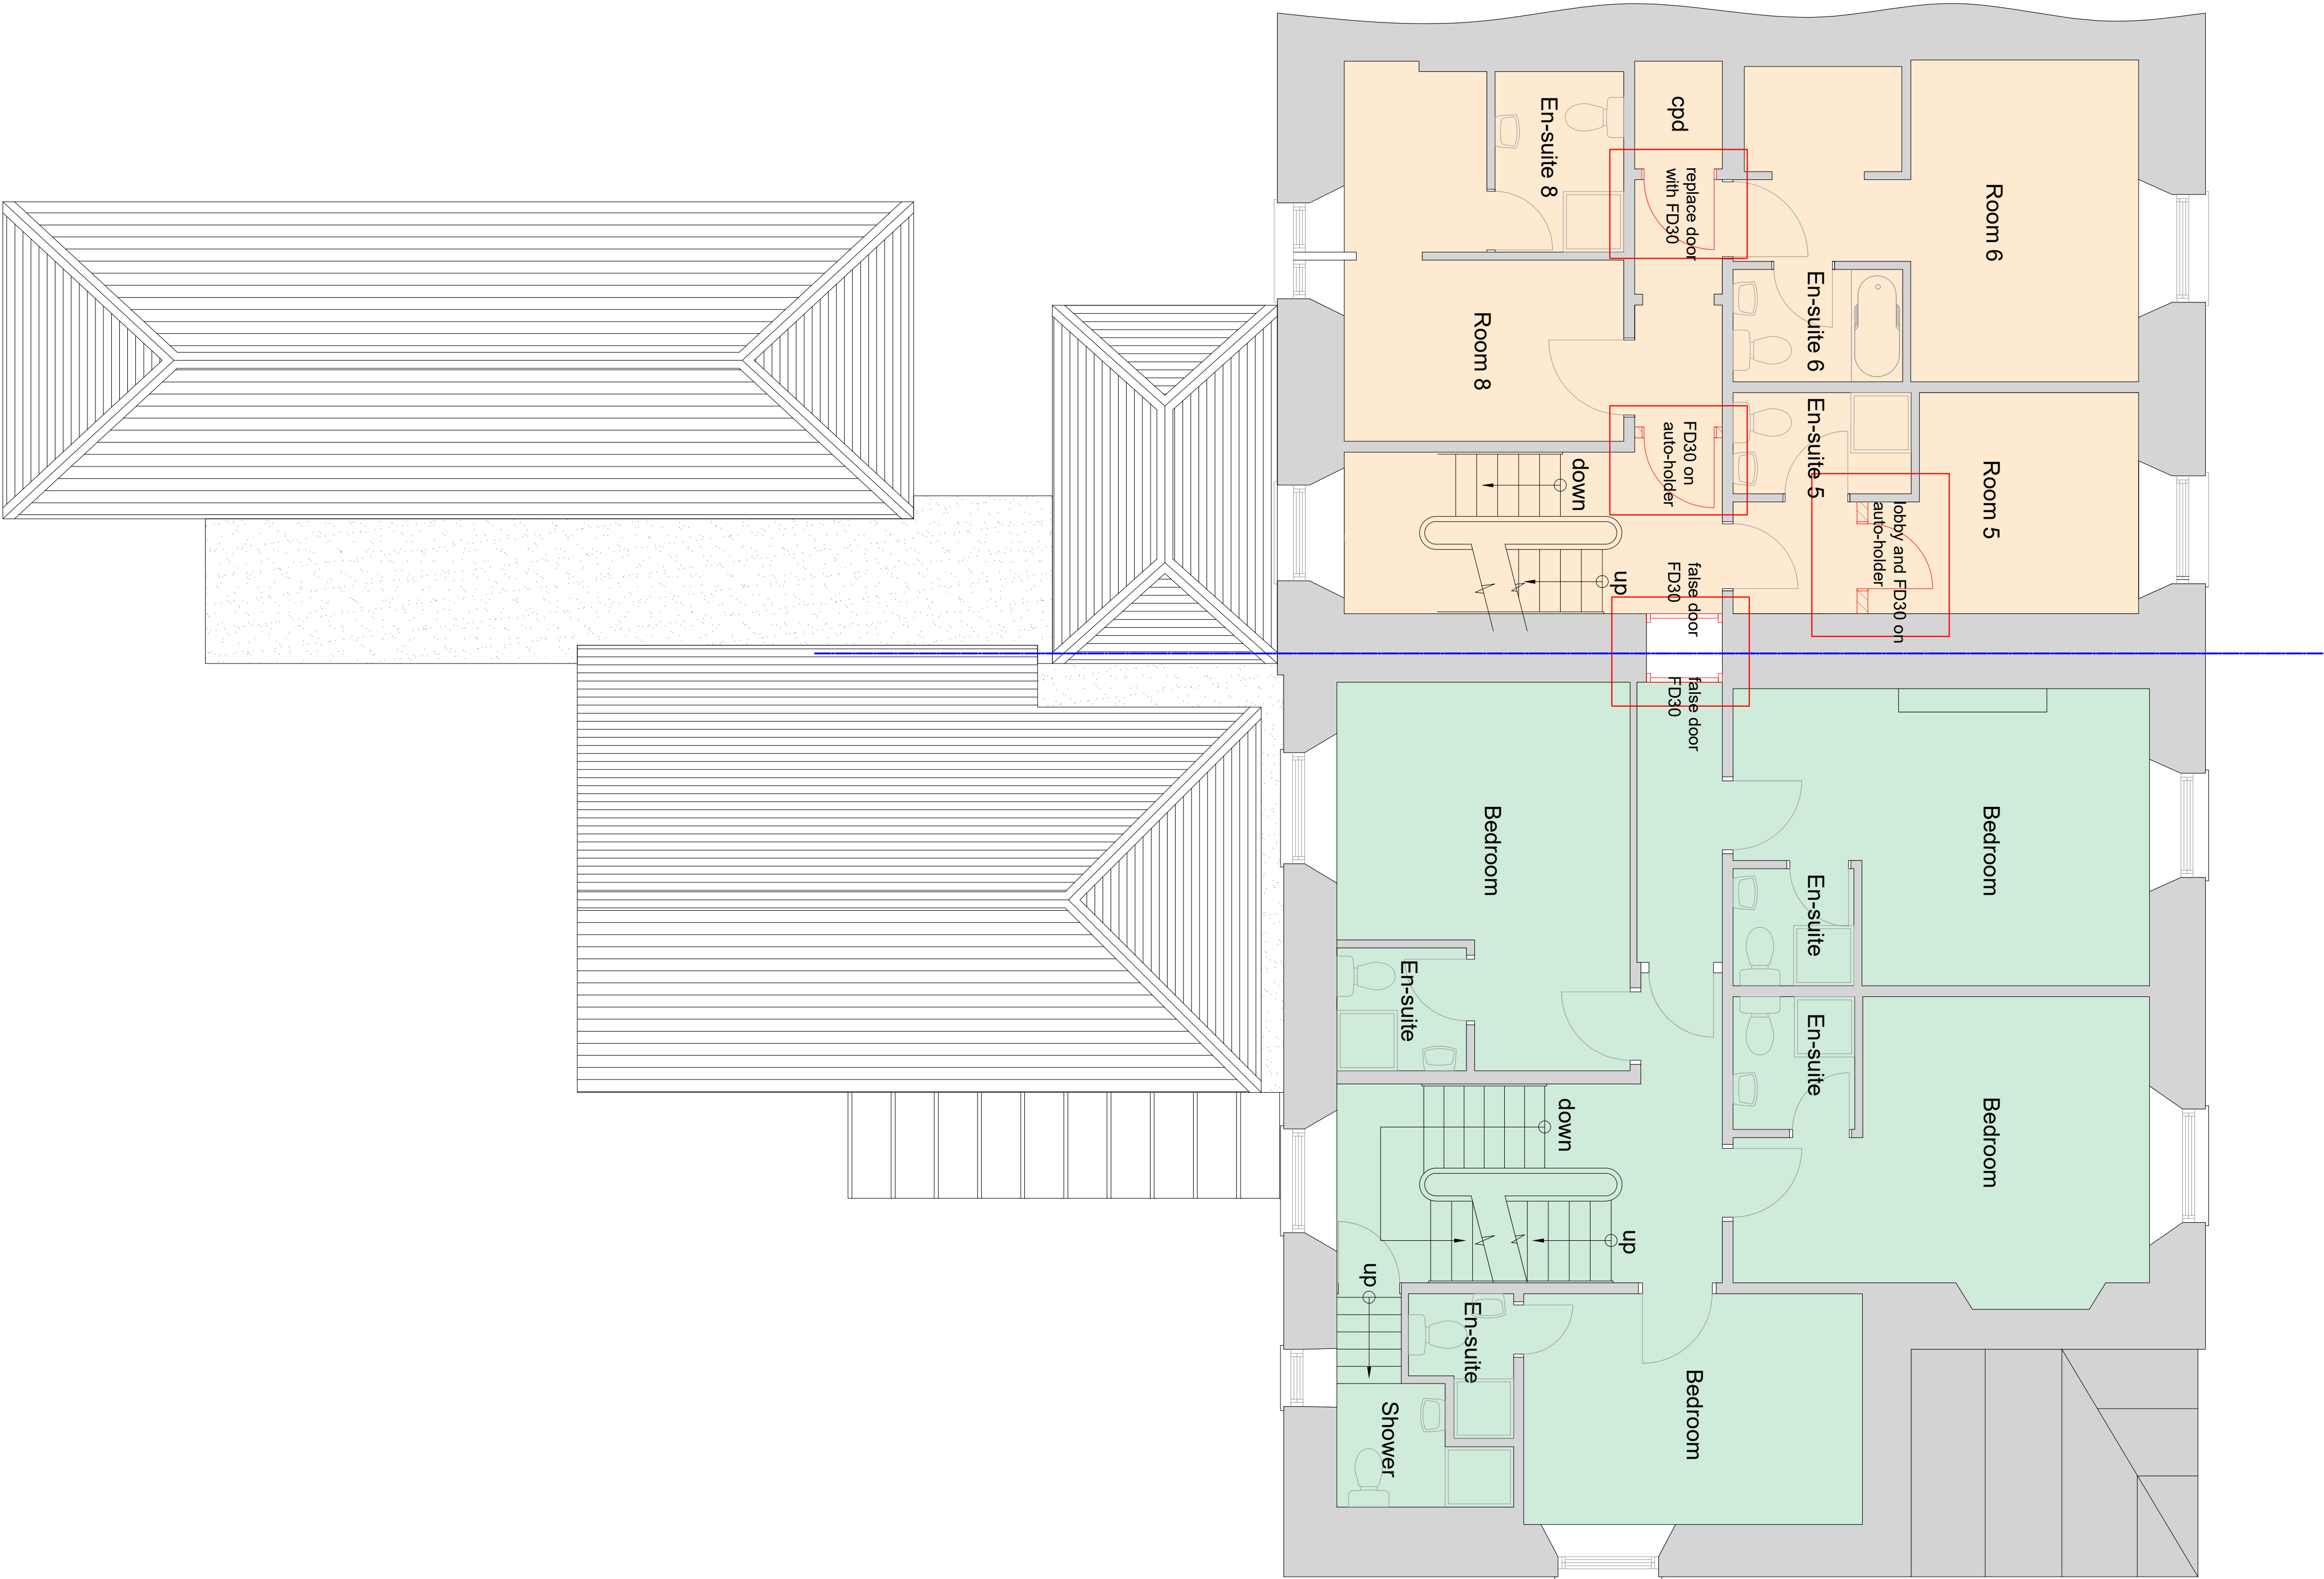

A	amendments from Fire Safety Consultant	HP	05/03/21
+	created from RTP measured Survey	HP	28/01/21
REVISION	AMENDMENT	INITIAL	DATE

- STATUS
- ☐

 Sketch Scheme
- ☒

 Planning
- ☐

 Building Regulations
- ☐

 Tender
- ☐

 Contract
- ☐

 As Built

PROJECT


The Grove  
1 & 2 Grove Place  
Falmouth  
TR11 4AU

CLIENT

Mr Geoffrey Cumins


DRAWING TITLE

Proposed First Floor Plan

 RTP

CHARTERED BUILDING SURVEYORS

RTP Surveyors  
9 Mount Polly Square  
Bodmin, Cornwall, PL31 2DF

 RICS

T 01208 892020  
F 01208 269476  
E Bodmin@rtpsurveyors.co.uk  
www.rtpsurveyors.co.uk  
Office also at Falmouth

SCALE	DRAWN BY	DRAWING	REV.	SIZE
1:50	HP	NO.		
DATE	CHECKED BY			
Feb 21		210037-07	A	A1

This drawing is copyright. All materials and workmanship to comply with the current British Standards and codes of practice. Contractors to check ALL dimensions. Work from figured dimensions ONLY. Report ANY discrepancy to Architect or Surveyor before proceeding. IF IN ANY DOUBT ASK.