
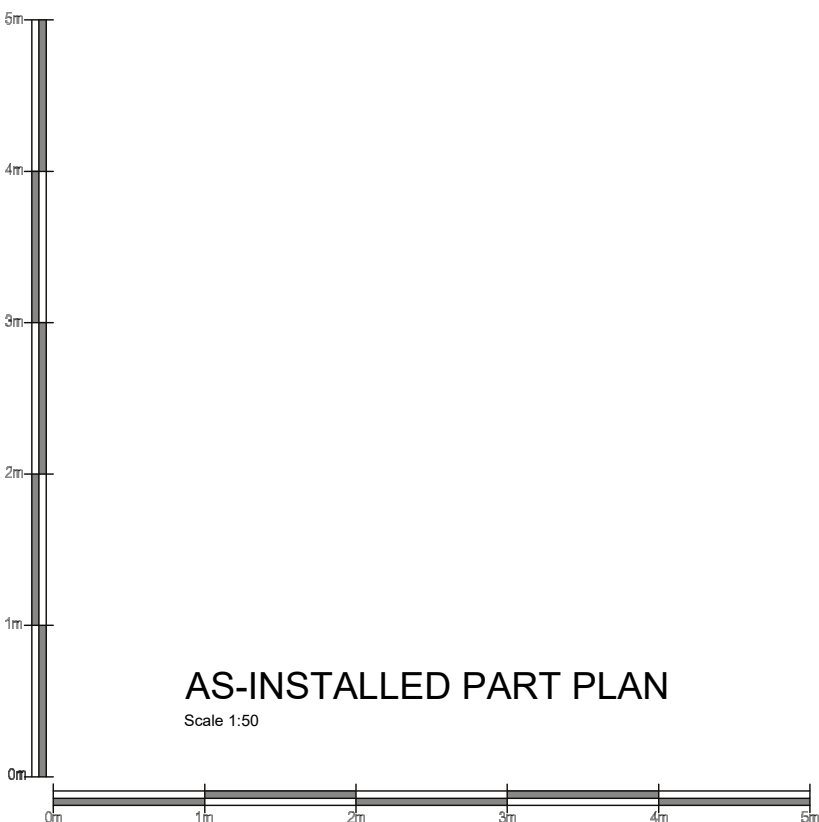



AS-INSTALLED FRONT ELEVATION

Scale 1:50

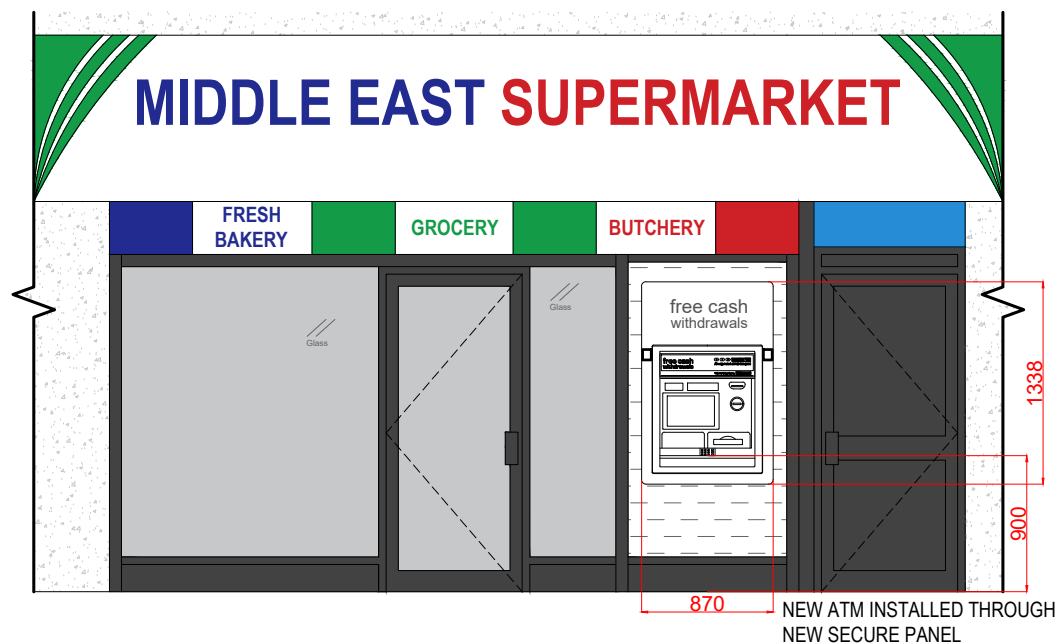

AS-INSTALLED PART PLAN

Scale 1:50

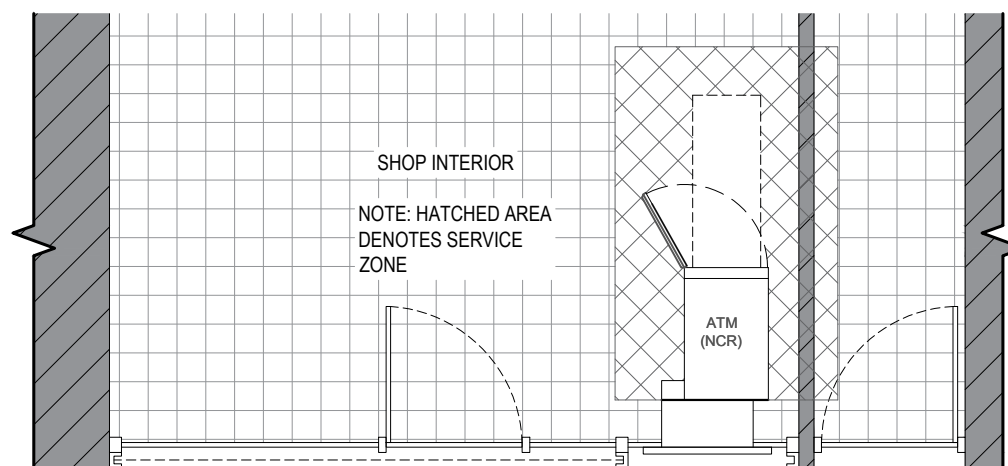

Date: Comments: By:

GENERAL NOTES:

1) All dimensions in millimeters unless otherwise stated.

Site:
 Middle East Supermarket,
 138 Oxford Road,
 Cowley,
 Oxford,
 OX4 2DU

Drawing Title:
 As-Installed Plan and Elevation

Ref: T020201_AI	Date: 02/11/2020	Rev:
Scale: 1:50	Paper: A3	Date Rev: