


second floor plan

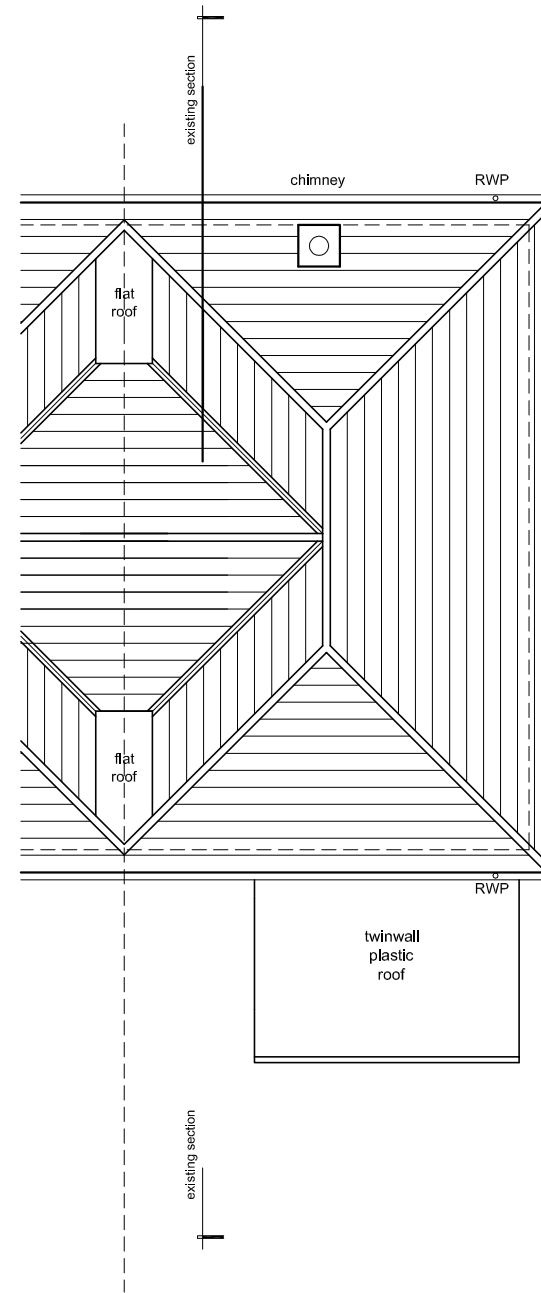

roof plan

Lightbox Architects

1 Kings Meadow
Osney Mead
Oxford
OX2 0DP
t 07901 521084
lightboxarchitects.com

title
extension and alteration to
23 Terrett Avenue
Sandhills
Oxford
OX3 8FE
for Matthijs Branderhorst and
Angela Brueggemann

drawing
existing second floor and roof plans

drawing number
TER23 011

scale at A3
1:100
date
October 2020
drawn by
jmac

RECORD DRAWING

