


NORTHEAST ELEVATION




SOUTHWEST ELEVATION



NORTHWEST ELEVATION

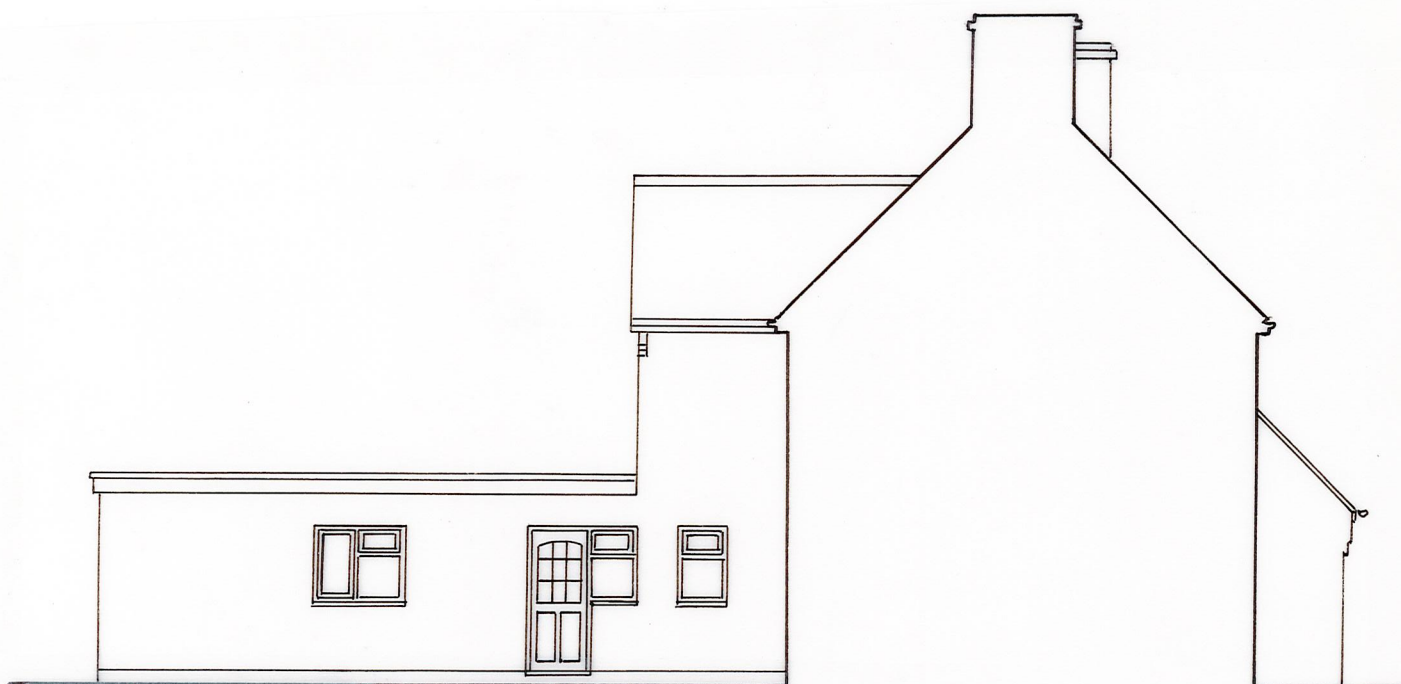

SOUTHEAST ELEVATION

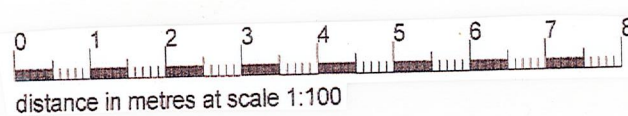

| | |
|---|--|
| Digby Architectural | |
| www.digbyarchitectural.co.uk Robert Tomlinson BA (Hons) Arch / Dip Arch / Dip U.D. | |
| ADDRESS: 5 Netherwoods Road, Headington, Oxford, OX3 8HF | |
| TEL NOS: 01865 761707 or 07979756918 | |
| EMAIL: info@digbyarchitectural.co.uk | |
| CLIENT: | MR. JABAD UDDIN |
| PROJECT: | SUD-DIVISION PROJECT AT 24 VAN-DIEMANS LANE, OXFORD |
| DRAWING: | AS BUILT, ELEVATIONS AND SECTION |
| DATE: | NOV. 2016 |
| SCALE: | 1:100 AT A3 |
| DRAWING NO.: | 24VDL:SU02 |
| REVISION: | A |