
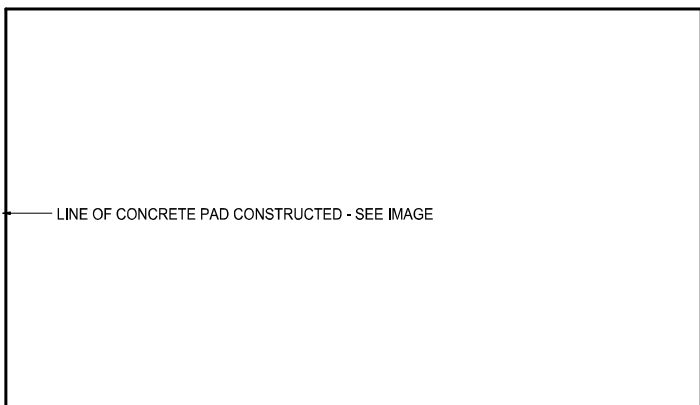


- This drawing is not to be scaled.
- Contractors must check all dimensions on site, Architect to be notified of any discrepancies in figured dimensions.
- No part of this drawing should be reproduced in any manner without written permission of M P Architects LLP except for the use it was created for.

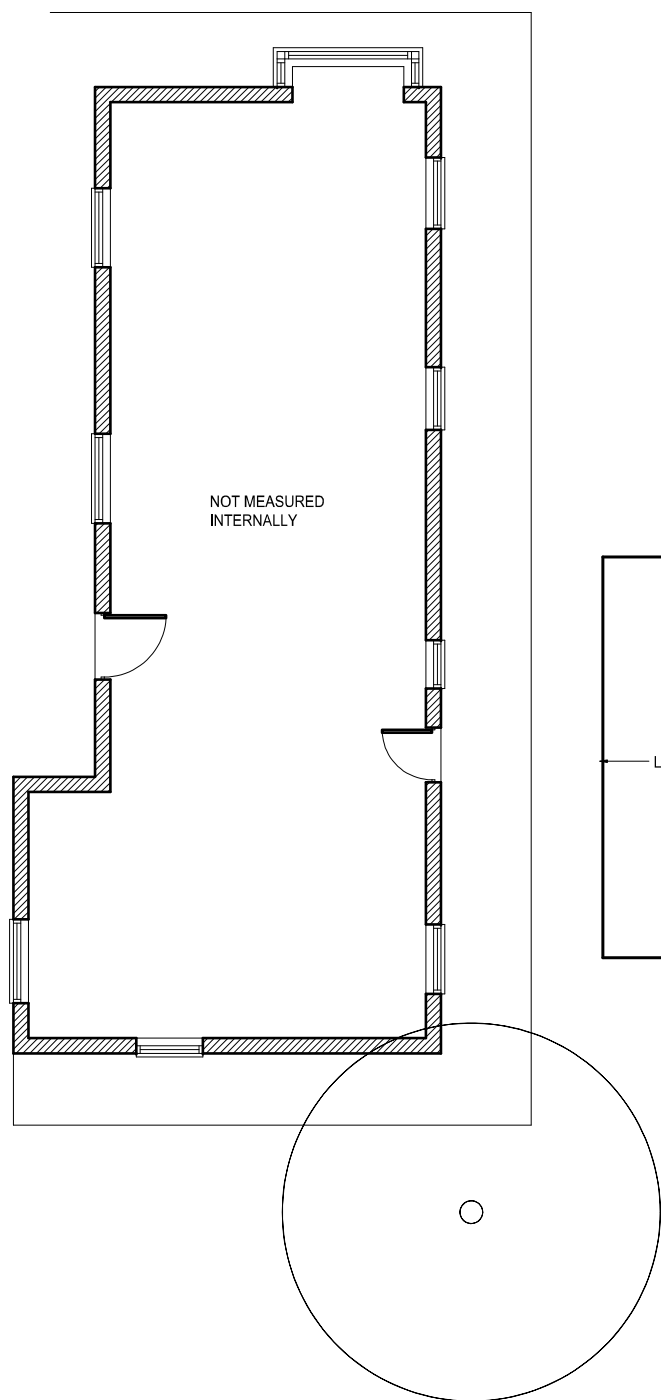

GROUND FLOOR PLAN

Rev.	Drawn	Description	Date
------	-------	-------------	------

M P ARCHITECTS LLP
CHARTERED ARCHITECTS

Great Basons, Basons Lane, Ongar, Essex. CM5 9AR

T: 01277 364979 E: info@mparchitectsllp.co.uk
W: www.mparchitectsllp.co.uk

Status FOR PLANNING

Project Pheasant Cottage, Shalford Road,
Panfield, Braintree, CM7 5AS

Drawing As constructed block plan

Scale 1:100 @ A3 Date January 2021

Drawn by TW Project no. 2482

Checked by - Drawing no. 04

Revision -

