




1 Proposed South West Elevation
1 : 100

WINDOW TYPES

W-01: Lounge Window
W-02: Lounge Window
W-03: Kitchen Window
W-04: Bedroom Window

NOTE: WINDOW TYPES 01-04 ARE NOT ORIGINAL AND HAVE ALREADY BEEN INSTALLED PRIOR TO THE SUBMISSION OF THIS APPLICATION


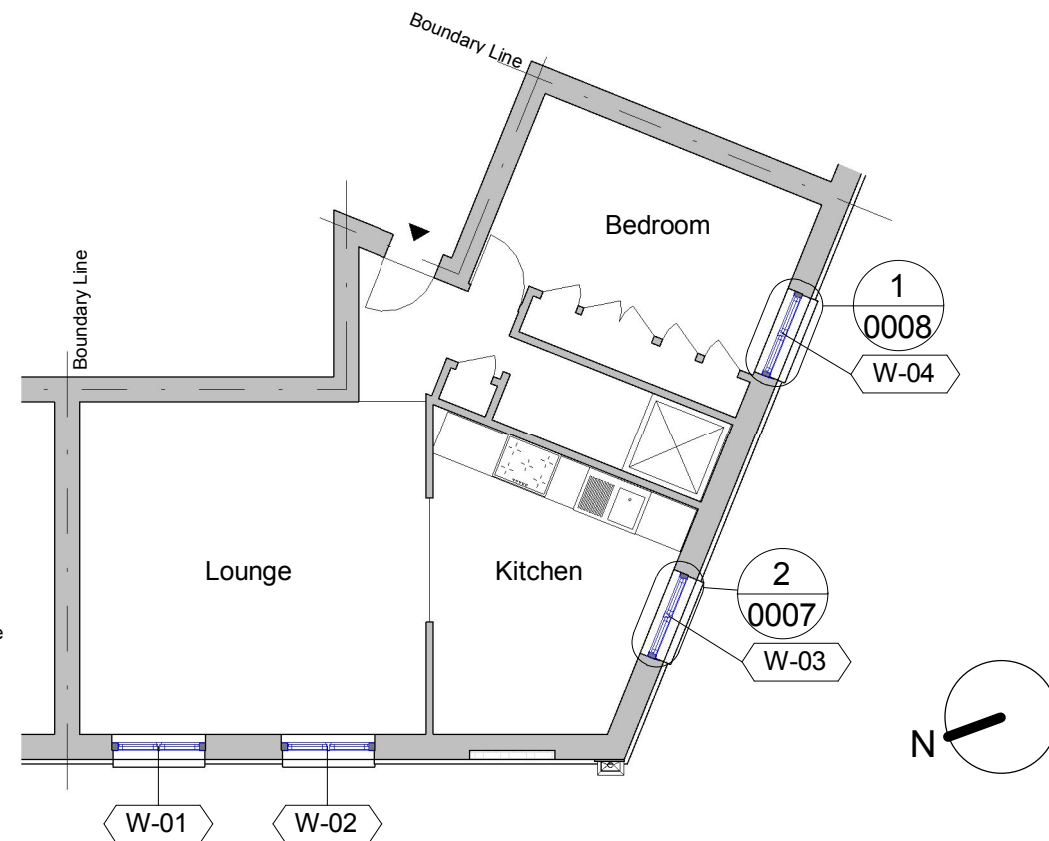


2 Proposed 3rd Floor Flat 5 Plan.
1 : 100

Notes

1. Do not scale this drawing.
2. All dimensions must be checked on site and any discrepancies verified with the architect.
3. Unless shown otherwise, all dimensions are to structural surfaces.
4. Drawing to be read with all other issued information. Any discrepancies to be brought to the attention of the architect.
5. This drawing is the copyright of Paul Little Architect and may not be copied, altered or reproduced in any form, or passed to a third party without license or written consent.

This is not a construction drawing, it is unsuitable for the purpose of construction and must on no account be used as such.

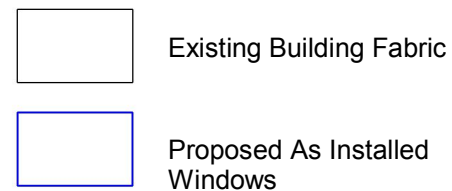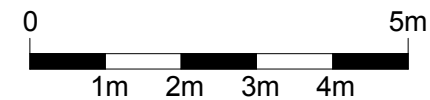

Rev	Date	Description	Initials
-----	------	-------------	----------

Project name

235 Sussex Gardens - Flat 5

Retrospective Planning / Listed Building Consent

Drawing number Rev

0007 - PLA - XX - 03 - DR - A - 0005 1

Drawing

Proposed As Installed South West Elevation and Floor Plan

Purpose of issue Date

PLANNING 02/06/21

Scale

As indicated @ A3

Client

Victoria Rudnik and Boris Rudnik

PLA | Paul Little Architect

paullittlearchitect.co.uk
T +44 (0)7903 624 996