




1 Proposed North West Elevation
1 : 100

WINDOW TYPES

W-01: Lounge Window
W-02: Lounge Window
W-03: Kitchen Window
W-04: Bedroom Window

NOTE: WINDOW TYPES 01-04 ARE NOT ORIGINAL AND HAVE ALREADY BEEN INSTALLED PRIOR TO THE SUBMISSION OF THIS APPLICATION

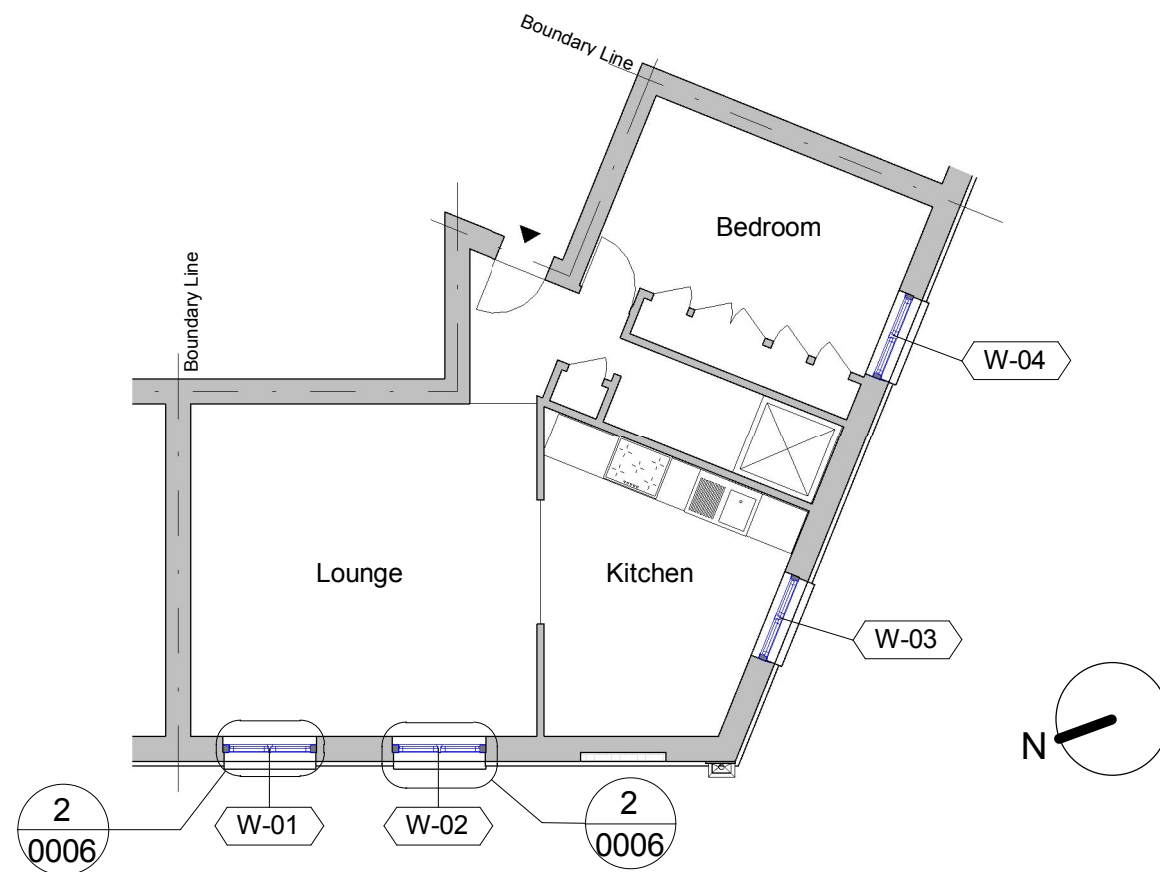


2 Proposed 3rd Floor Flat 5 Plan
1 : 100

Notes

1. Do not scale this drawing.
2. All dimensions must be checked on site and any discrepancies verified with the architect.
3. Unless shown otherwise, all dimensions are to structural surfaces.
4. Drawing to be read with all other issued information. Any discrepancies to be brought to the attention of the architect.
5. This drawing is the copyright of Paul Little Architect and may not be copied, altered or reproduced in any form, or passed to a third party without license or written consent.

This is not a construction drawing, it is unsuitable for the purpose of construction and must on no account be used as such.

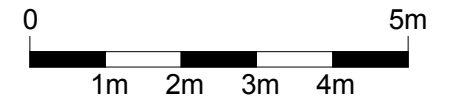

Existing Building Fabric
Proposed As Installed Windows

1	24/02/21	ISSUED FOR PLANNING	
Rev	Date	Description	Initials
Project name			
235 Sussex Gardens - Flat 5			
Retrospective Planning / Listed Building Consent			
Drawing number		Rev	
0007 - PLA - XX - 03 - DR - A - 0004		1	
Drawing			
Proposed As Installed North West Elevation and Floor Plan			
Purpose of issue		Date	
PLANNING		02/06/21	
Scale			
As indicated @ A3			
Client			
Victoria Rudnik and Boris Rudnik			

PLA | Paul Little Architect

paullittlearchitect.co.uk
T +44 (0)7903 624 996