
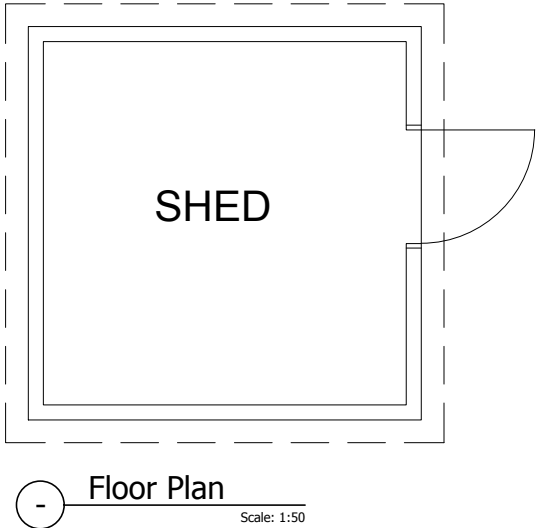


- Materials:
1.

Timber cladding
2.

Felt roof

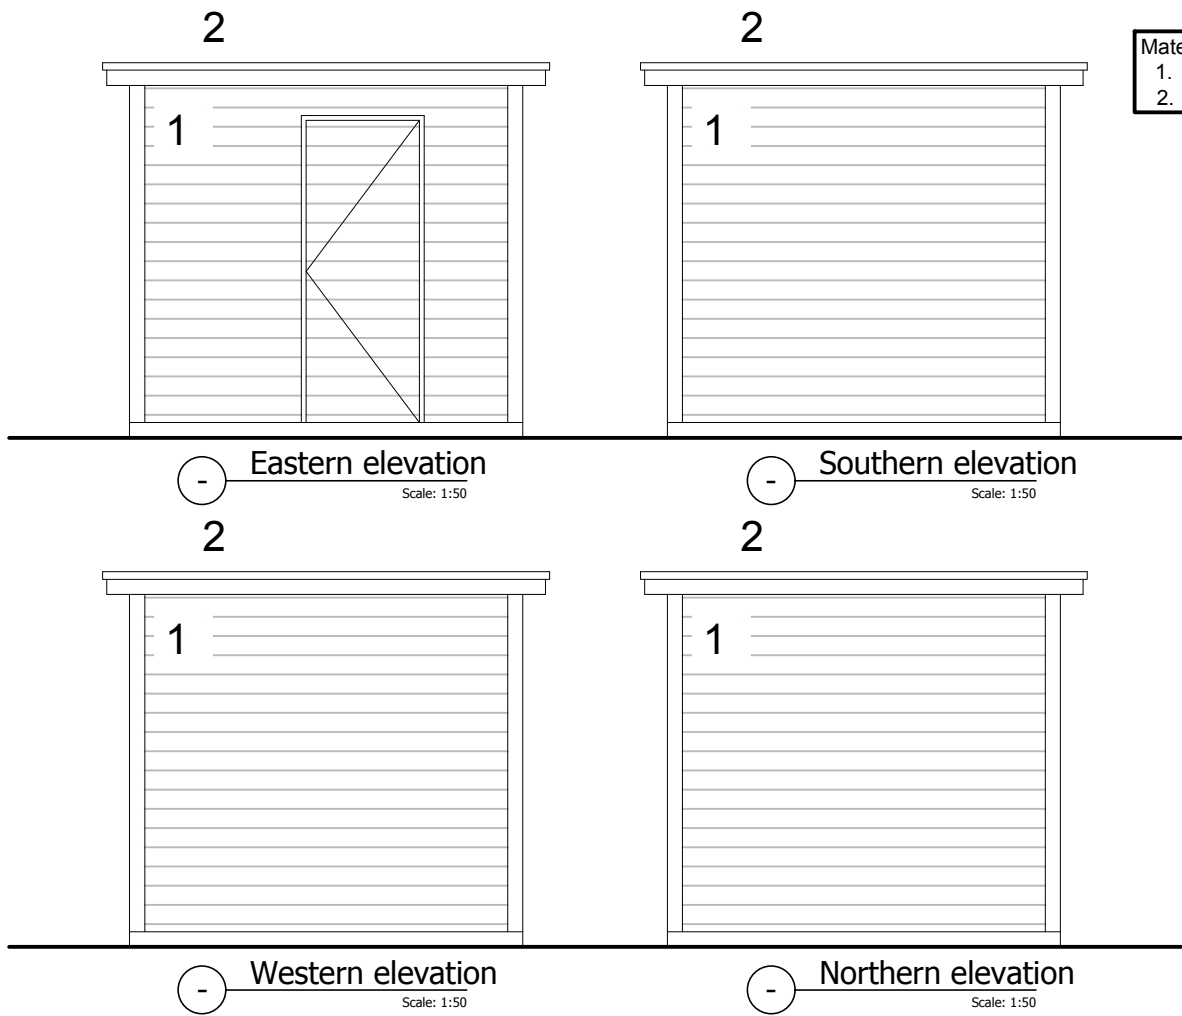

Prosed garden shed

Rosemary Cottage,  
Ferndale road, Whiteshill, Stroud

PRELIMINARY  
NOT FOR  
CONSTRUCTION

Revision no.

Project No. 594

Cad File 594\_V5.0.dwg

Drawn SC

Checked JD

Date 03/24/2021

Scale As shown @A3

Title/No.

As Built  
Shed Plans  
Elevations

A103

