




PROPOSED SITE PLAN

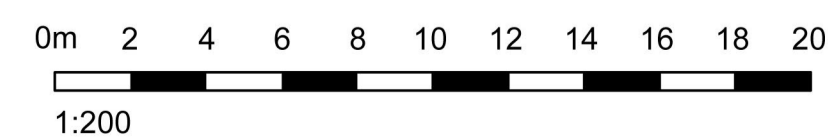

NOTES:
 - Broken red line indicates footprint of existing dwelling & garage
 - All proposed levels +/-300mm

Rev A 25 March 2021 For Non-Material Amendment

studioarc

67 Lemon Street
 TRURO
 TR1 2PN
 t : 01872 274200
 www.studio-arc.co.uk

project title
ARC_089_Riverside Avenue

drawing title	Proposed Site Plan	date	Jan 2020
scale	1:200 @ A1	drawn by	LB

status	drawing number	revision
planning	SP01	A