



REAR COMMUNAL DRIVE

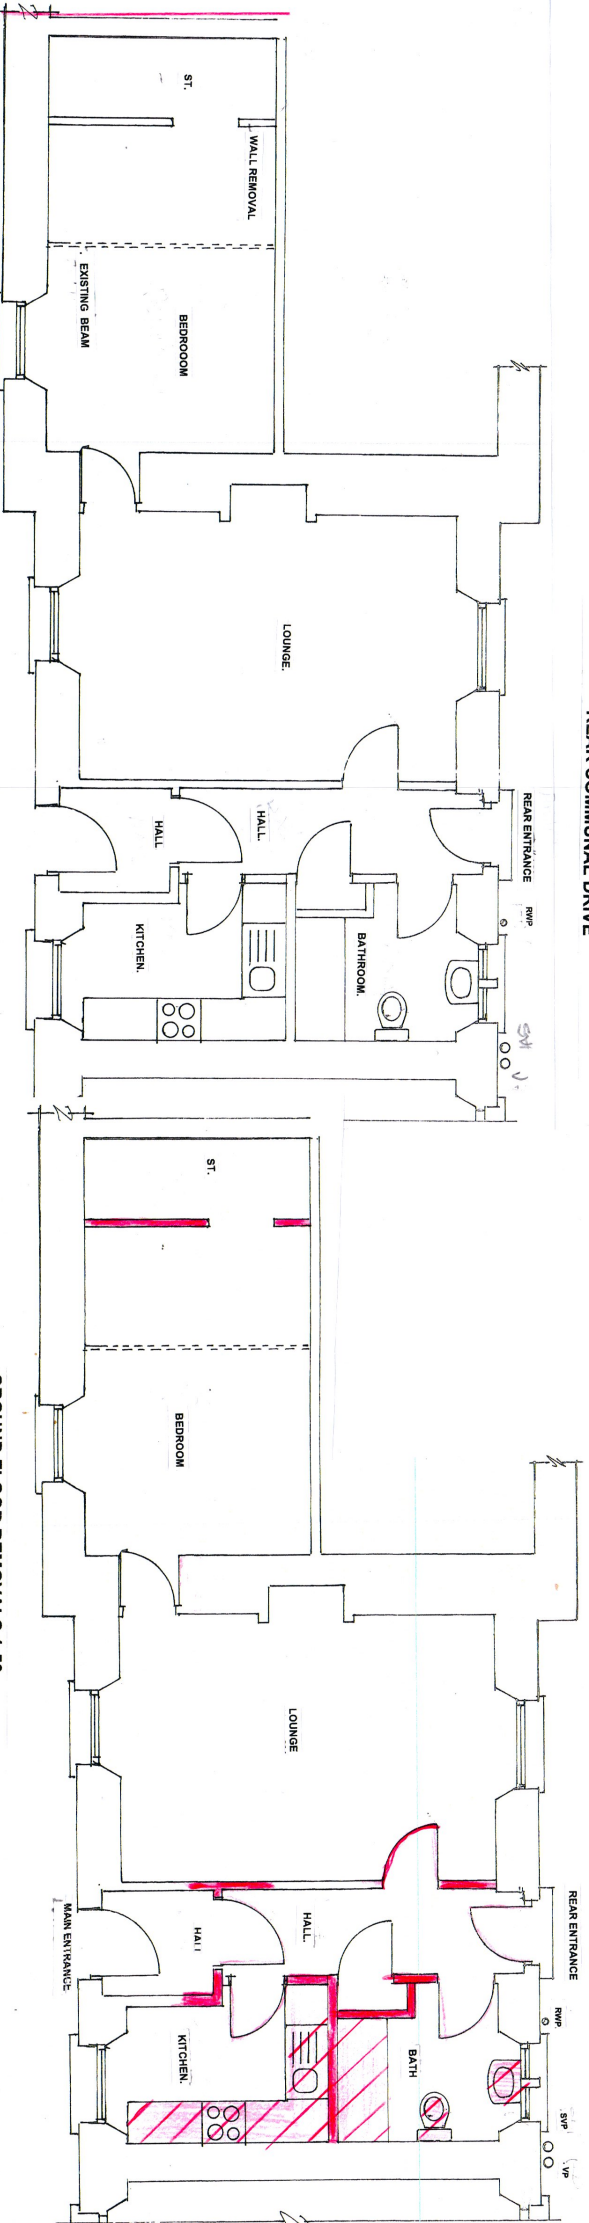

EXISTING PLAN LAYOUT 1:50

GROUND FLOOR REMOVALS 1:50  
(SHOWN IN RED)

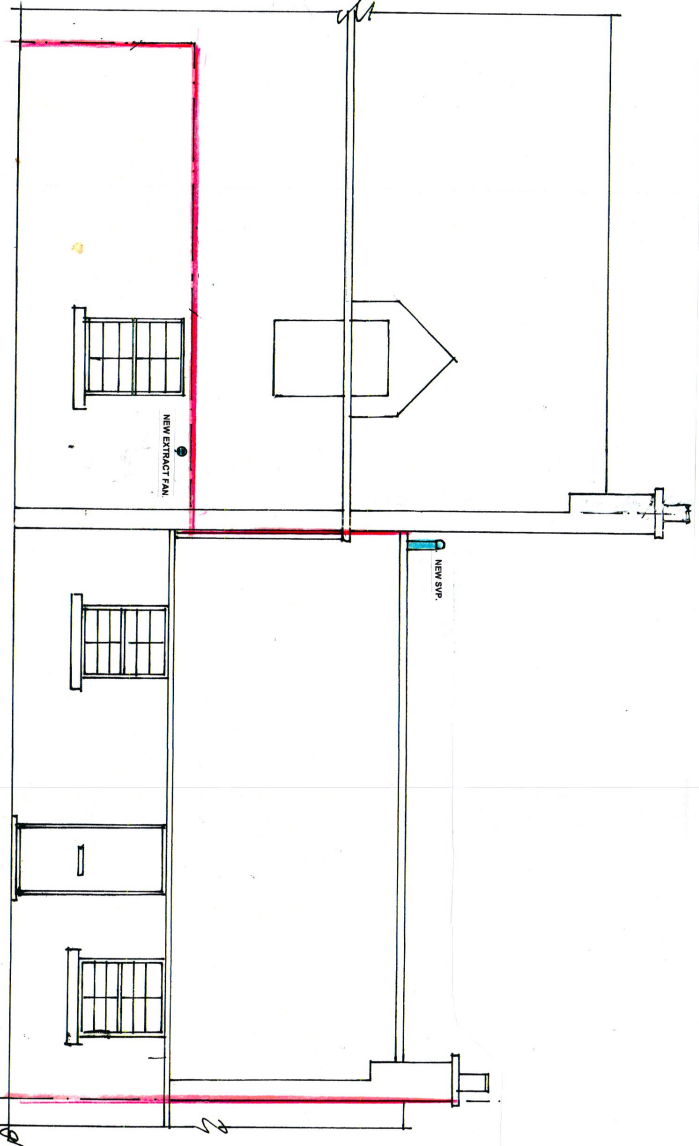


PROPOSED FRONT ELEVATION 1:50

NO PART OF THIS DRAWING OR ANY INFORMATION CONTAINED HEREIN IS TO BE COPIED, REPRODUCED, STORED IN A RETRIEVABLE SYSTEM, TRANSMITTED IN ANY FORM OR BY ANY MEANS, ELECTRONIC OR MECHANICAL, INCLUDING PHOTOCOPYING, RECORDING, OR BY ANY INFORMATION STORAGE AND RETRIEVAL SYSTEM, WITHOUT THE WRITTEN CONSENT OF FGH ARCHITECTURAL & BUILDING DESIGN SERVICES. All rights reserved. © Copyright 2021 FGH ARCHITECTURAL & BUILDING DESIGN SERVICES

**Client:** Ms. Joanne Evans  
**Property Address:** 6 New Vines Cottages, New Vines, EH3 2NH  
**Architectural & Building Design:** 1 Ferintosh Farm Cottages, East Lothian, EH35 5AN  
**Tel:** 07749491795  
**Date:** March 2021

**FGH**  
 Architectural & Building Design  
 1 Ferintosh Farm Cottages  
 East Lothian, EH35 5AN  
 Tel: 07749491795  
 Date: March 2021

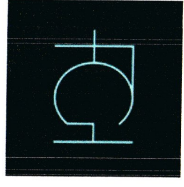

Read in Conjunction with Specification  
 EXISTING PLAN LAYOUT WITH REMOVALS  
 FRONT ELEVATION  
**DRAWING NO. D1**  
 A