


This drawing is protected by copyright and must not be copied or reproduced without the written consent of Graham Simpkin Planning. All dimensions and sizes to be checked on site. North points are indicative. ©

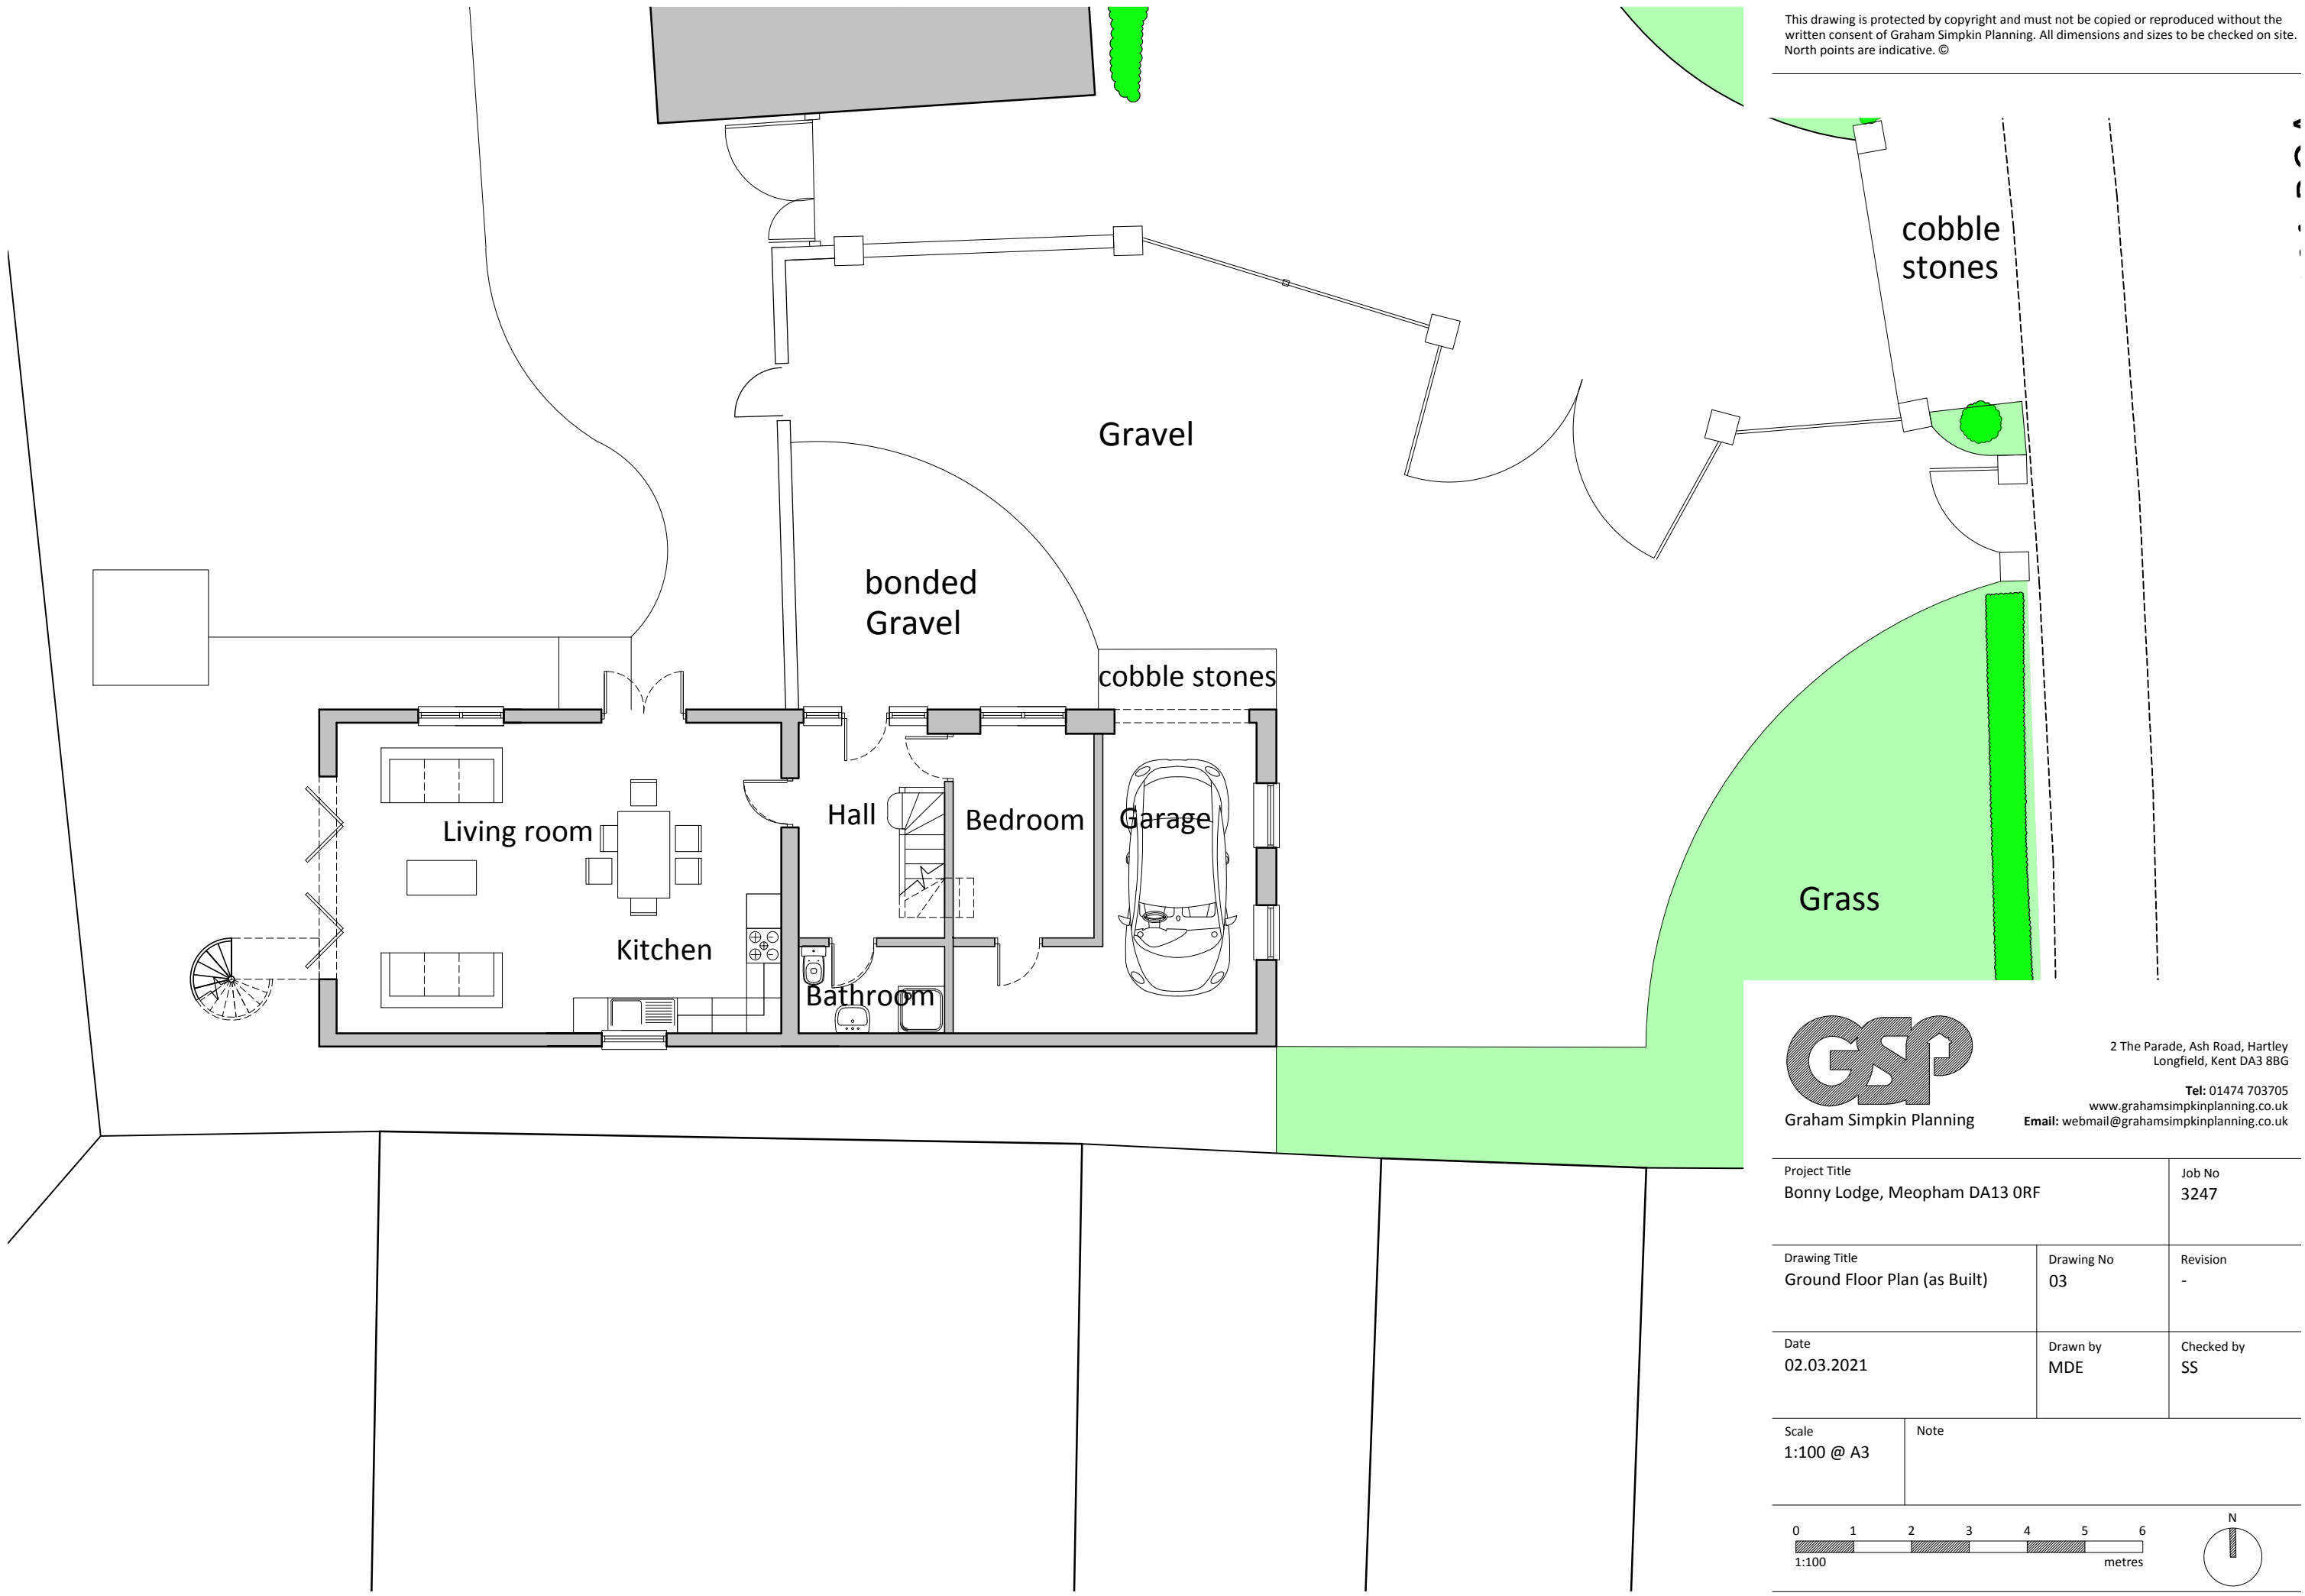

2 The Parade, Ash Road, Hartley Longfield, Kent DA3 8BG

Tel: 01474 703705

www.grahamsimpkinplanning.co.uk

Email: webmail@grahamsimpkinplanning.co.uk

Project Title Bonny Lodge, Meopham DA13 0RF	Job No 3247
--	----------------

Drawing Title Ground Floor Plan (as Built)	Drawing No 03	Revision -
---	------------------	---------------

Date 02.03.2021	Drawn by MDE	Checked by SS
--------------------	-----------------	------------------

Scale 1:100 @ A3	Note
---------------------	------

