

Copyright in design and this drawing is the property of Resi.

Reproduction in whole or in part is forbidden without written sanction of Resi.

All dimensions to be cross-checked on site prior to completing a Building Regulations package, structural engineering, the party wall process and construction.

Print to scale (as actual size)

NOTES

Proposed Materials:

Brickwork / Walls - Cream painted render to match existing

Flat Roof - Fibreglass

Windows - Aluminium glazed windows

Doors - Aluminium glazed doors and aluminium gate

RWP / Gutters / Fascia - Black uPVC downpipes, guttering and white painted timber fascias

Revision

Rev	Notes	Date
-	Planning Issue	04/12/2020

KEY

	Proposed walls		Boundary lines
	Existing walls		Proposed beam
	Existing removed		Proposed drainage
	Proposed rooflight		1.8m head height
			1.5m head height

JOB TITLE

Retrospective proposed garden annex, floor plan redesign and all associated works at 51 Stephenson Avenue

STATUS

Planning

DRAWING TITLE

As Built Elevations

CLIENT

Ana Constantinescu

SCALE
1:100 at A3

DRAWN
AR


DATE
Dec 2020

CHECKED
DH

DRAWING NO. 70259 - 205



Rear Elevation

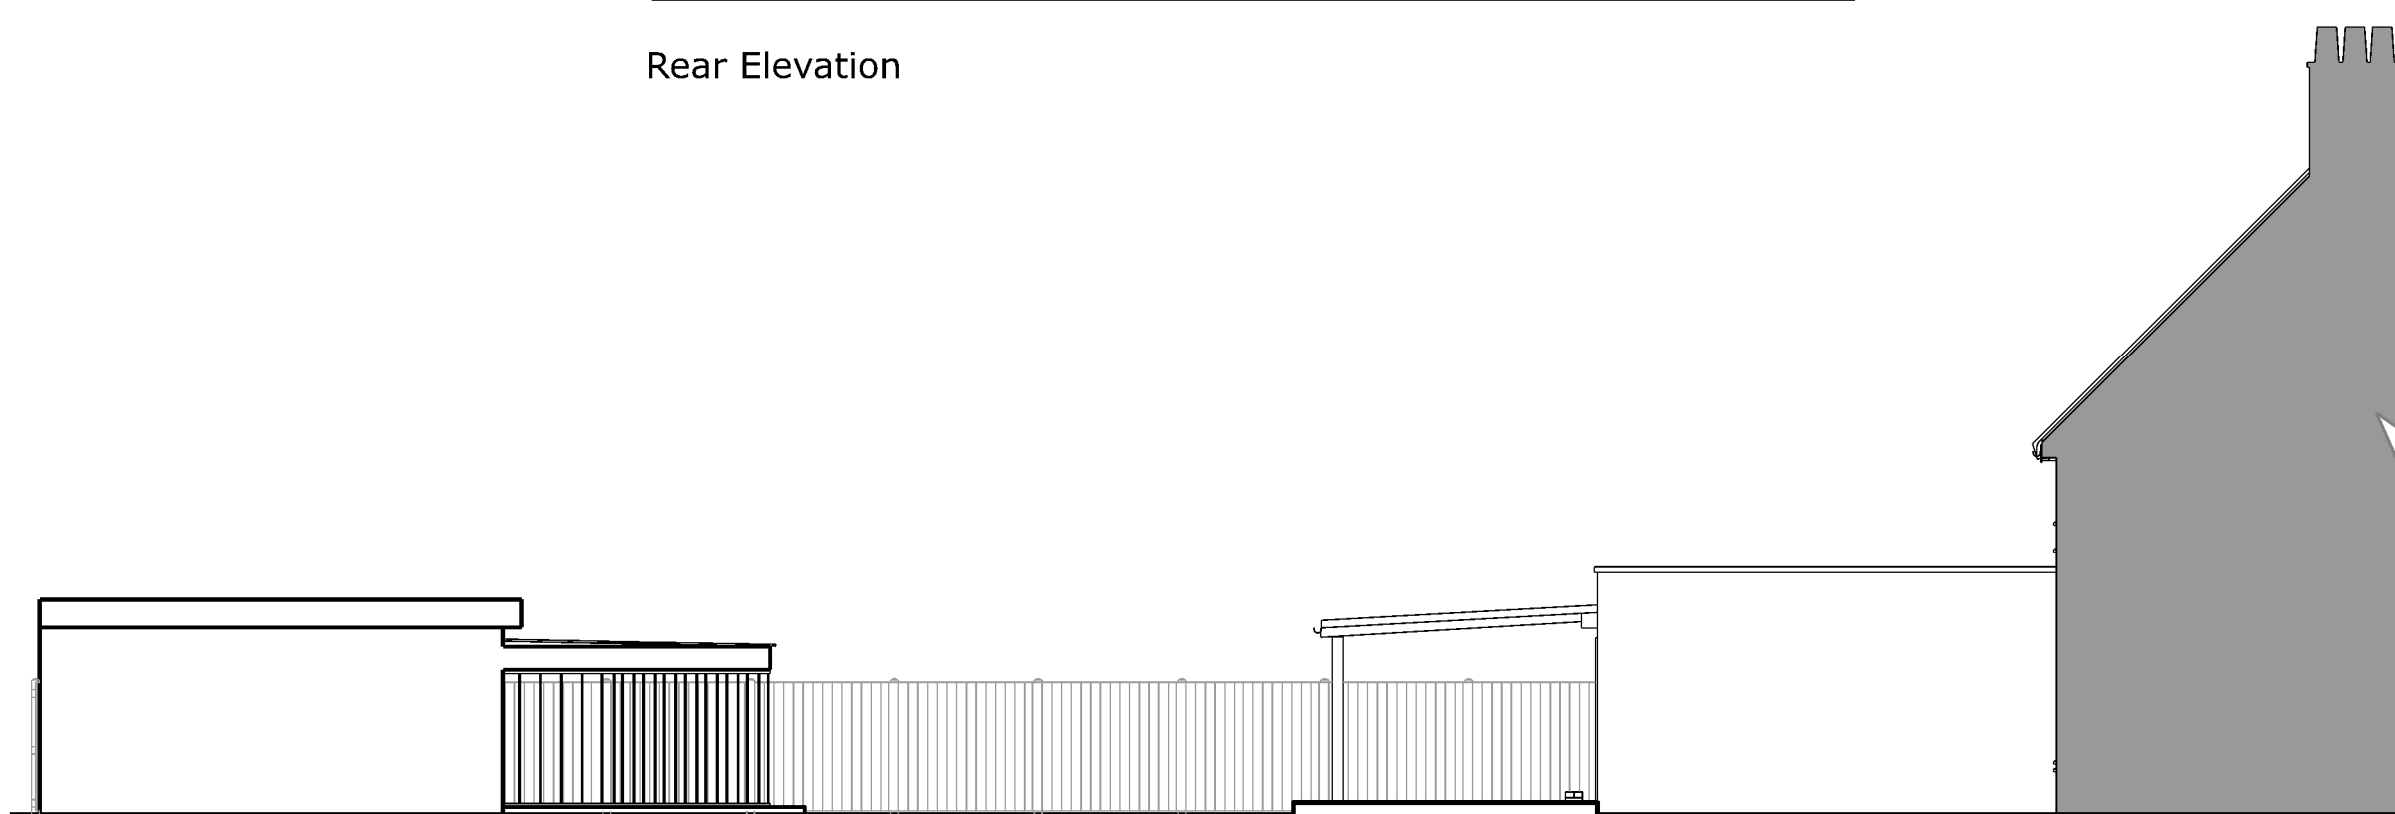

Left Side Elevation

