
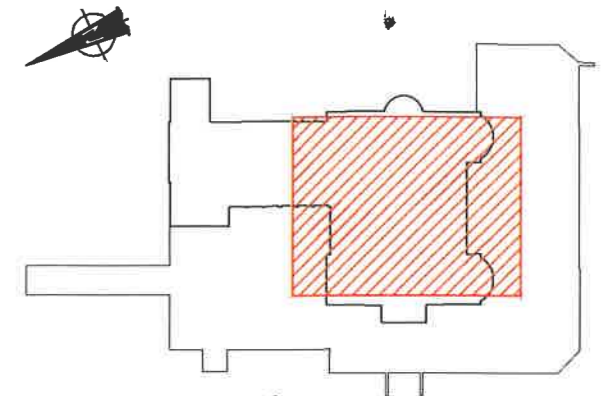



SCALE: 1:200 @ A3

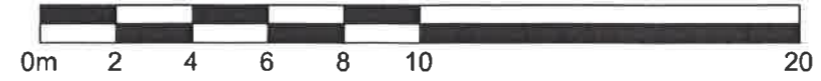

Yeh 20.4.21

NOTES

1. ALL DIMENSIONS IN MILLIMETRES UNLESS OTHERWISE STATED
2. PLEASE ~~DO NOT~~ SCALE FROM DRAWINGS ~~FOR~~ FOR PLANNING PURPOSES
3. CHECK AND VERIFY ALL CRITICAL DIMENSIONS BEFORE STARTING WORK EITHER ON SITE OR ON WORKSHOP DRAWINGS
4. THIS DRAWING TO BE READ IN CONJUNCTION WITH ALL OTHER ARCHITECTS', CONSULTANTS', CONTRACTORS', AND SUBCONTRACTORS' DRAWINGS
5. PLEASE REPORT ANY ERRORS, OMISSIONS, OR DISCREPANCIES BETWEEN DRAWINGS AND SITE CONDITIONS
6. ALL MATERIALS, COMPONENTS, AND WORKMANSHIP TO MEET OR EXCEED THE CURRENT BUILDING REGULATIONS AND BRITISH STANDARDS. APPROPRIATE MANUFACTURERS' RECOMMENDATIONS MUST ALWAYS BE FOLLOWED
7. THIS DRAWING IS NOT TO BE COPIED, REPRINTED, OR DISCLOSED TO ANY THIRD PARTY
8. ALL DESIGNS ARE COPYRIGHT © Kirk+Randall Ltd.

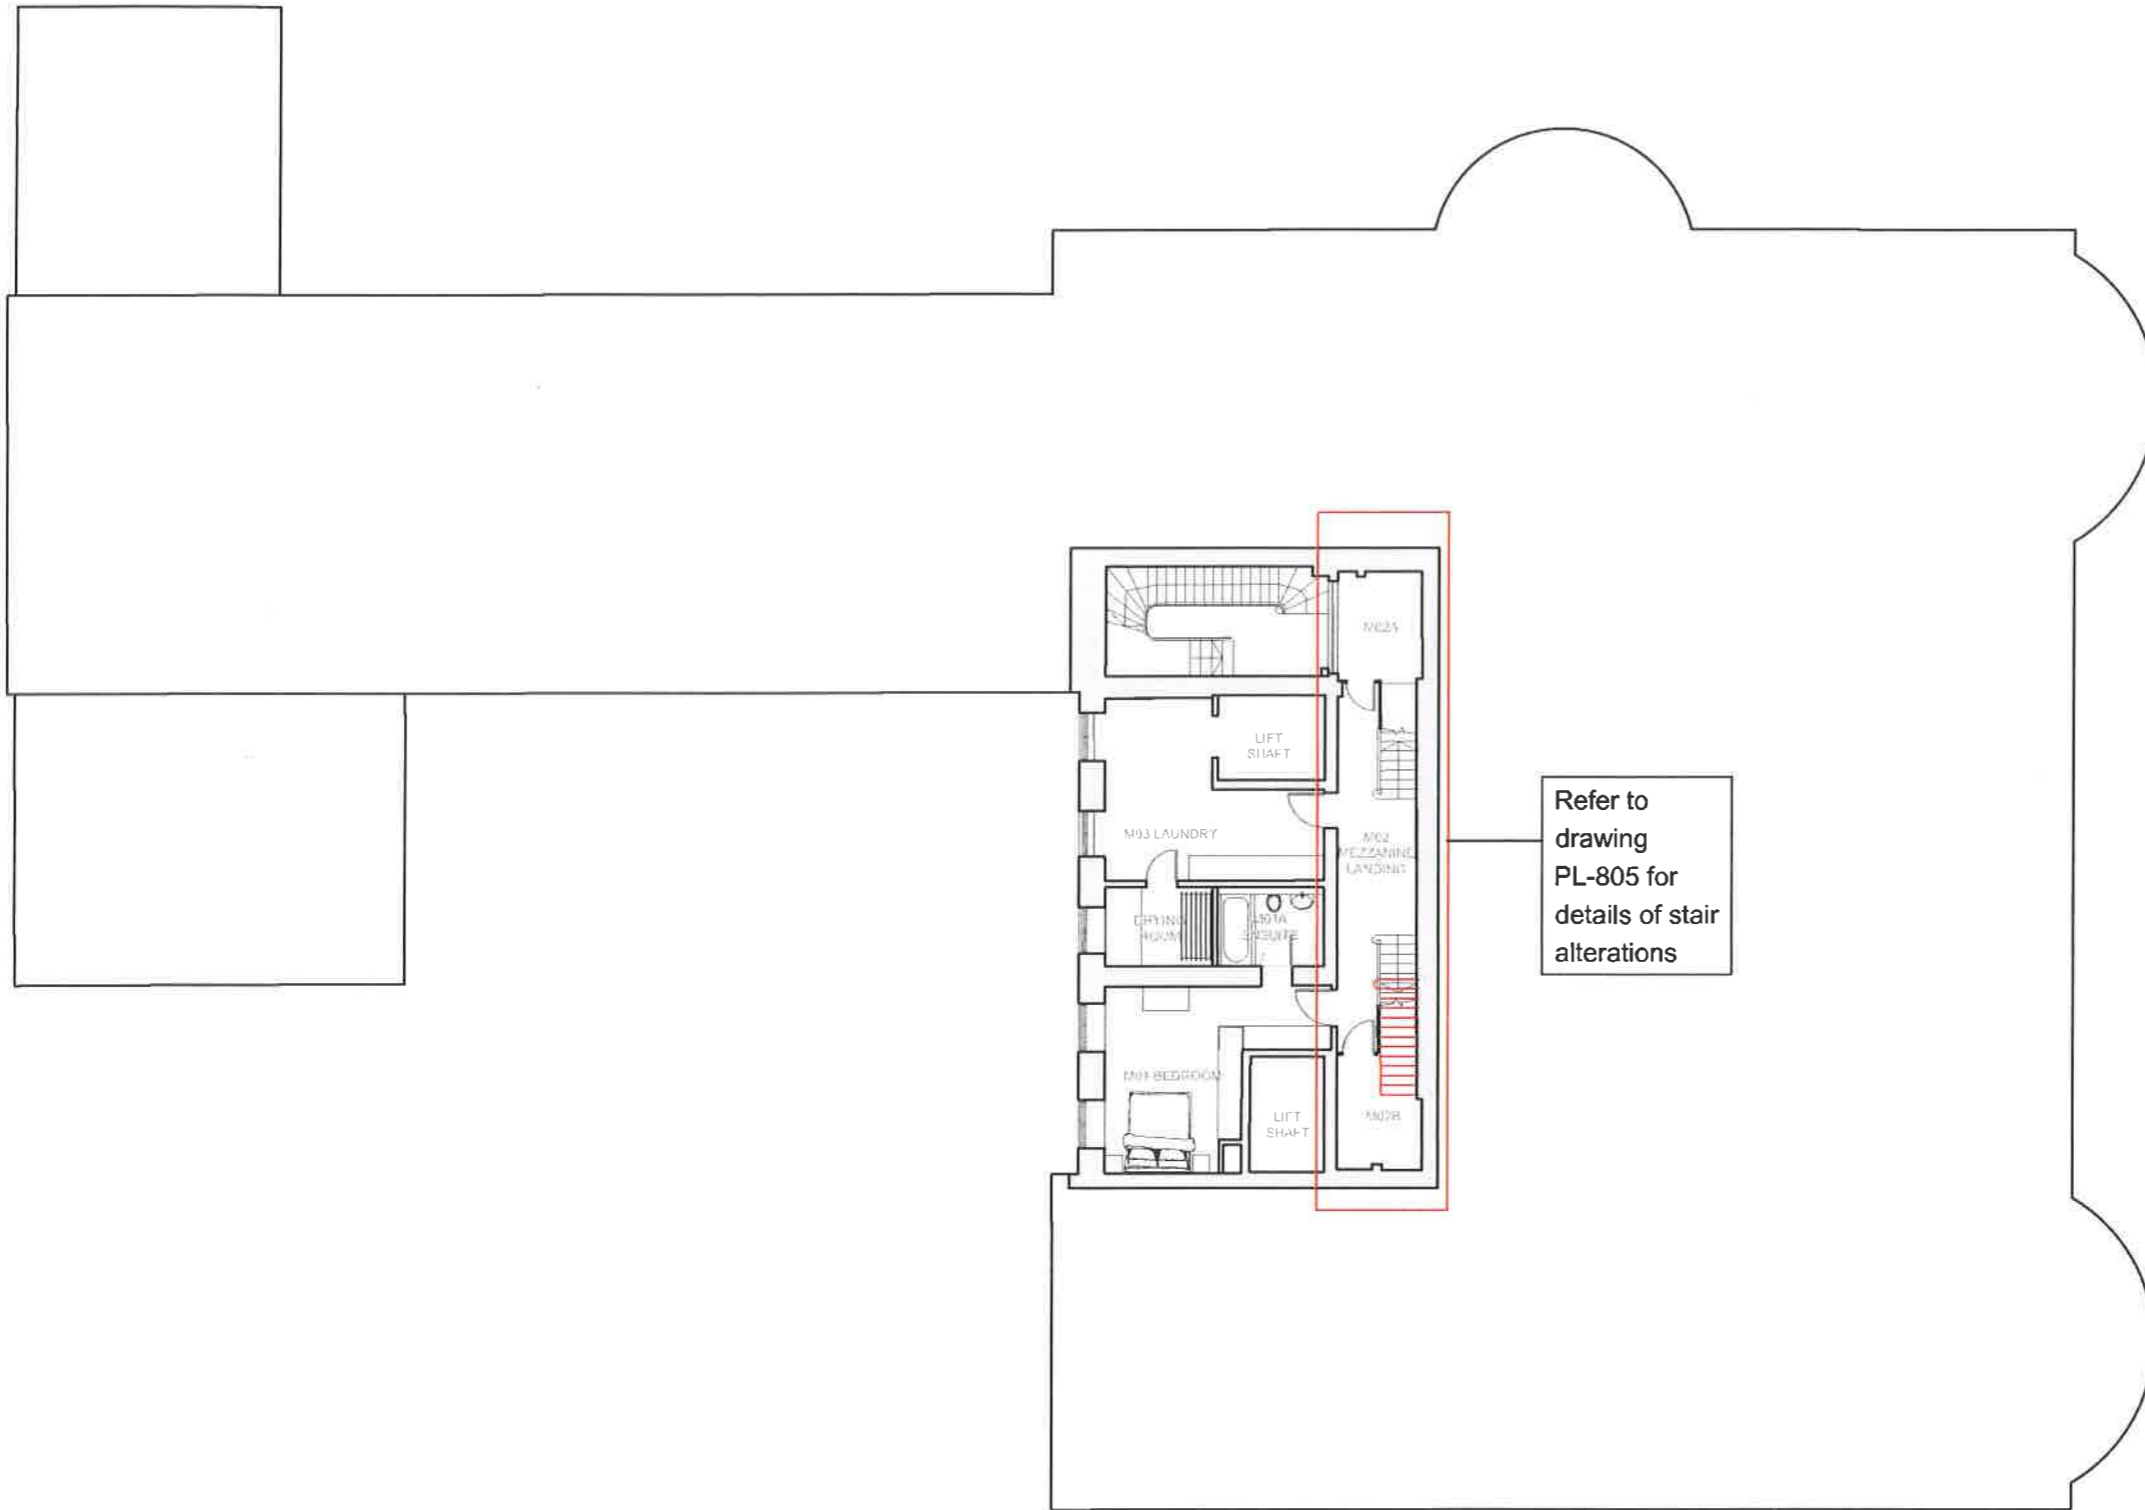

Refer to drawing PL-805 for details of stair alterations

A	11 12 20	Stair updated following design development
-	04 02 20	INITIAL ISSUE
REV	DATE	DESCRIPTION

KIRK + RANDALL

SACOMBE HOUSE SACOMBE PARK HERTS. SG12 0JB

SACOMBE HOUSE

MEZZANINE FLOOR PLAN

1:200@ A3

DRAWN: NP

PL-105

A