


PROPOSED GROUND FLOOR PLAN

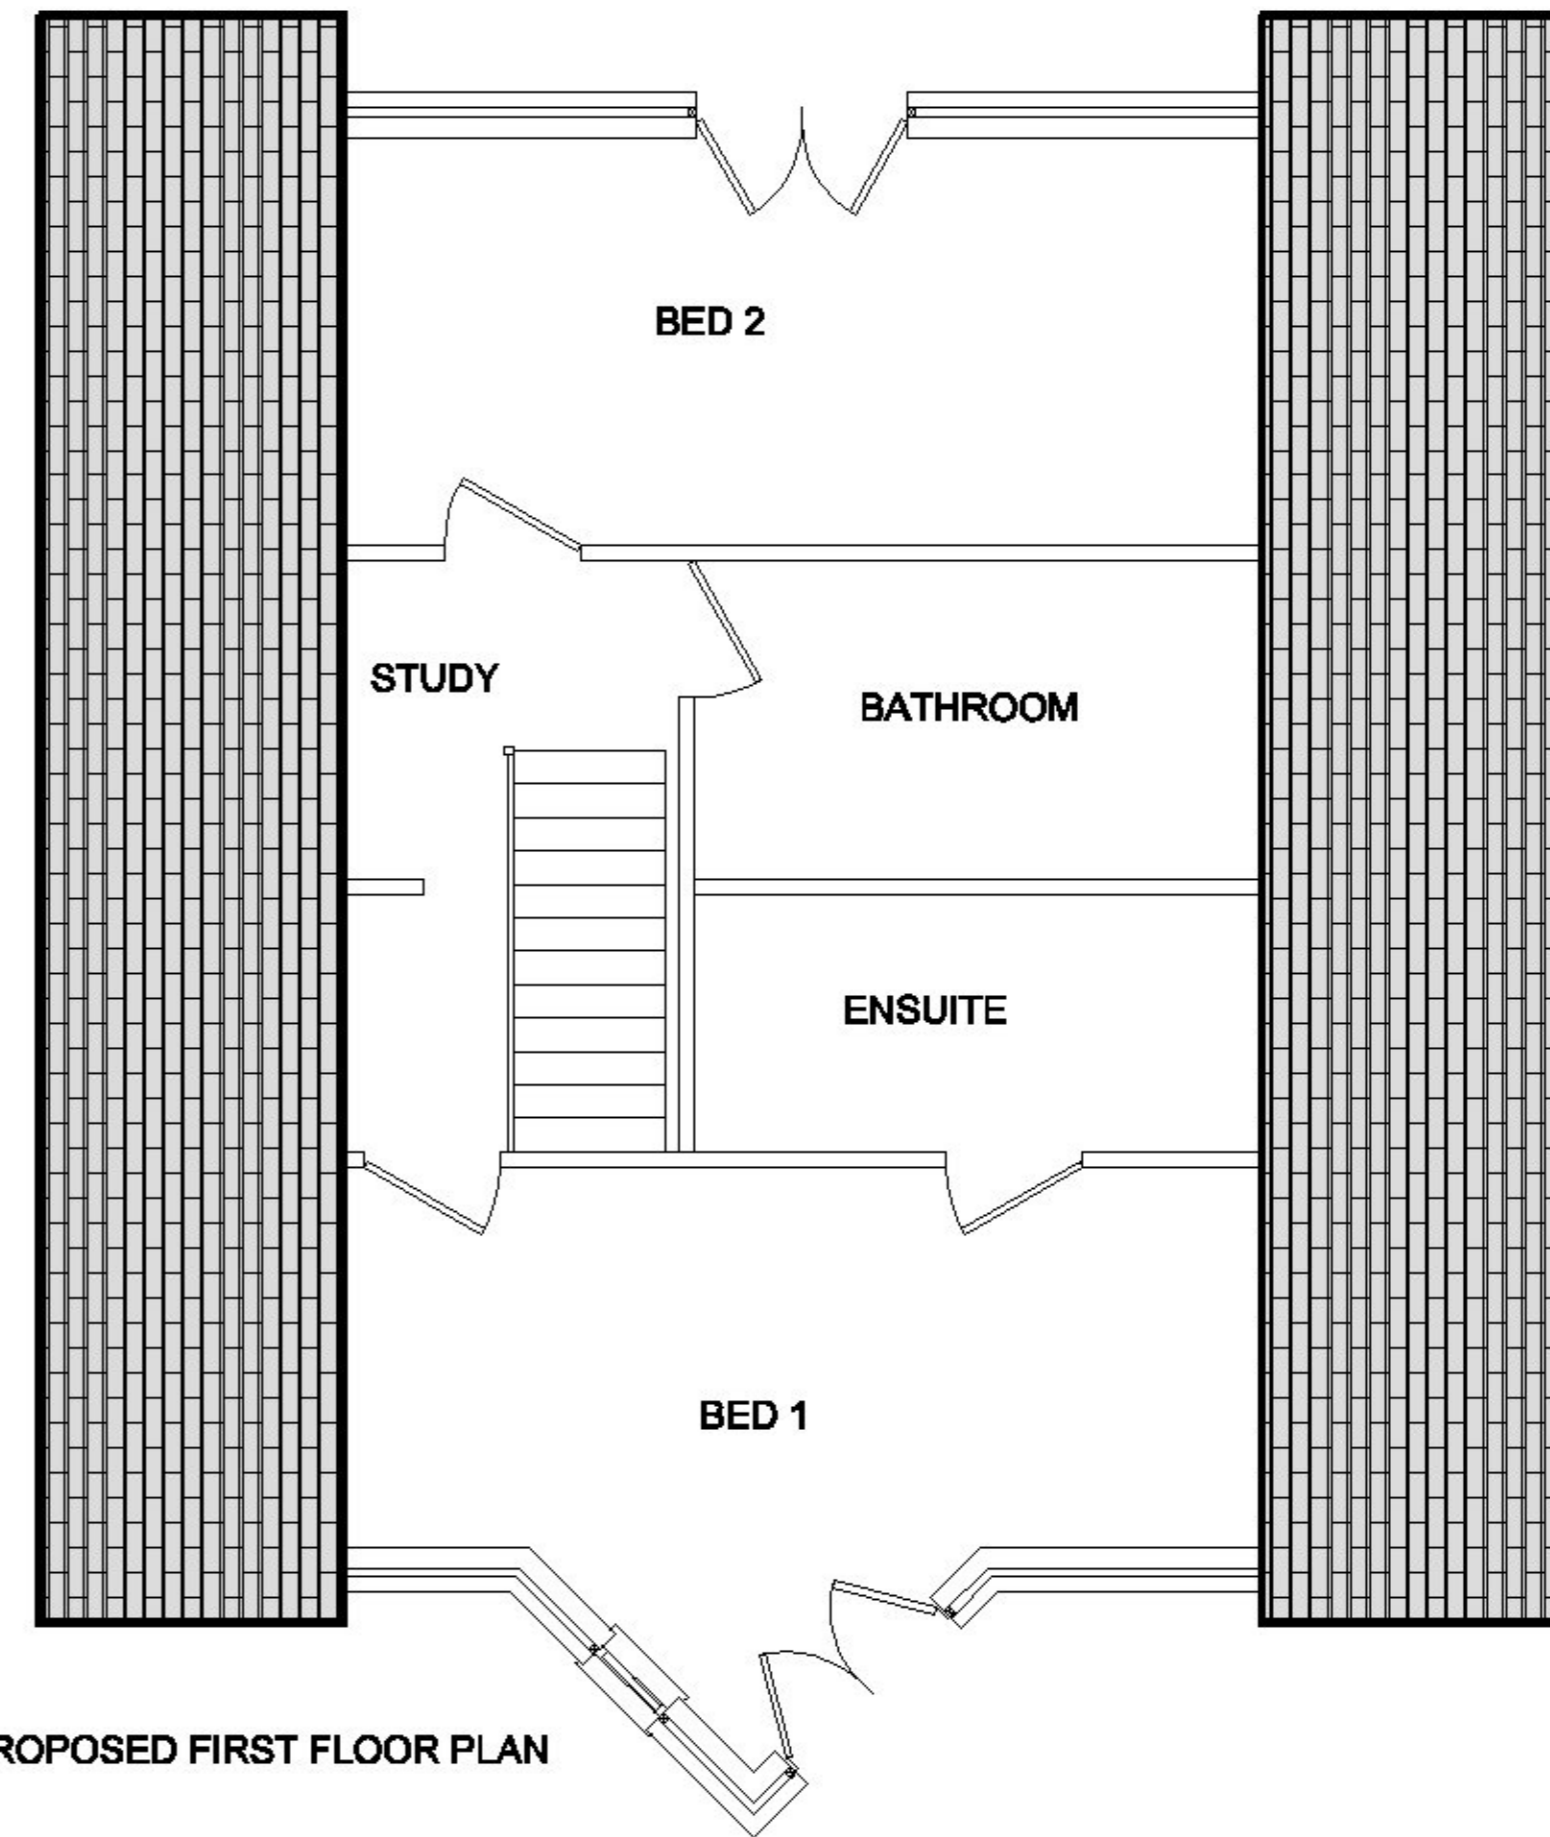

PROPOSED FIRST FLOOR PLAN

SCALE	TITLE
1:75@ A3	MINOR ALTERATIONS (FLOOR PLANS) No 8 PENWARE PARC CAMBORNE CORNWALL TR14 7QR
DATE	FOR Mr S LOVELOCK
20/04/2021	STATUS: PLANNING
JOB/DRAWING No	(Amendments shown in Red)
S LOVELOCK/P/02	