






EXISTING REAR (North East) ELEVATION
scale 1:100

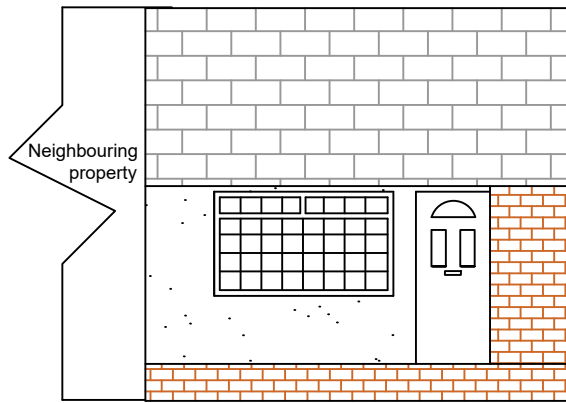

EXISTING FRONT (South West) ELEVATION
scale 1:100

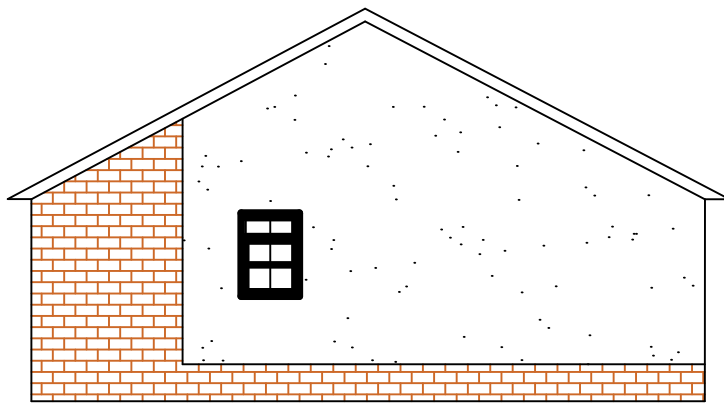

EXISTING GABLE (South East) ELEVATION
scale 1:100

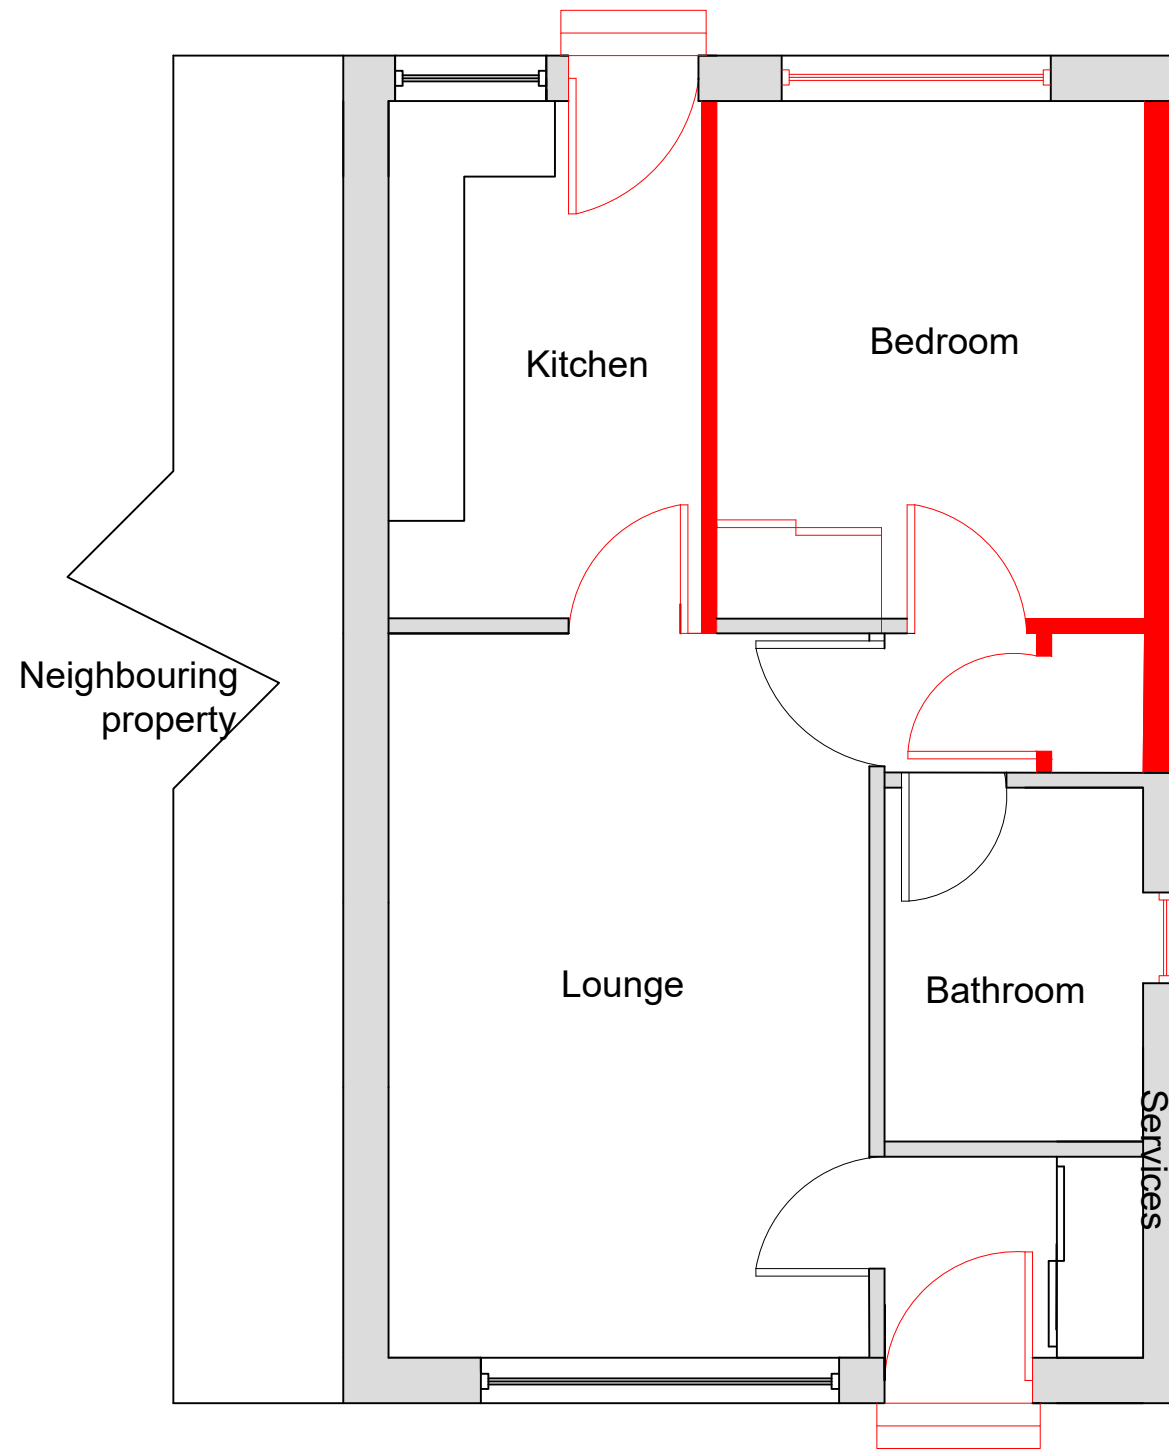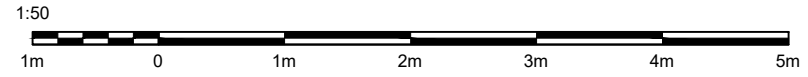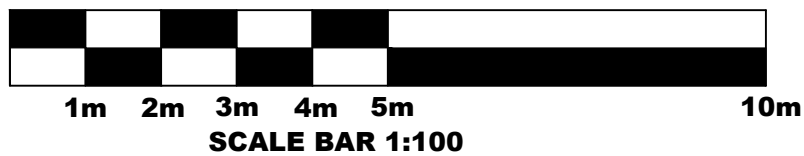

EXISTING GROUND FLOOR PLAN
scale 1:50
DOWN TAKINGS SHOWN IN RED

NOTES:

1. The contractor/subcontractors and suppliers are to verify all dimensions and levels on site prior to making fabrication drawings or commencing manufacture.
2. Do not scale from this drawing, only use figured dimensions.
3. All works to conform to relevant British Standards.
4. When required this drawing is to be read in conjunction with all relevant design drawings and specifications.

Client	C Menzies	
Title	65 Colwood Avenue Carswellbank Glasgow G53 7XT	
Title	Existing floor plan and elevations	
Issue status	Planning	
Drawn by	CM	Date April 2021
Drawing No.	201	Revision —