


FRONT ELEVATION

SIDE ELEVATION

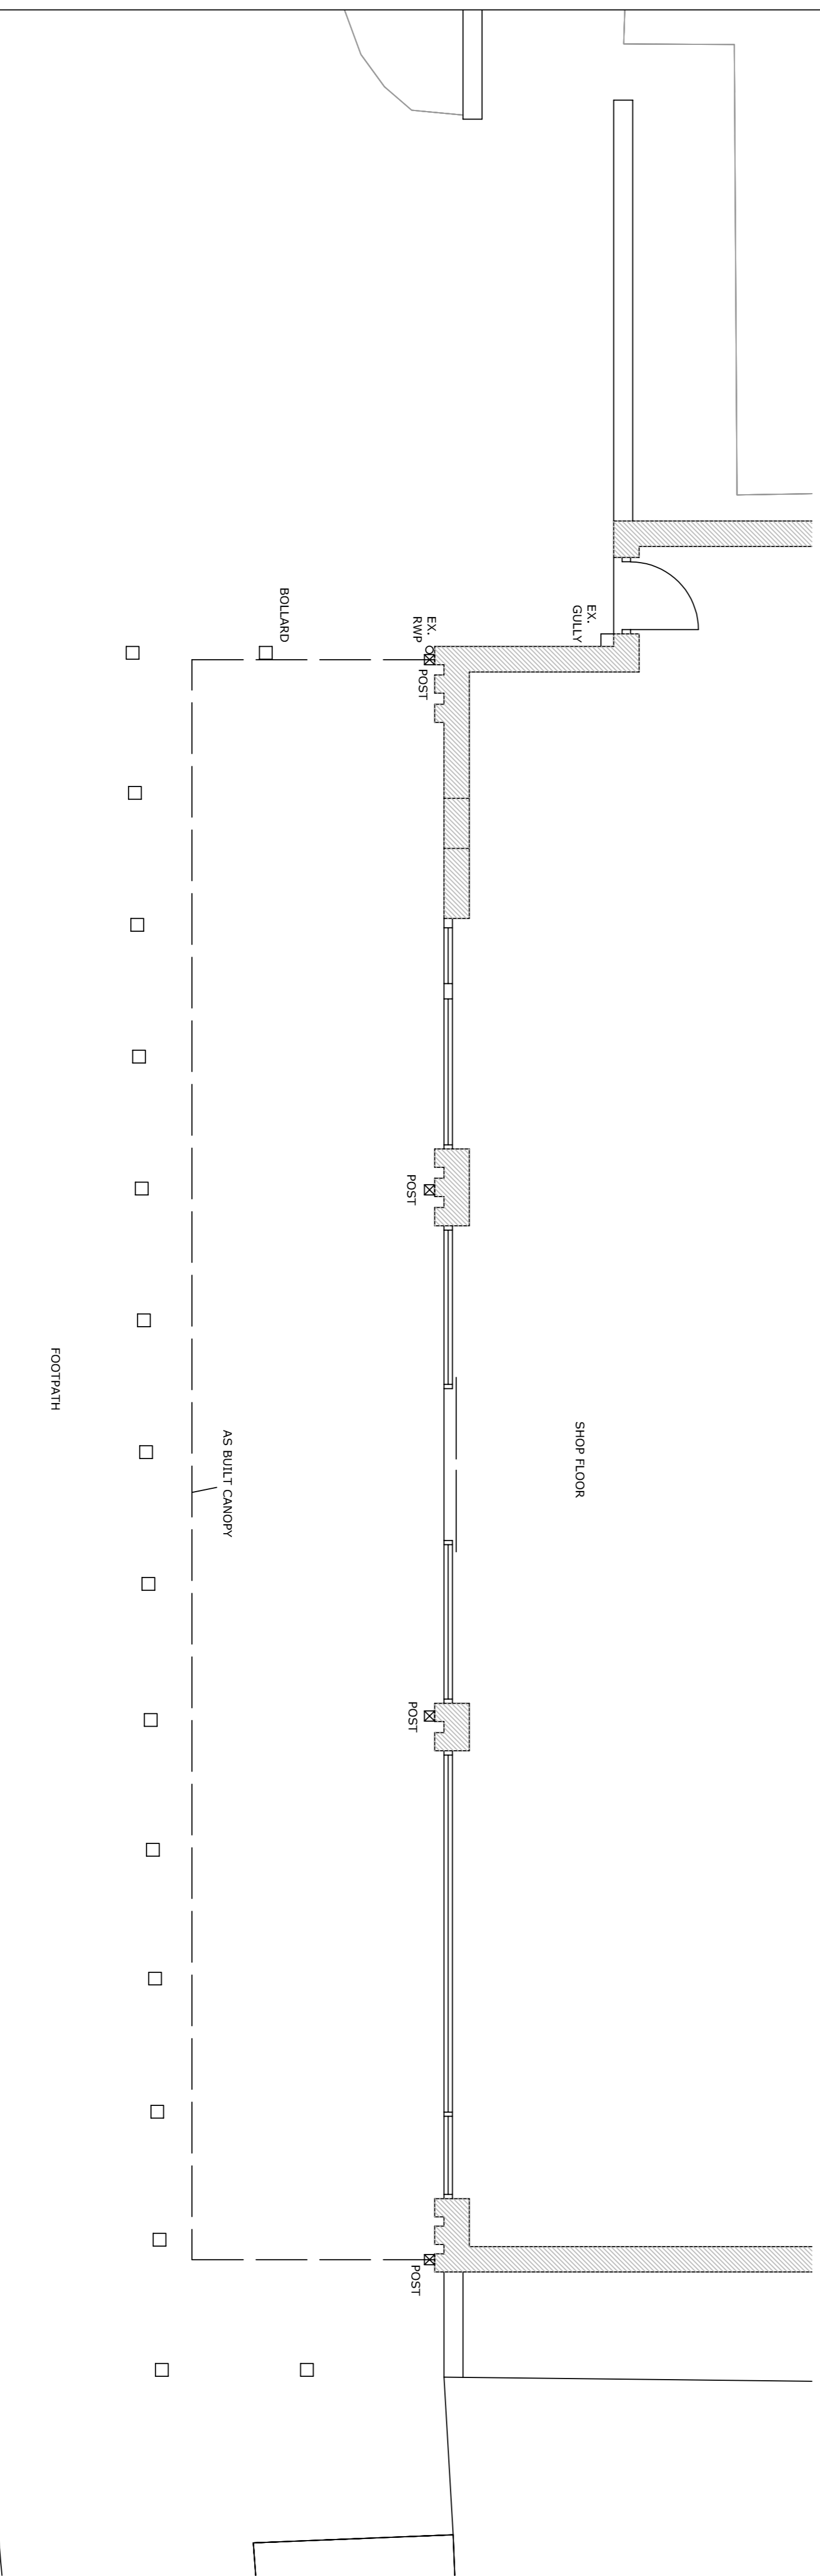

AS BUILT FLOOR PLAN

Rev. A, General revisions: 07.05.21

CLIENT	MR. J. KASHIR
PROJECT	RETROSPECTIVE FRONT CANOPY
ADDRESS	WIMMY FOODS 260 WILMSLOW ROAD FALLOWFIELD, MANCHESTER
TITLE	PLANS AS BUILT
DRAWING NO.	1528/ 2
SCALE	1 : 50
REVISION A	SUFFIX:
DATE	05.05.21

architectural services
knightpyatt
 Chartered since 1993

Tel: 01625 614447
 Email: knightpyatt@aol.com
 Website: www.knightpyatt.co.uk

24 Landseer Drive
 Macclesfield, Cheshire,
 SK10 2NP

A1