


Health & Safety Notes

1. Contractor must ensure that all work on site is carried out in a safe & satisfactory manner, in accordance with Health & Safety At Work Act 1974, COSHH Regulations 2002 & requirements of C.D.M

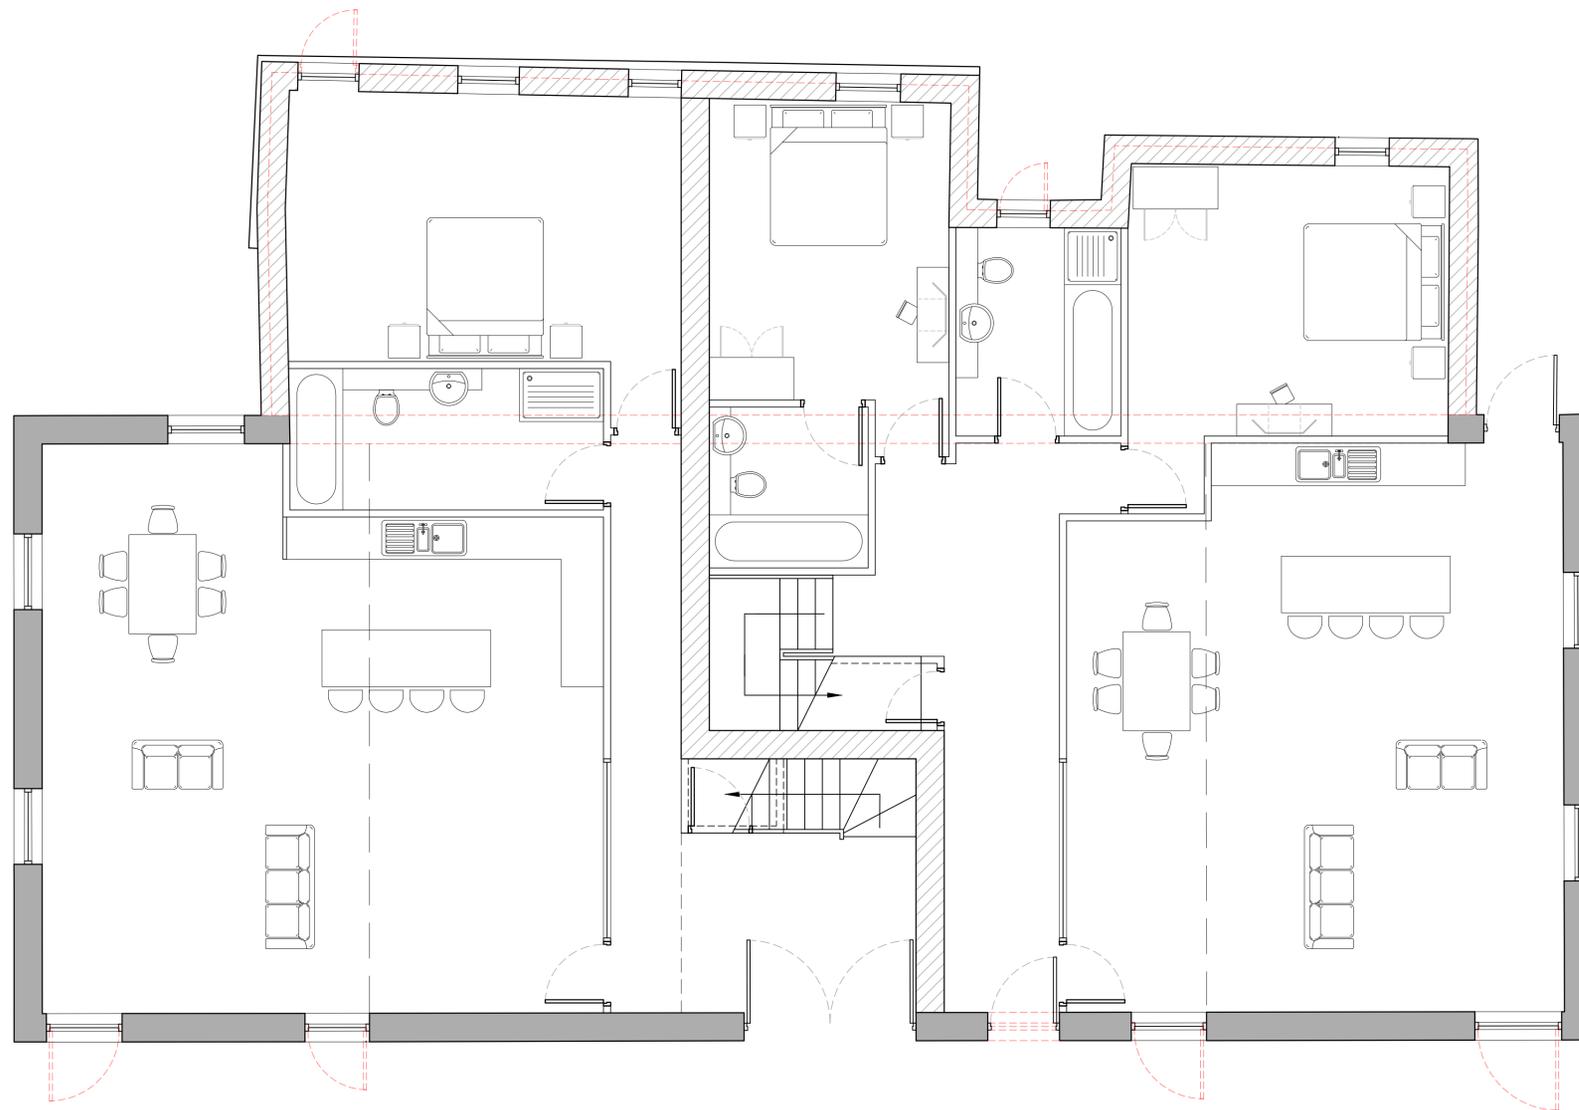

Proposed Ground Floor Plan

**DOTTED RED LINES INDICATE
ITEMS TO BE REMOVED**

P1	First Issue	18.09.2017
Rev.	Description	Date
Client		
Mr & Mrs Thompson		
Project		
Mixed Use Residential And Employment Scheme		
Drawing Title		
Proposed Ground Floor Plan		
Drawn by	JP	Checked by ND Date 18.09.2017
Status	PRELIMINARY	Scale @ A1 1:50
Job no.	Dwg no.	Rev.
9009	L07	P1
Cassidy+Ashton C+A www.cassidyashton.co.uk		
Architecture + Building Surveying + Town Planning		
7 East Cliff, Preston, Lancashire, PR1 3JE 01772 258 356 10 Harriers Walk, Canal Street, Chester, CH1 4EB 01244 402 900		