


- KEY**
 ZONE 01 : WYATT WING
 ZONE 02 : CENTRAL WING
 ZONE 03a : SERVICE COURTYARD WING
 ZONE 03b : SERVICE COURTYARD COTTAGES
 ZONE 04a : STABLES COURTYARD COTTAGES
 ZONE 04b : STABLES COURTYARD ANCILLERY
 ZONE 05 : TUNNEL
 ZONE 06 : GATEHOUSES

SITE LOCATION PLAN WITH ZONES
 1:2500

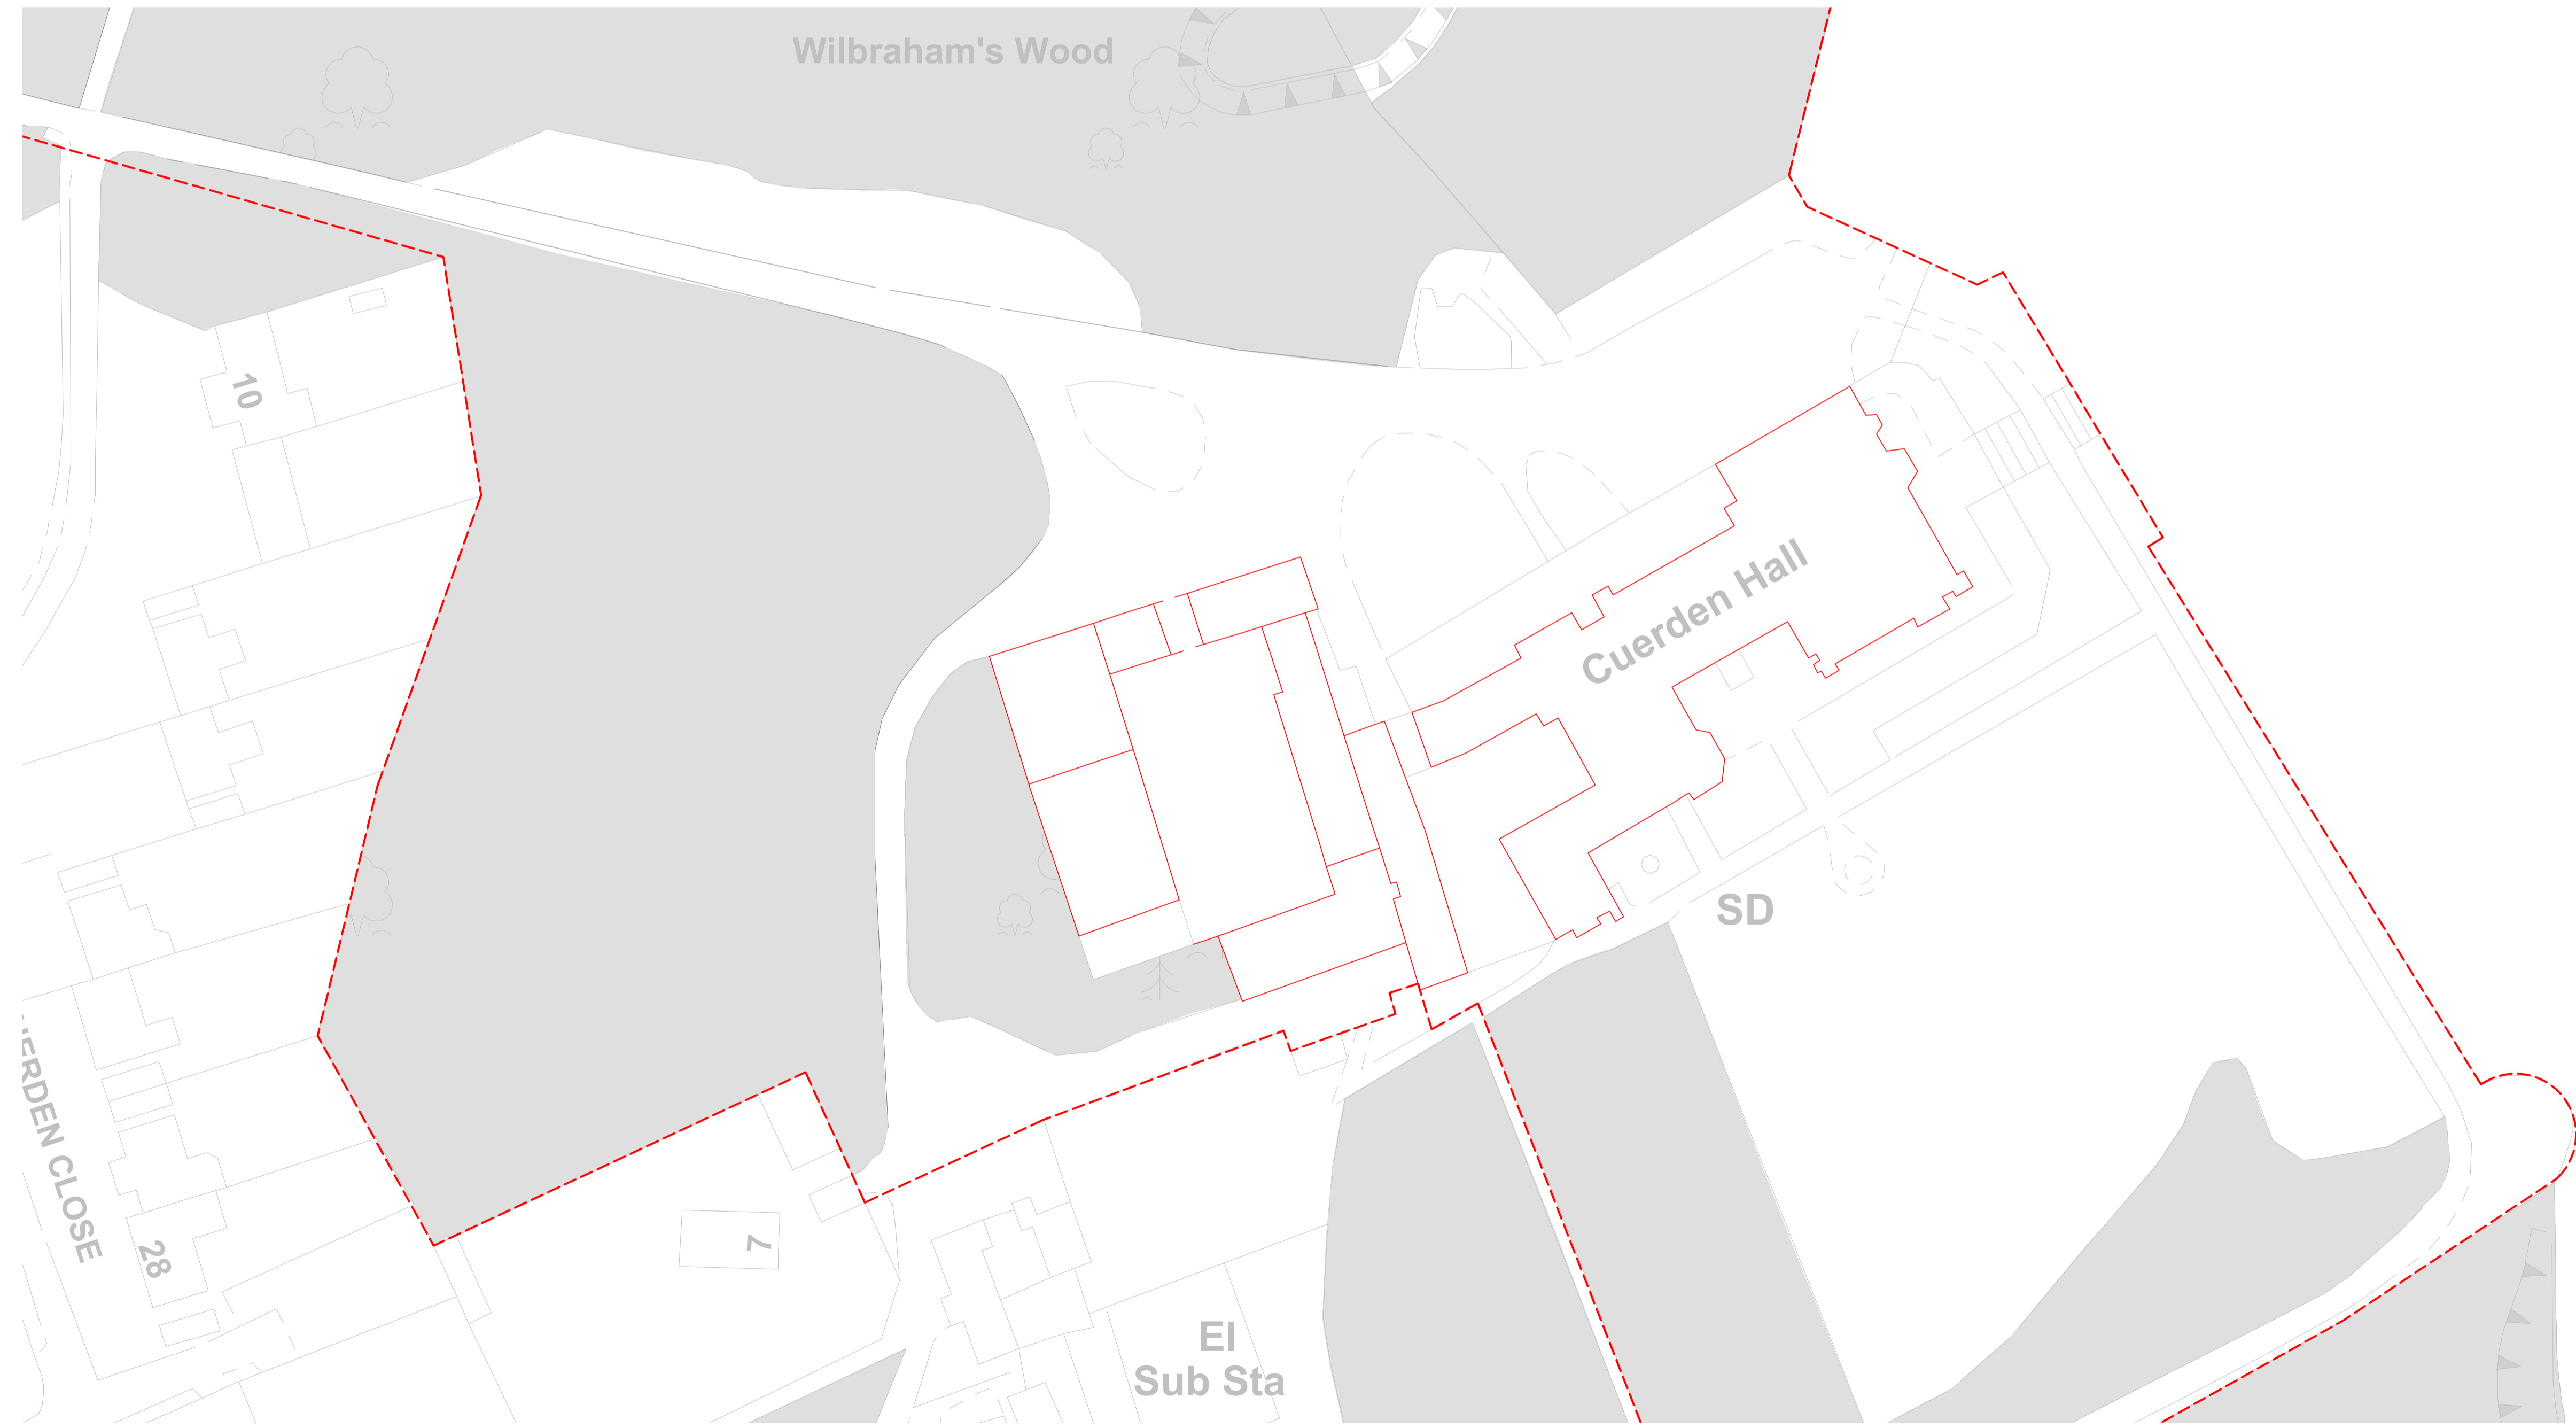

SITE PLAN
 1:500

GENERAL NOTES:

1. THIS DRAWING IS TO BE READ IN CONJUNCTION WITH ALL RELEVANT ARCHITECTS AND ENGINEERS DRAWINGS AND SPECIFICATIONS.
2. DO NOT SCALE THIS DRAWING. ANY AMBIGUITIES, OMISSIONS AND ERRORS ON DRAWINGS SHALL BE BROUGHT TO THE ENGINEERS ATTENTION IMMEDIATELY. ALL DIMENSIONS MUST BE CHECKED / VERIFIED ON SITE.
3. ALL DIMENSIONS ARE IN MILLIMETRES UNLESS NOTED OTHERWISE.
4. FOR GENERAL NOTES REFER TO DRAWING.

Rev.	Description	Date	By	Chkd.



28 Lowther St Kendal, Cumbria, LA9 4DH
 01539 724823
 kendal@curtins.com
 www.curtins.com

Structures • Civils • Environmental • Infrastructure • Transport Planning • Sustainability • Expert Advisory Services
 Birmingham • Bristol • Cardiff • Douglas • Dublin • Edinburgh • Glasgow • Kendal • Leeds • Liverpool • London • Manchester • Nottingham

Status: **FOR COORDINATION**

Client: **SHENTON GROUP**

Project: **CUERDEN HALL**

Dwg Title: **SURVEY RECORD DRAWINGS, SITE PLANS**

Project No:	Size:	Date:	Drawn By:	Designed By:	Checked By:
077572	A1	01/02/2021	SJ	SJ	DC

Project Code: Originator: Zone: Level: Type: Discipline: Category / Number: Rev:
 077572 - CUR - ZZ - ZZ - DR - S - 20001 - 01

I:\Projects\077572_Cuerden Hall\04_Productions\A-Modes-Drawings\CAD