
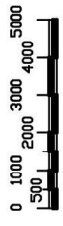


E _____ approximate W

Red lines indicate 25 degree vertical angle

Blue lines indicate proposed alterations to lines of roof

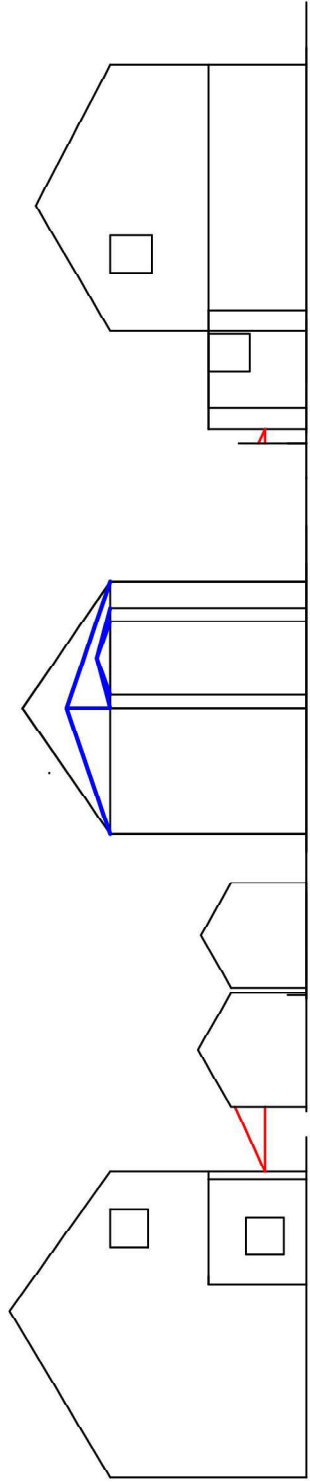

Scale Bar

25 degree vertical angles indicate existing buildings already act to obscure the line of sight.

Revision 1. 6th June 2021 - scale bar added.

44 Bakers Lane PR9 9RN	
Rear Elevation showing 25 degree vertical angles	
W Howard Engineering 4 Nerdel Court, 10A Leicester St, Southport PR9 0EZ	
Drawn by	W D Howard
Scale	1:200
Drawn Date	21-May-2021
Drwg No	
of	
Paper size	A4
6-Jun-2021	Rev
	1