



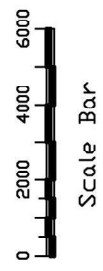

Red lines indicate 45 degree horizontal angle

Blue lines indicate proposed alterations to lines of roof

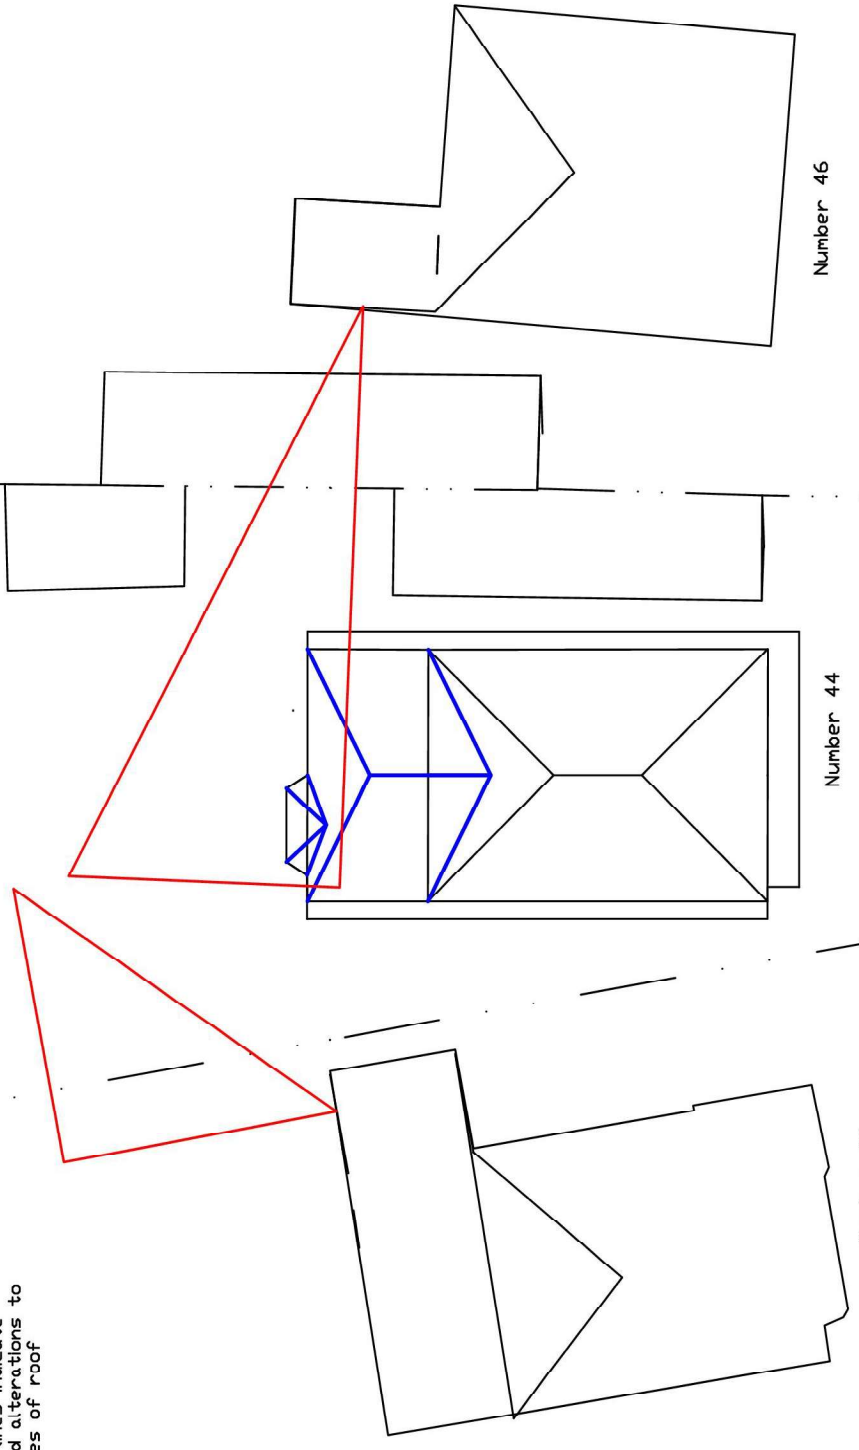

Plan indicates existing building obscures 45 degree lines of sight at lower storey prior to the proposed modifications to the rear roof at Number 44.

Revision 1. 6th June 2021 - scale bar added.

44 Bakers Lane PR9 9RN	
Plan showing 45 degree lines for sunlight study	
W Howard Engineering 4 Mendel Court, 10A Leicester St, Southport PR9 0EZ	
Drawn by	W D Howard
Scale	1:200
Drawn Date	21-May-2021
Paper size	A4
Rev	1