


NOTES
 This drawing is the copyright of loop design. It must not be copied or reproduced without written consent. Only figured dimensions are to be taken from this drawing. All contractors must visit the site and be responsible for taking and checking all dimensions related to the works shown on this drawing.

Rev	Description	Date
a	red line extended to include drive and existing sewage treatment plant	180620
b	studio and connecting porch and 75% of veranda removed	180825
c	amended proposal	210210

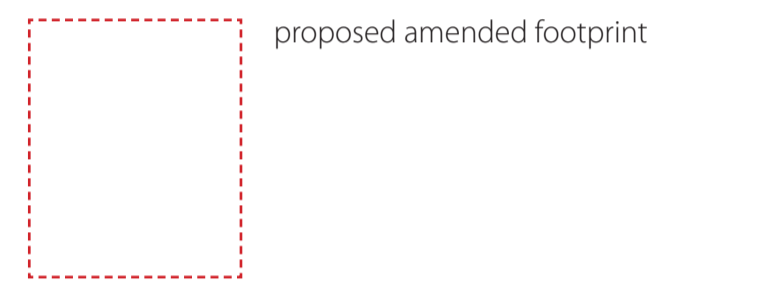

CLIENT
 DR C & J ROBINSON

PROJECT
 BALE HOUSE, SANDERS FARM

DRAWING TITLE
 PROPOSED SITE PLAN

DRAWN BY RNM	CHECKED BY Checker	DATE 06/09/16
SCALE (@ A1) 1:100	PROJECT NUMBER 156	REV C
DRAWING NUMBER 156 PL- 200		

PURPOSE OF ISSUE

loop design
 BUILT ENVIRONMENT

TREGONJOHN COTTAGE CREED CORNWALL TR2 4SN
 07469792916