

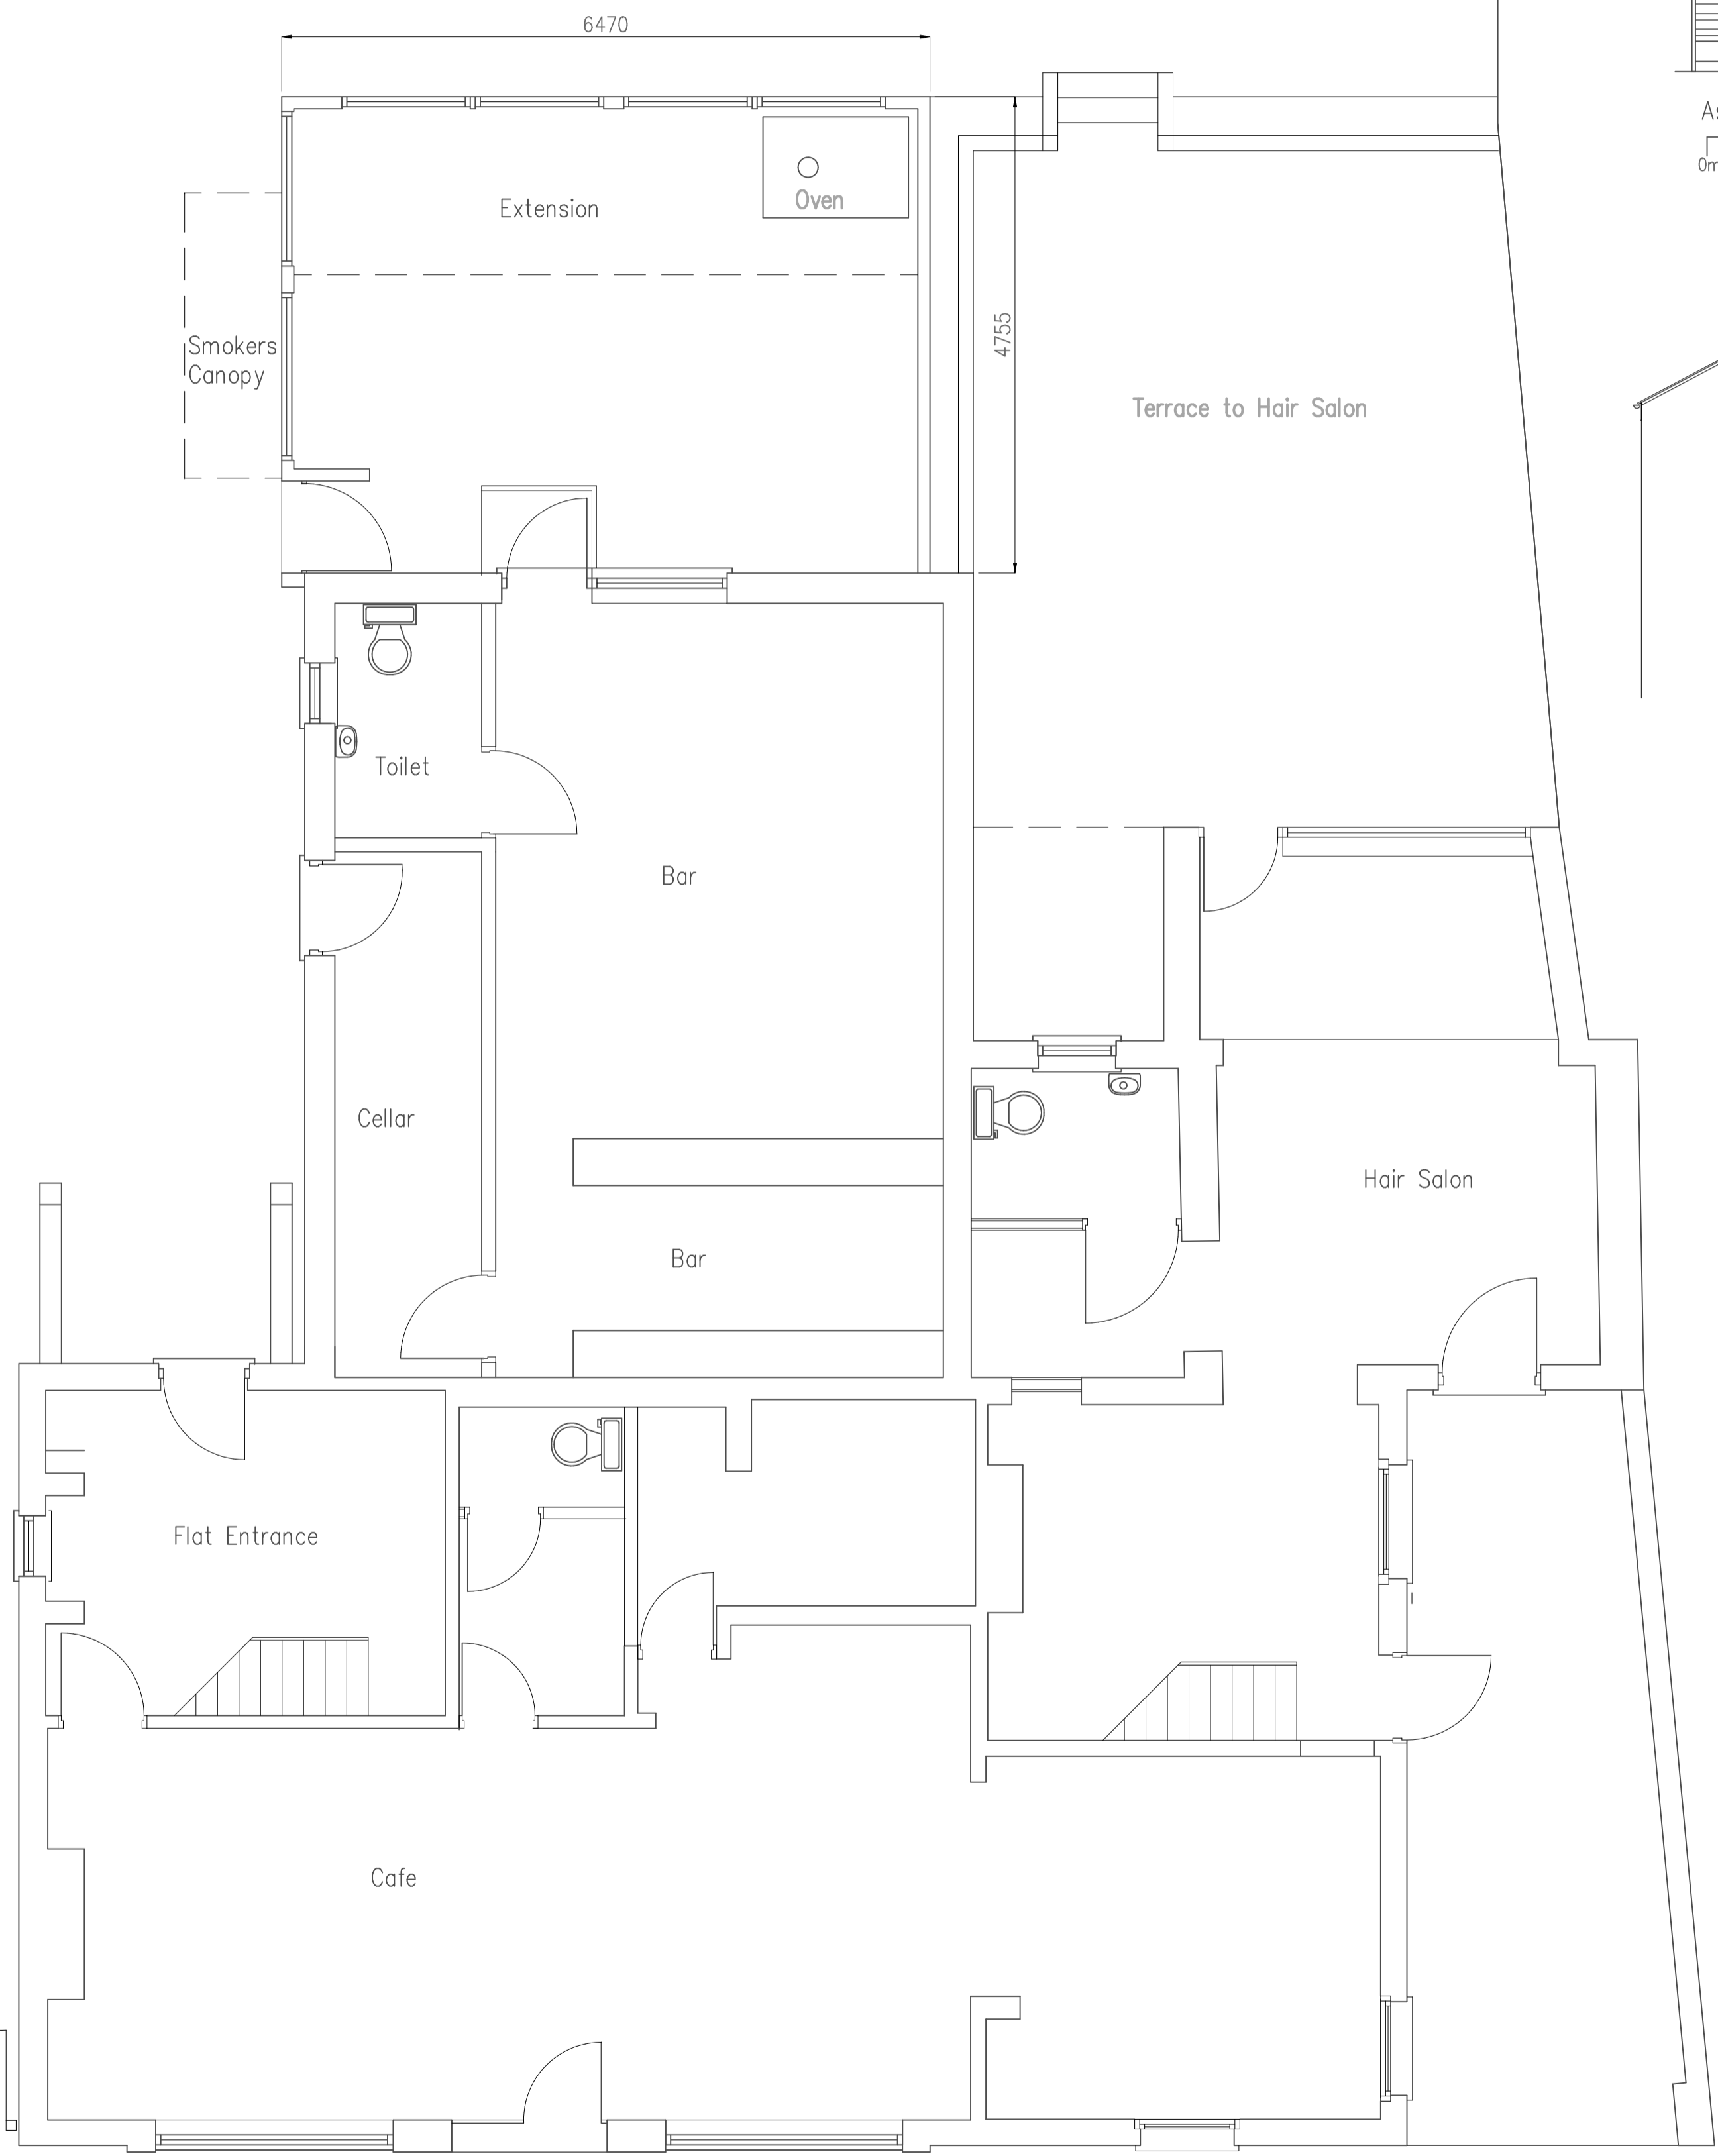
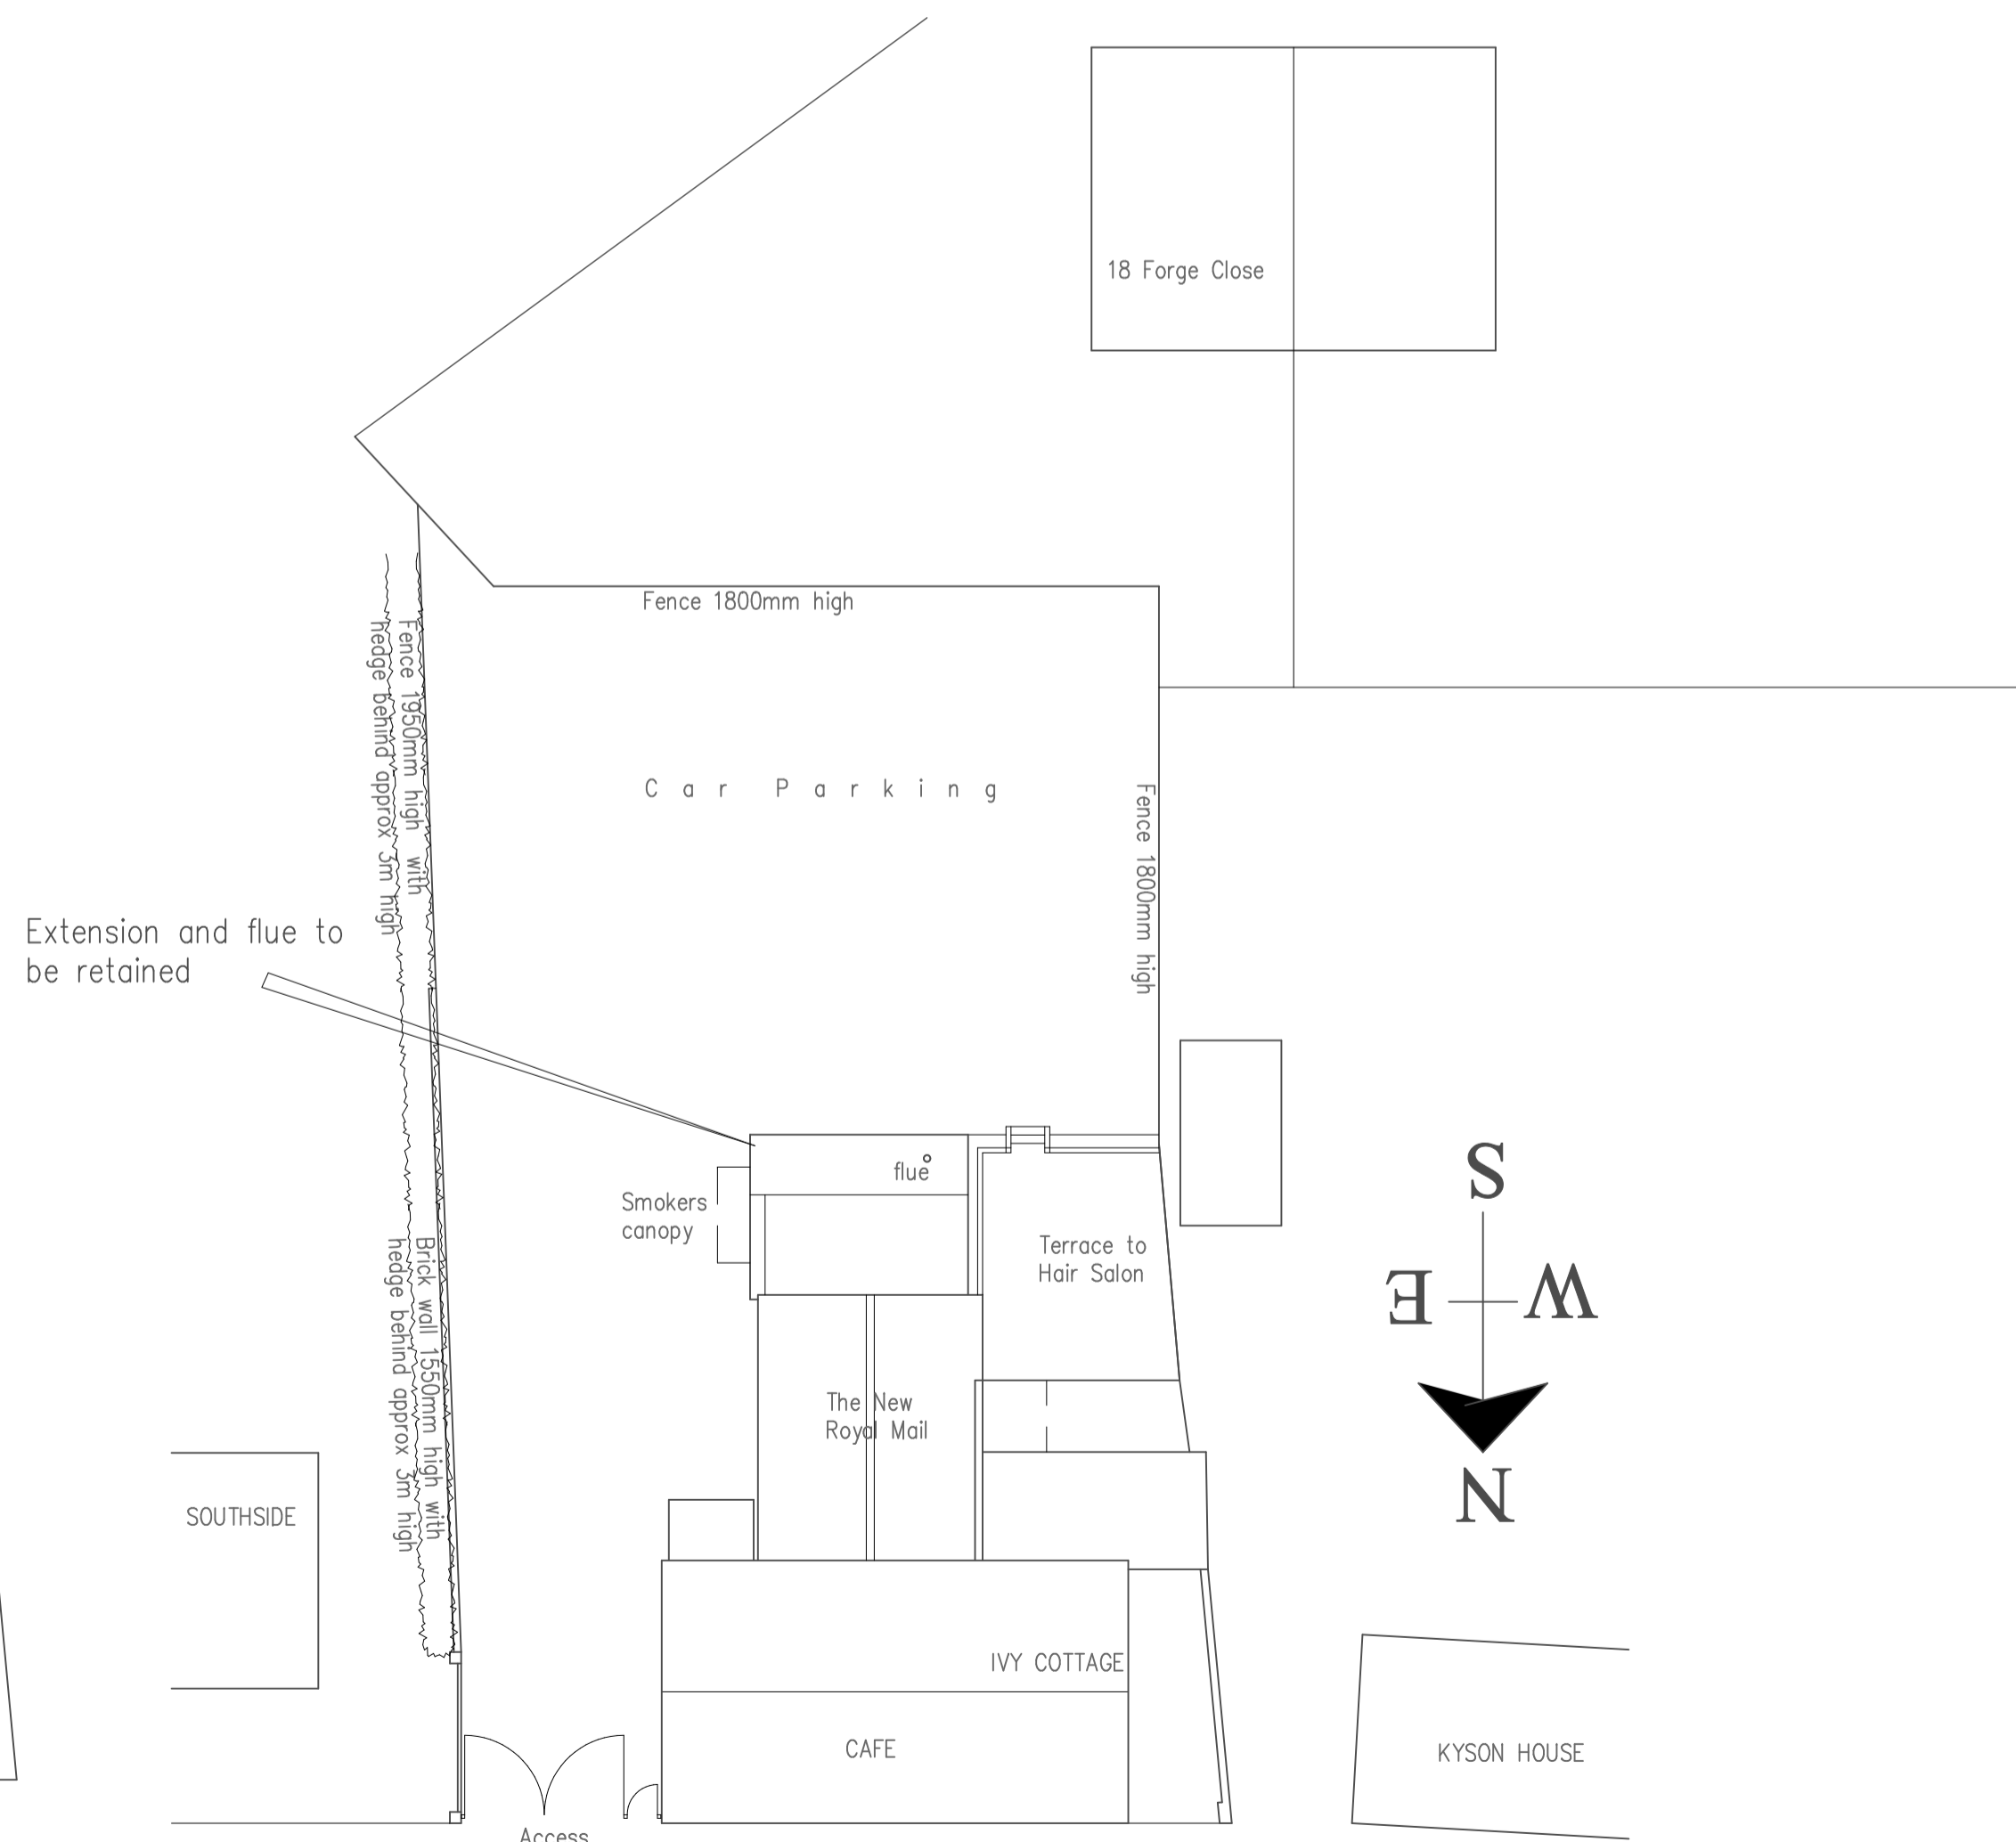



All Dimensions Shall be Checked on Site by the Contractor Prior to Commencement of Work on Site. Do Not Scale If in Doubt Ask.

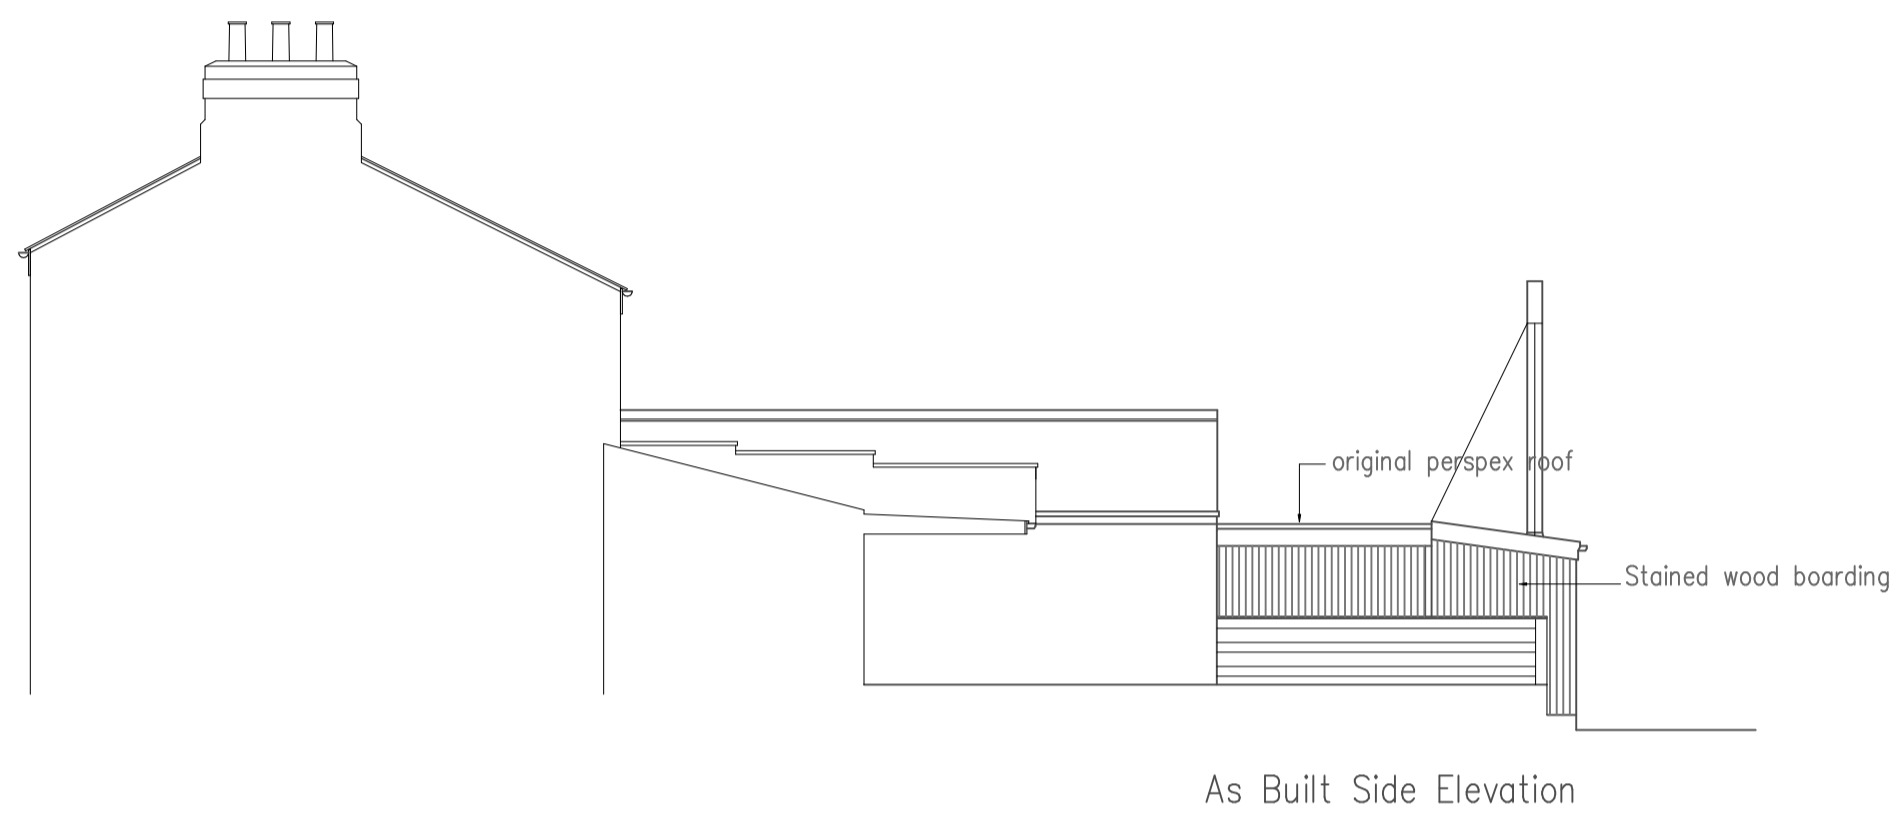

As Built Floor Plan 1:50

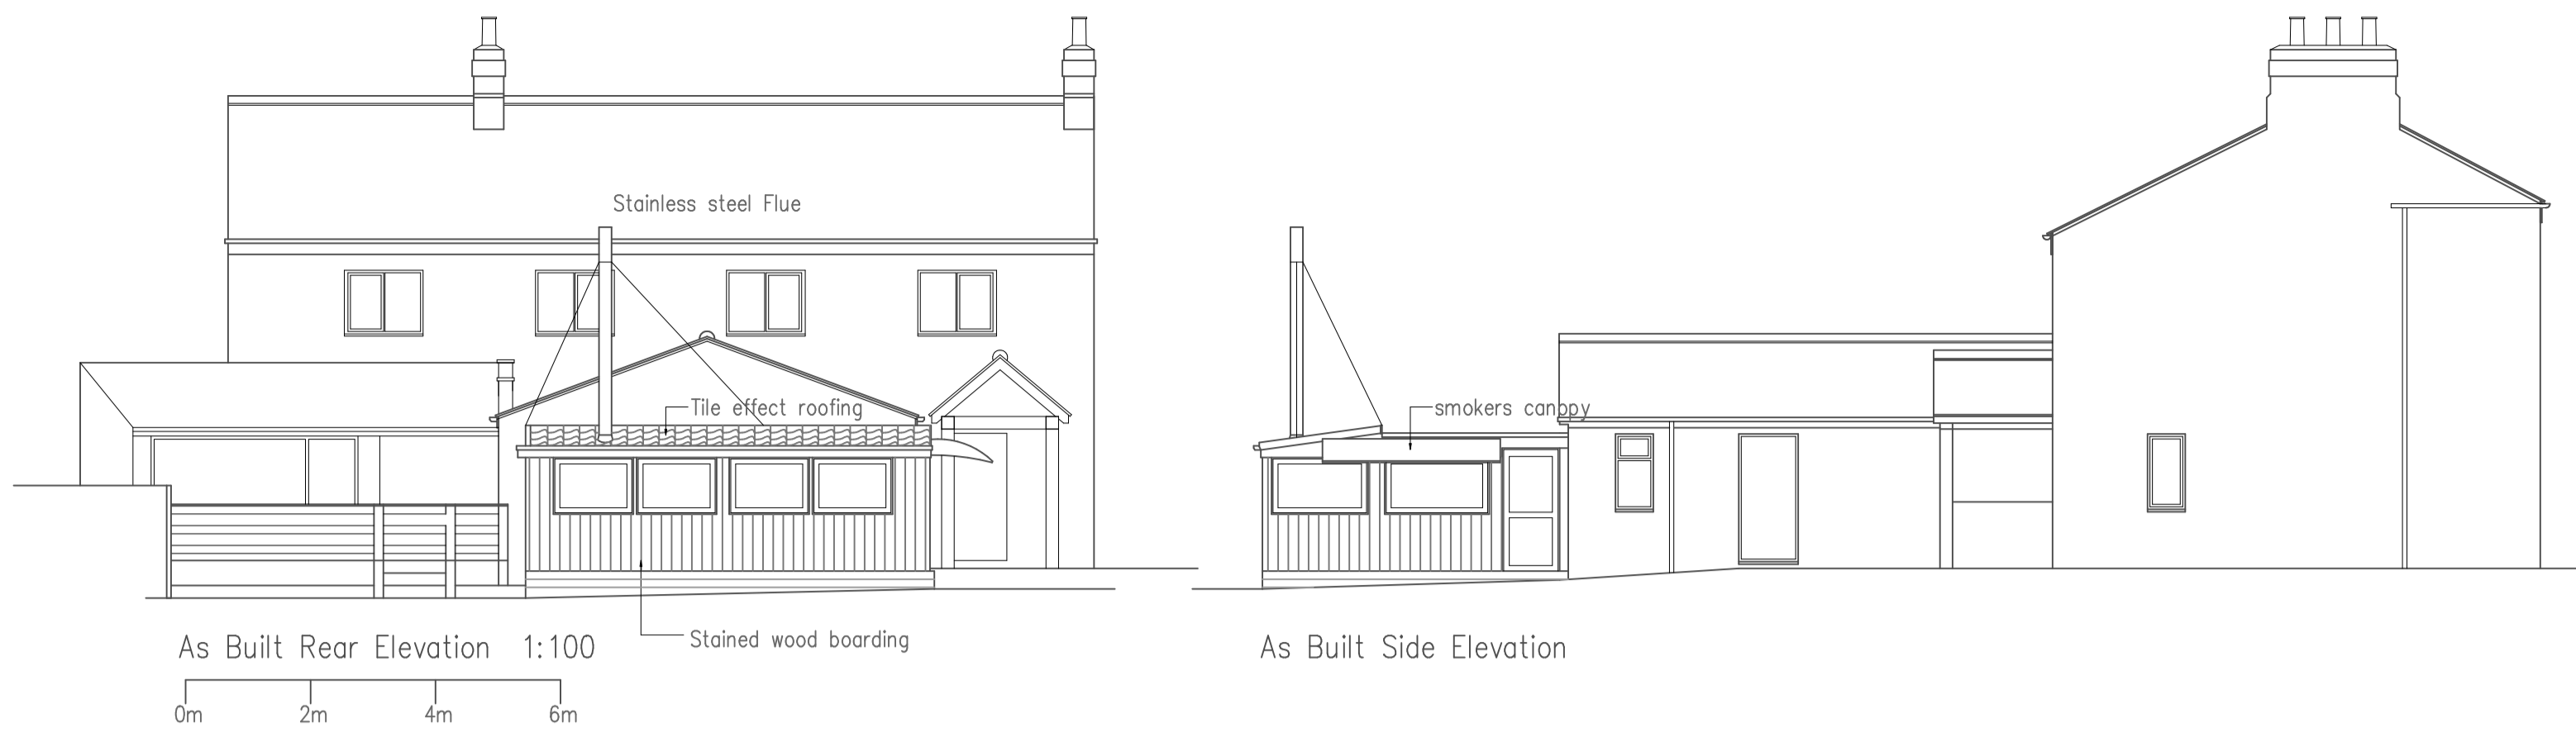

As Built Block Plan Scale 1:200

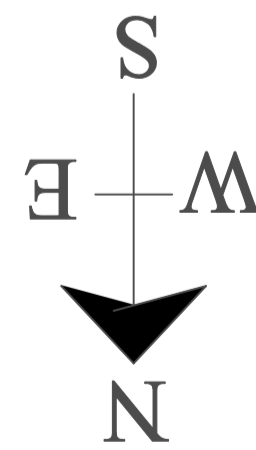

Scales correct when printed at A1

A: Changed form proposed to As Built May 26th 2021

Rev	Date
STEVEN RUSSELL LTD	
Architectural Services 94 Main Road, Thorngumbald.HU12 9LN.	
tel : 01964 624108	
Job Title : As Built Details	
Retention of extension to The New Royal Mail Public House, Main Road, Thorngumbald..	
Client ; Mr P Smith	
Date : 4/4/21	Scales 1:50, 1:100, 1:200
Drg No	1A