






1 Elevation 01
1 : 100

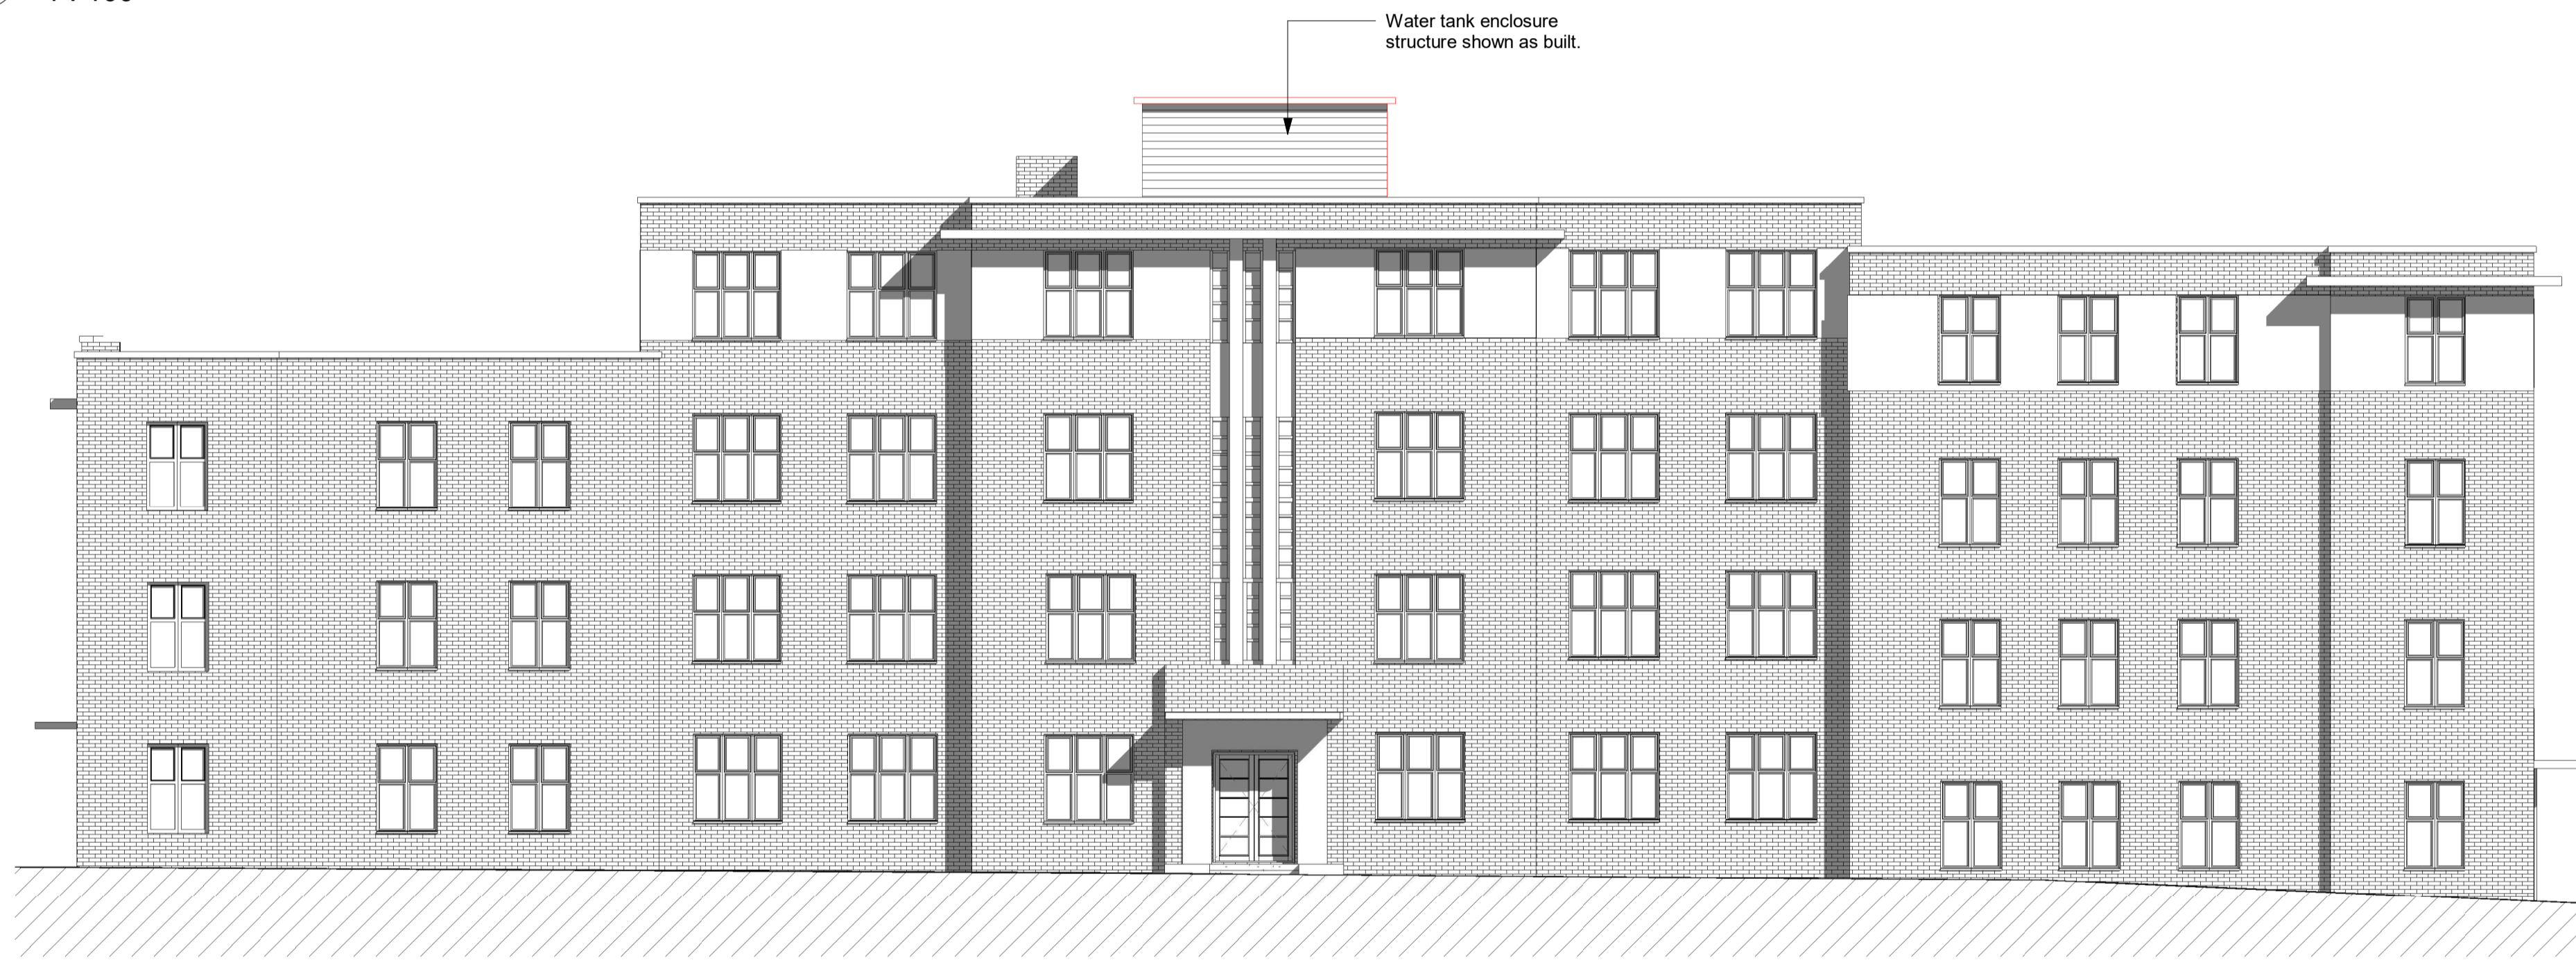


2 Elevation 02
1 : 100

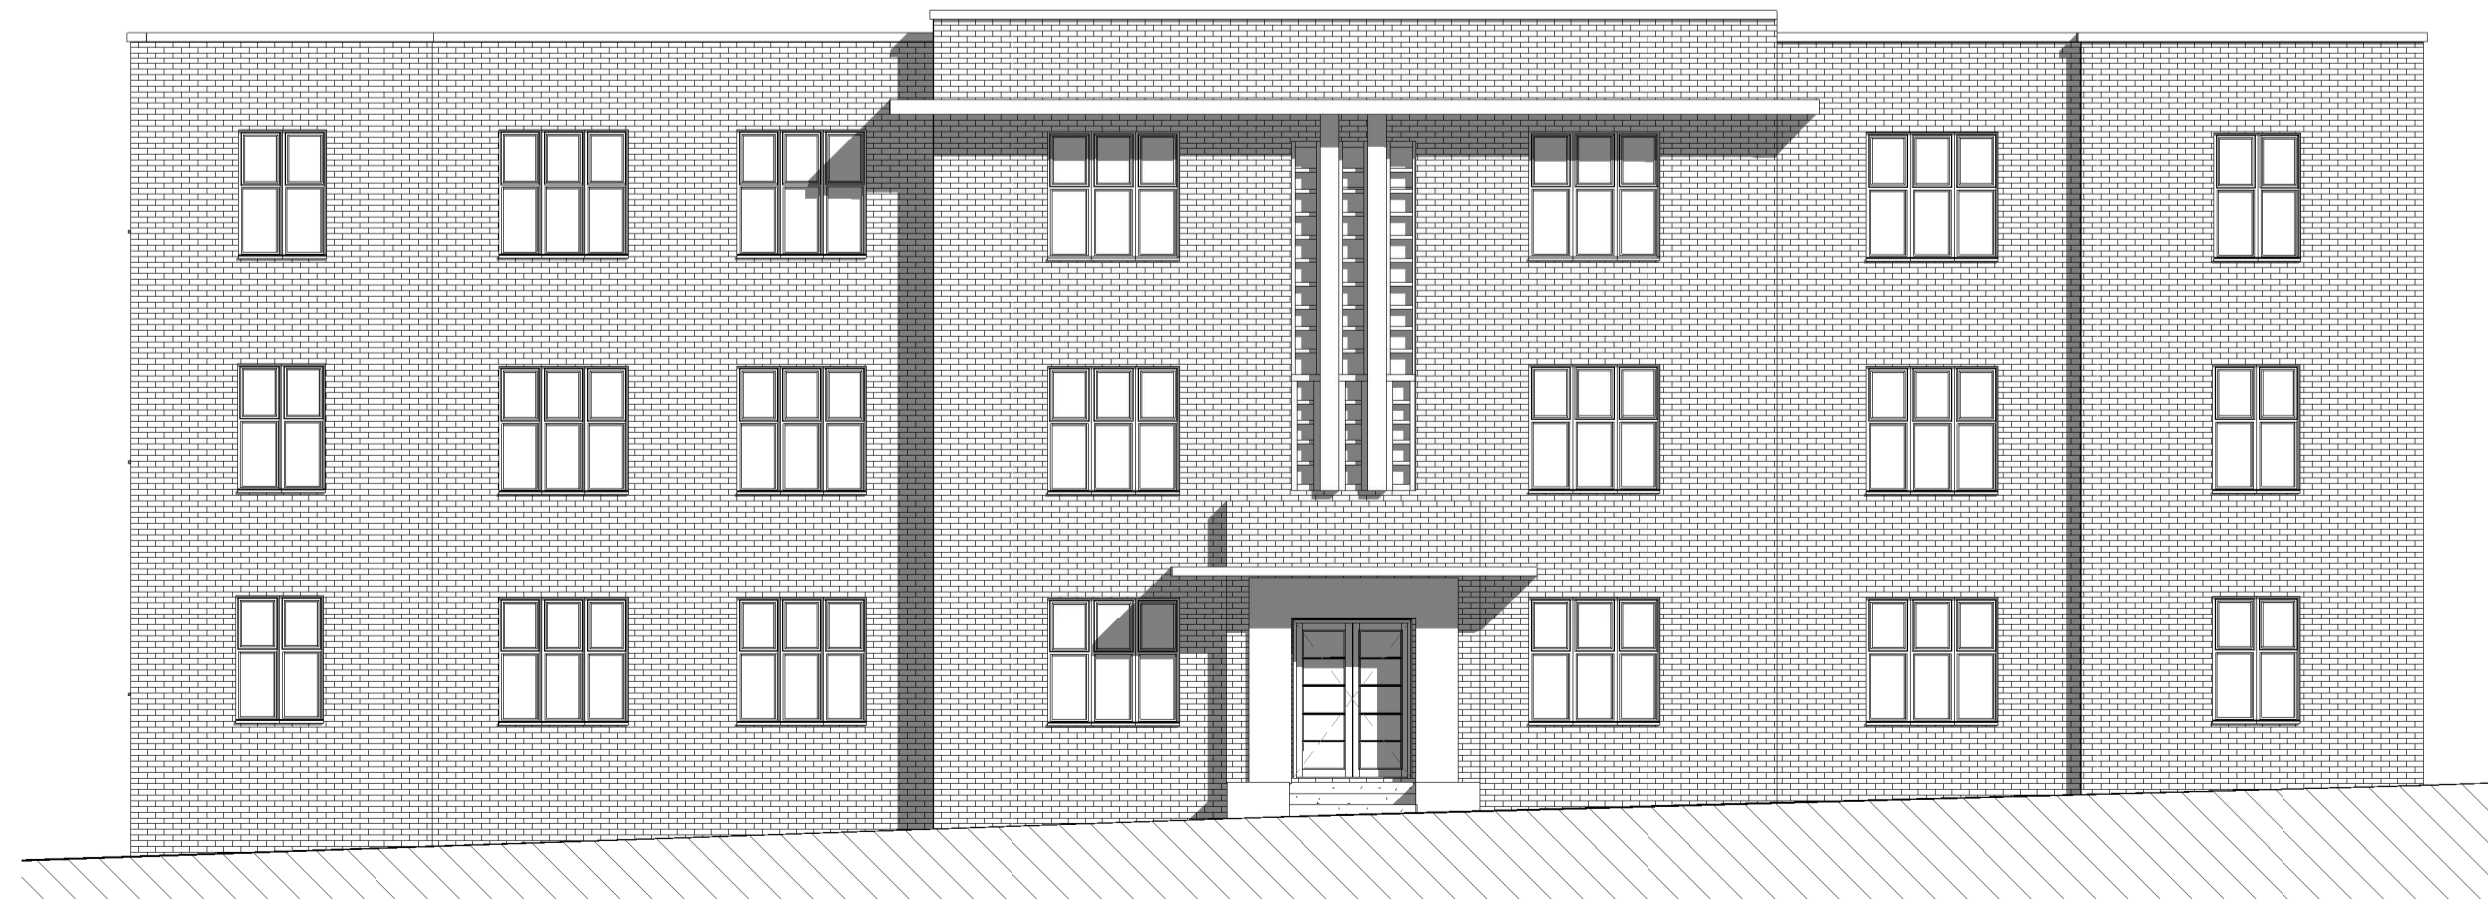



3 Elevation 03
1 : 100

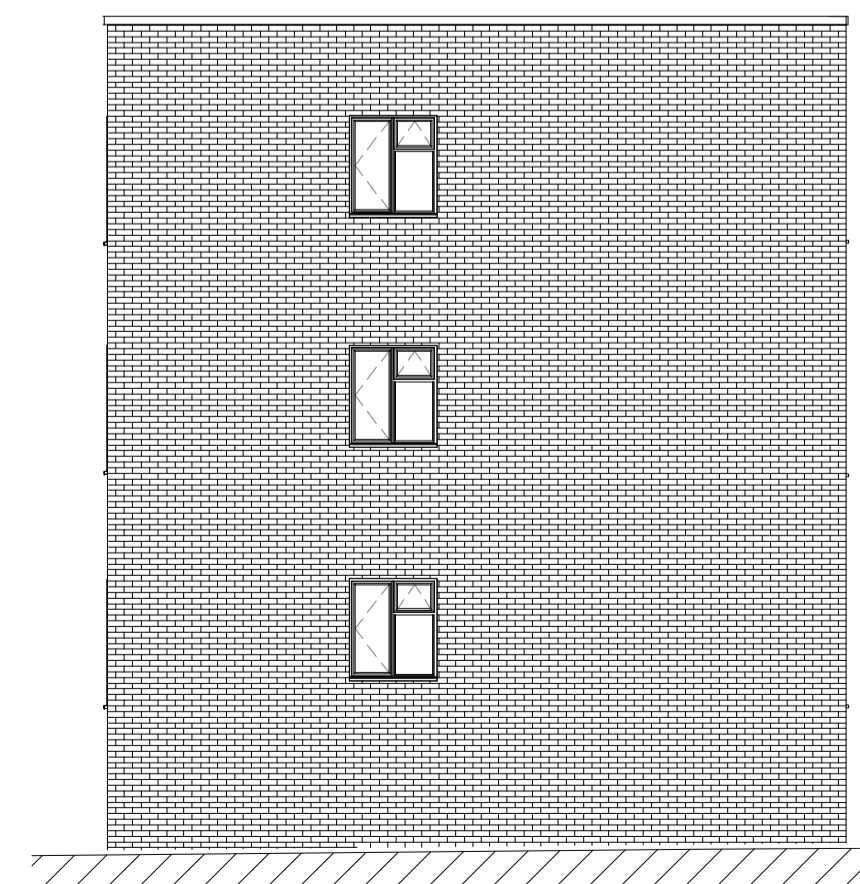


5 Elevation 04
1 : 100

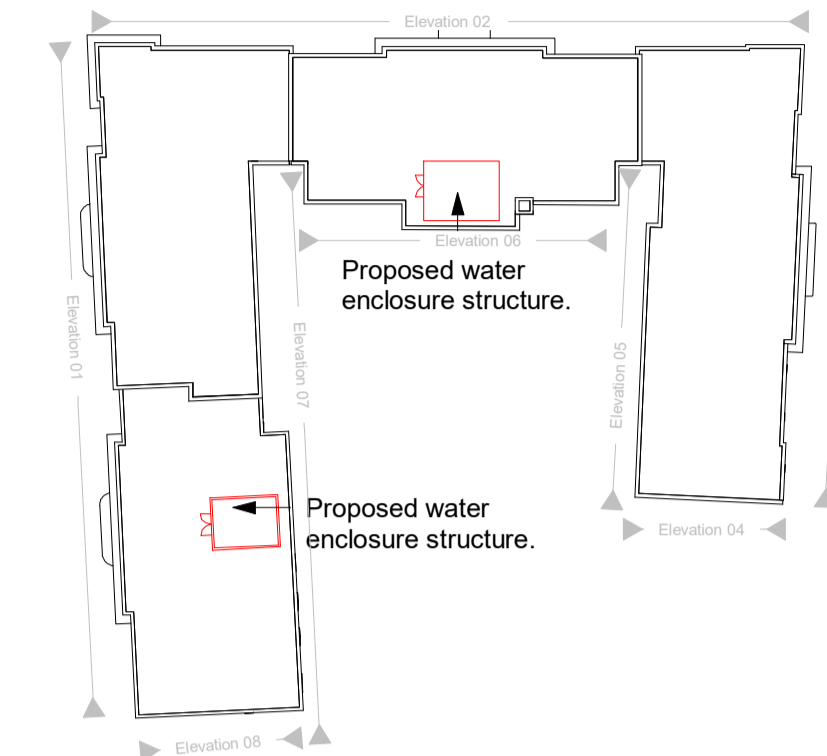

4 Proposed Ref Plan
1 : 500

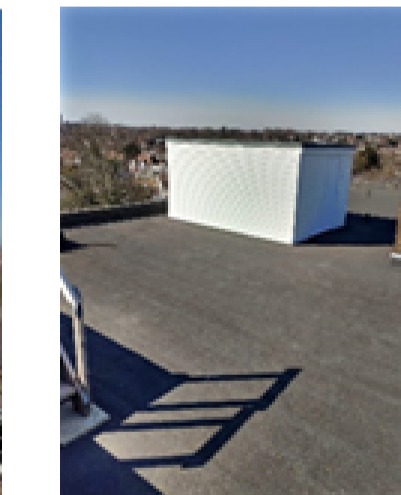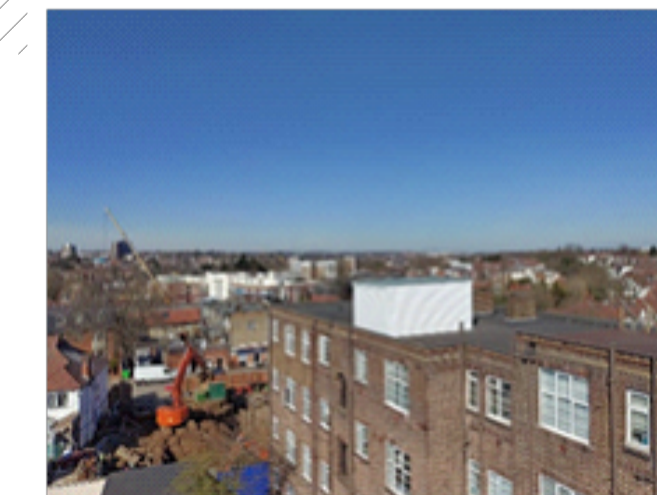

Revision	Date	Comment

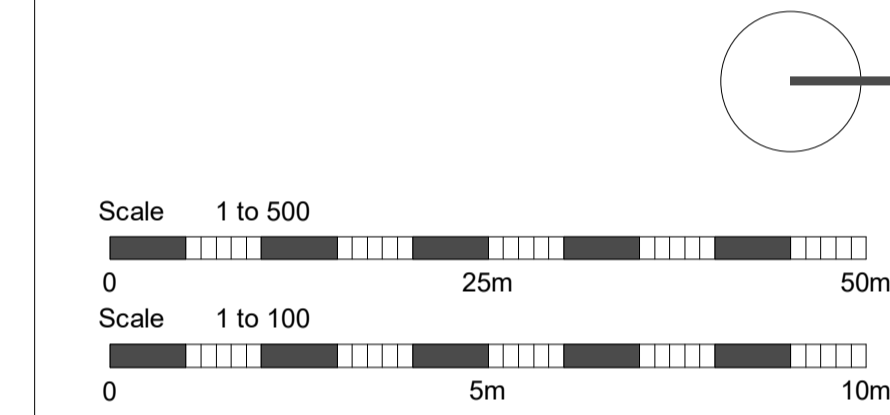

3 Sherman Walk, London SE10 0YJ
Tel: 020 8777 7700
Email: laura.dumitru@blakeneyleigh.co.uk

Client
Fresh Property Management

Property
31 - 60 Windsor Court Golders Green Rd, London NW11 9PR

Project
Water Tanks Enclosures

Drawing Title
Existing Elevations As Built 1 of 2

Drawn By L Dumitru	Date JUNE 2021
-----------------------	-------------------

Scale @ A1 As indicated	Drawing No. FPM035/01
----------------------------	--------------------------

Checked By NG	Revision No.
------------------	--------------