



1 Elevation 05
1 : 100

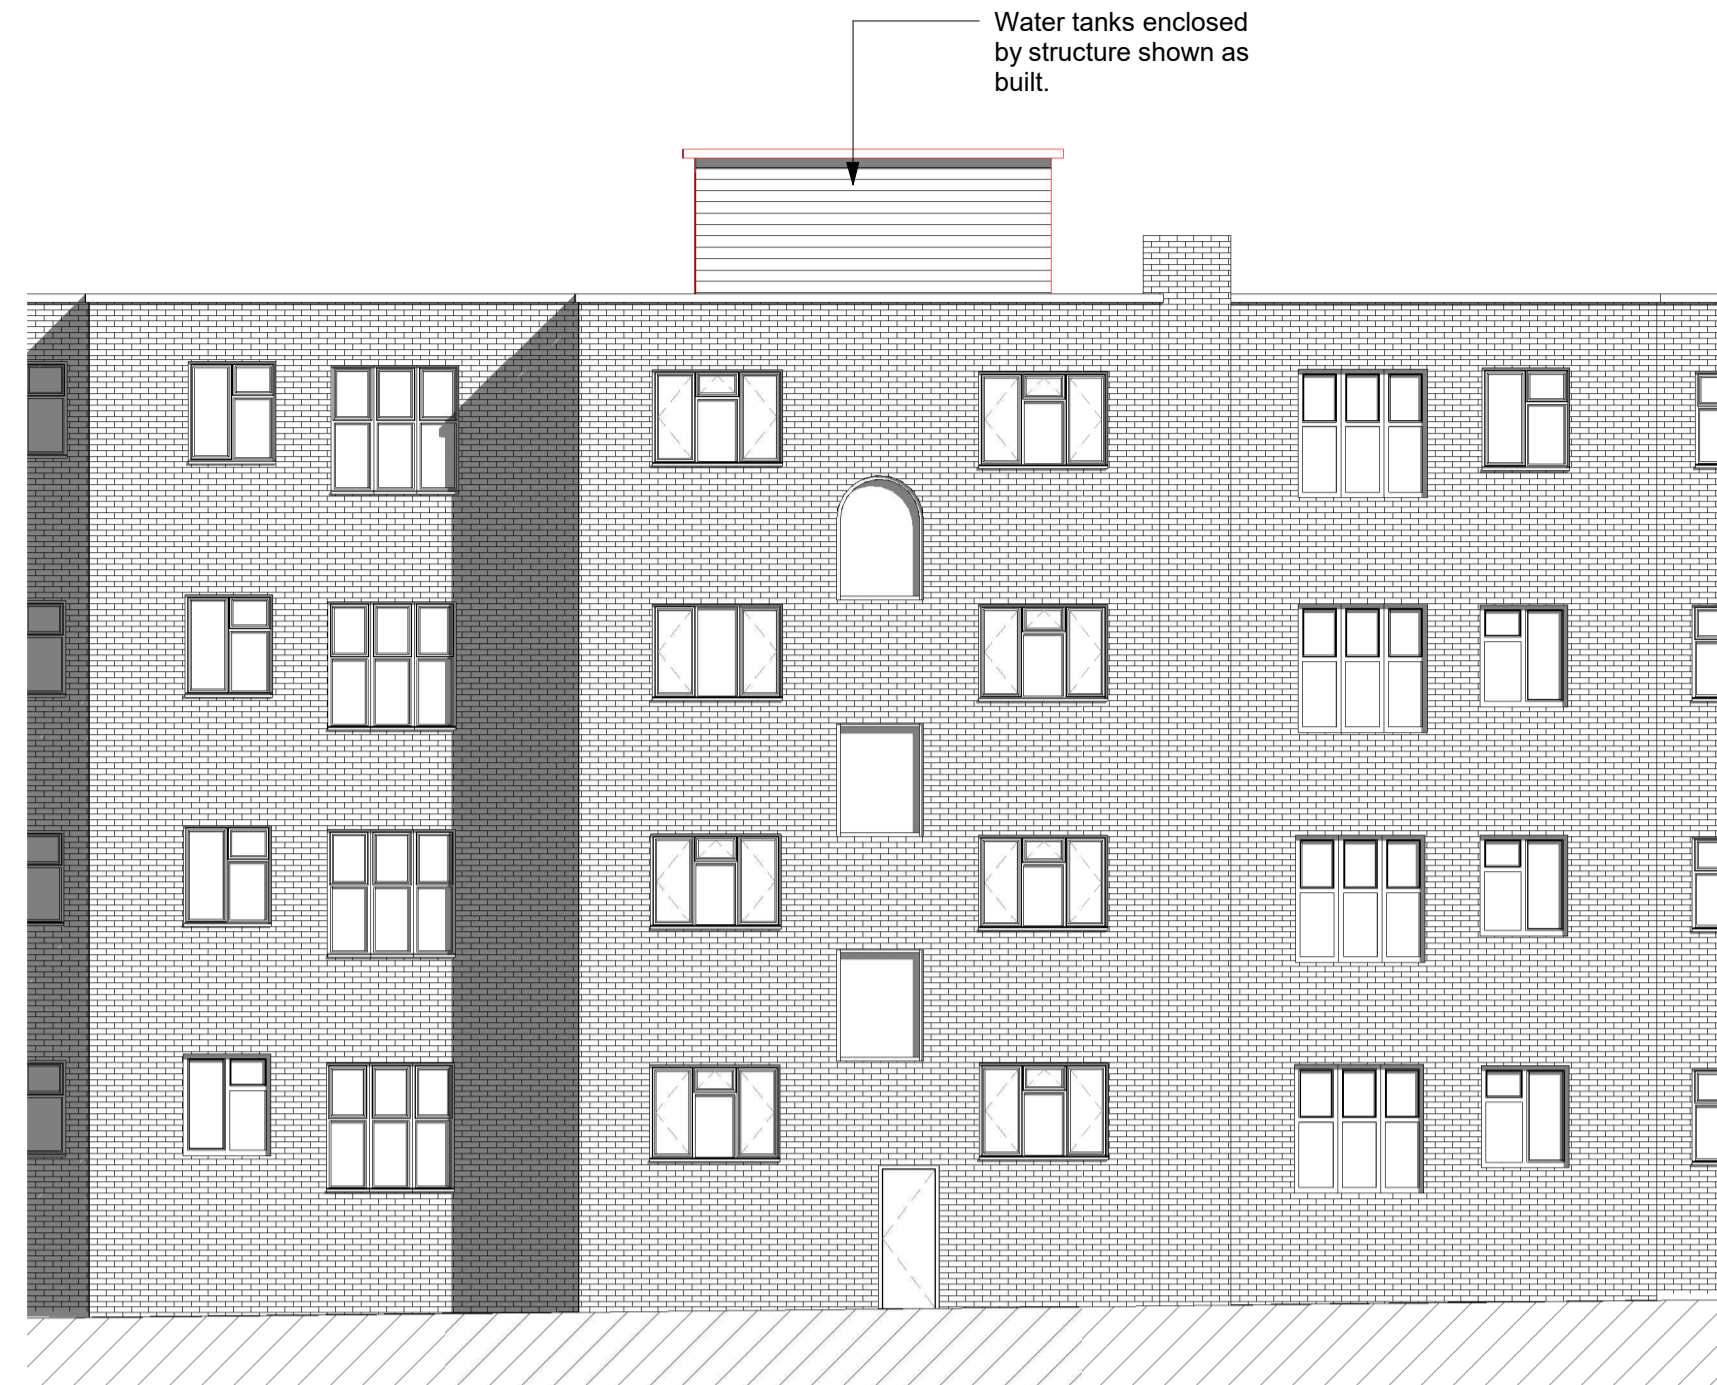


2 Elevation 06
1 : 100

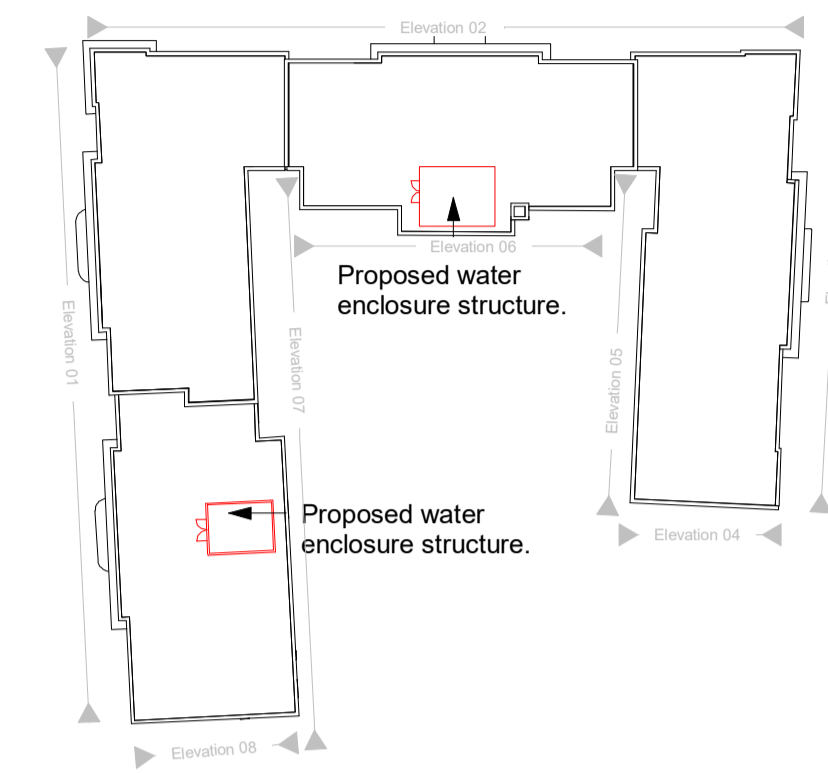

5 Proposed Ref Plan
1 : 500




3 Elevation 07
1 : 100

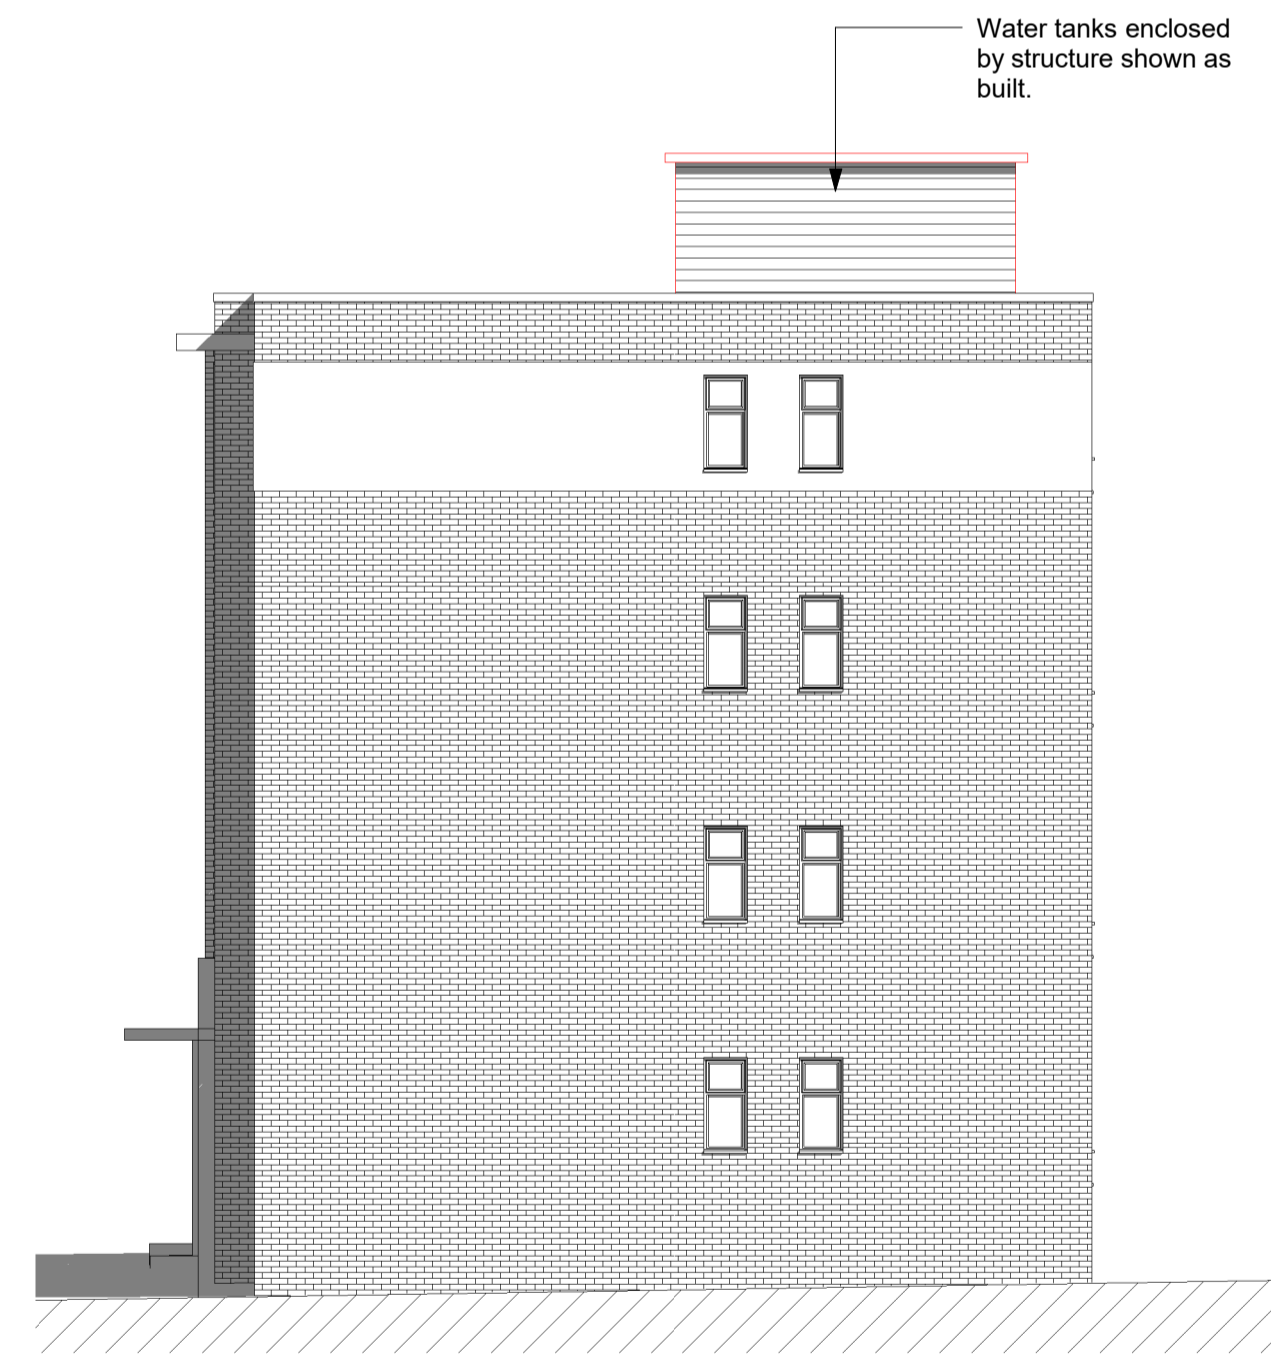

4 Elevation 08
1 : 100

Revision	Date	Comment

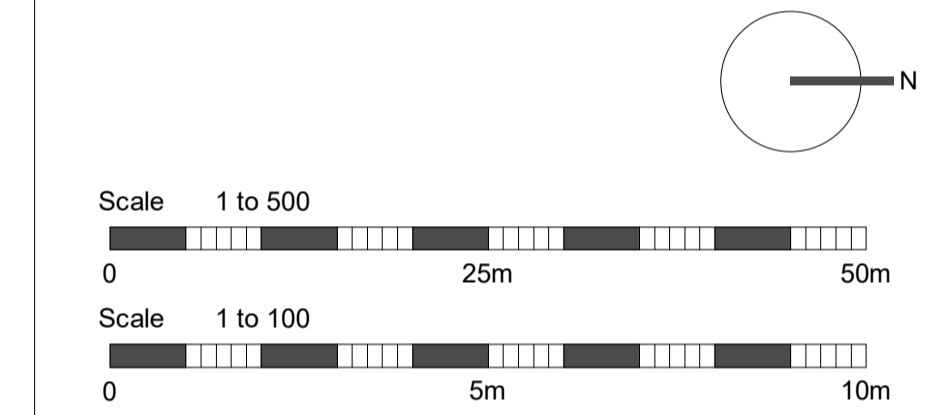

3 Sherman Walk, London SE10 0YJ
Tel: 020 8777 7700
Email: laura.dumitru@blakeneyleigh.co.uk

Client
Fresh Property Management

Property
31 - 60 Windsor Court Golders Green Rd, London NW11 9PR

Project
Water Tanks Enclosures

Drawing Title
Existing Elevations as Built 2 of 2

Drawn By L Dumitru	Date JUNE 2021
Scale @ A1 As indicated	Drawing No. FPM035/02
Checked By NG	Revision No.