

FRONT ELEVATION


1. Do not scale from this drawing - use figured dimensions only.
2. This drawing and design are copyright - do not reproduce or pass to third parties without the written consent of the architect.
3. The contractor shall verify all dimensions and levels and other relevant information before ordering materials or components or carrying out work and shall advise the architect of any discrepancies.

**KEY:**

← GREY NOTES HAVE BEEN PREVIOUSLY APPROVED IN PREVIOUS APPLICATION. REF: 21/00548/LBC & 21/00547/FULL

← GREEN NOTES ARE SUBJECT TO SEPARATE APPLICATION. REF: 21/03914/LBC & 21/03913/FULL

← BLUE NOTES ARE NEWLY PROPOSED

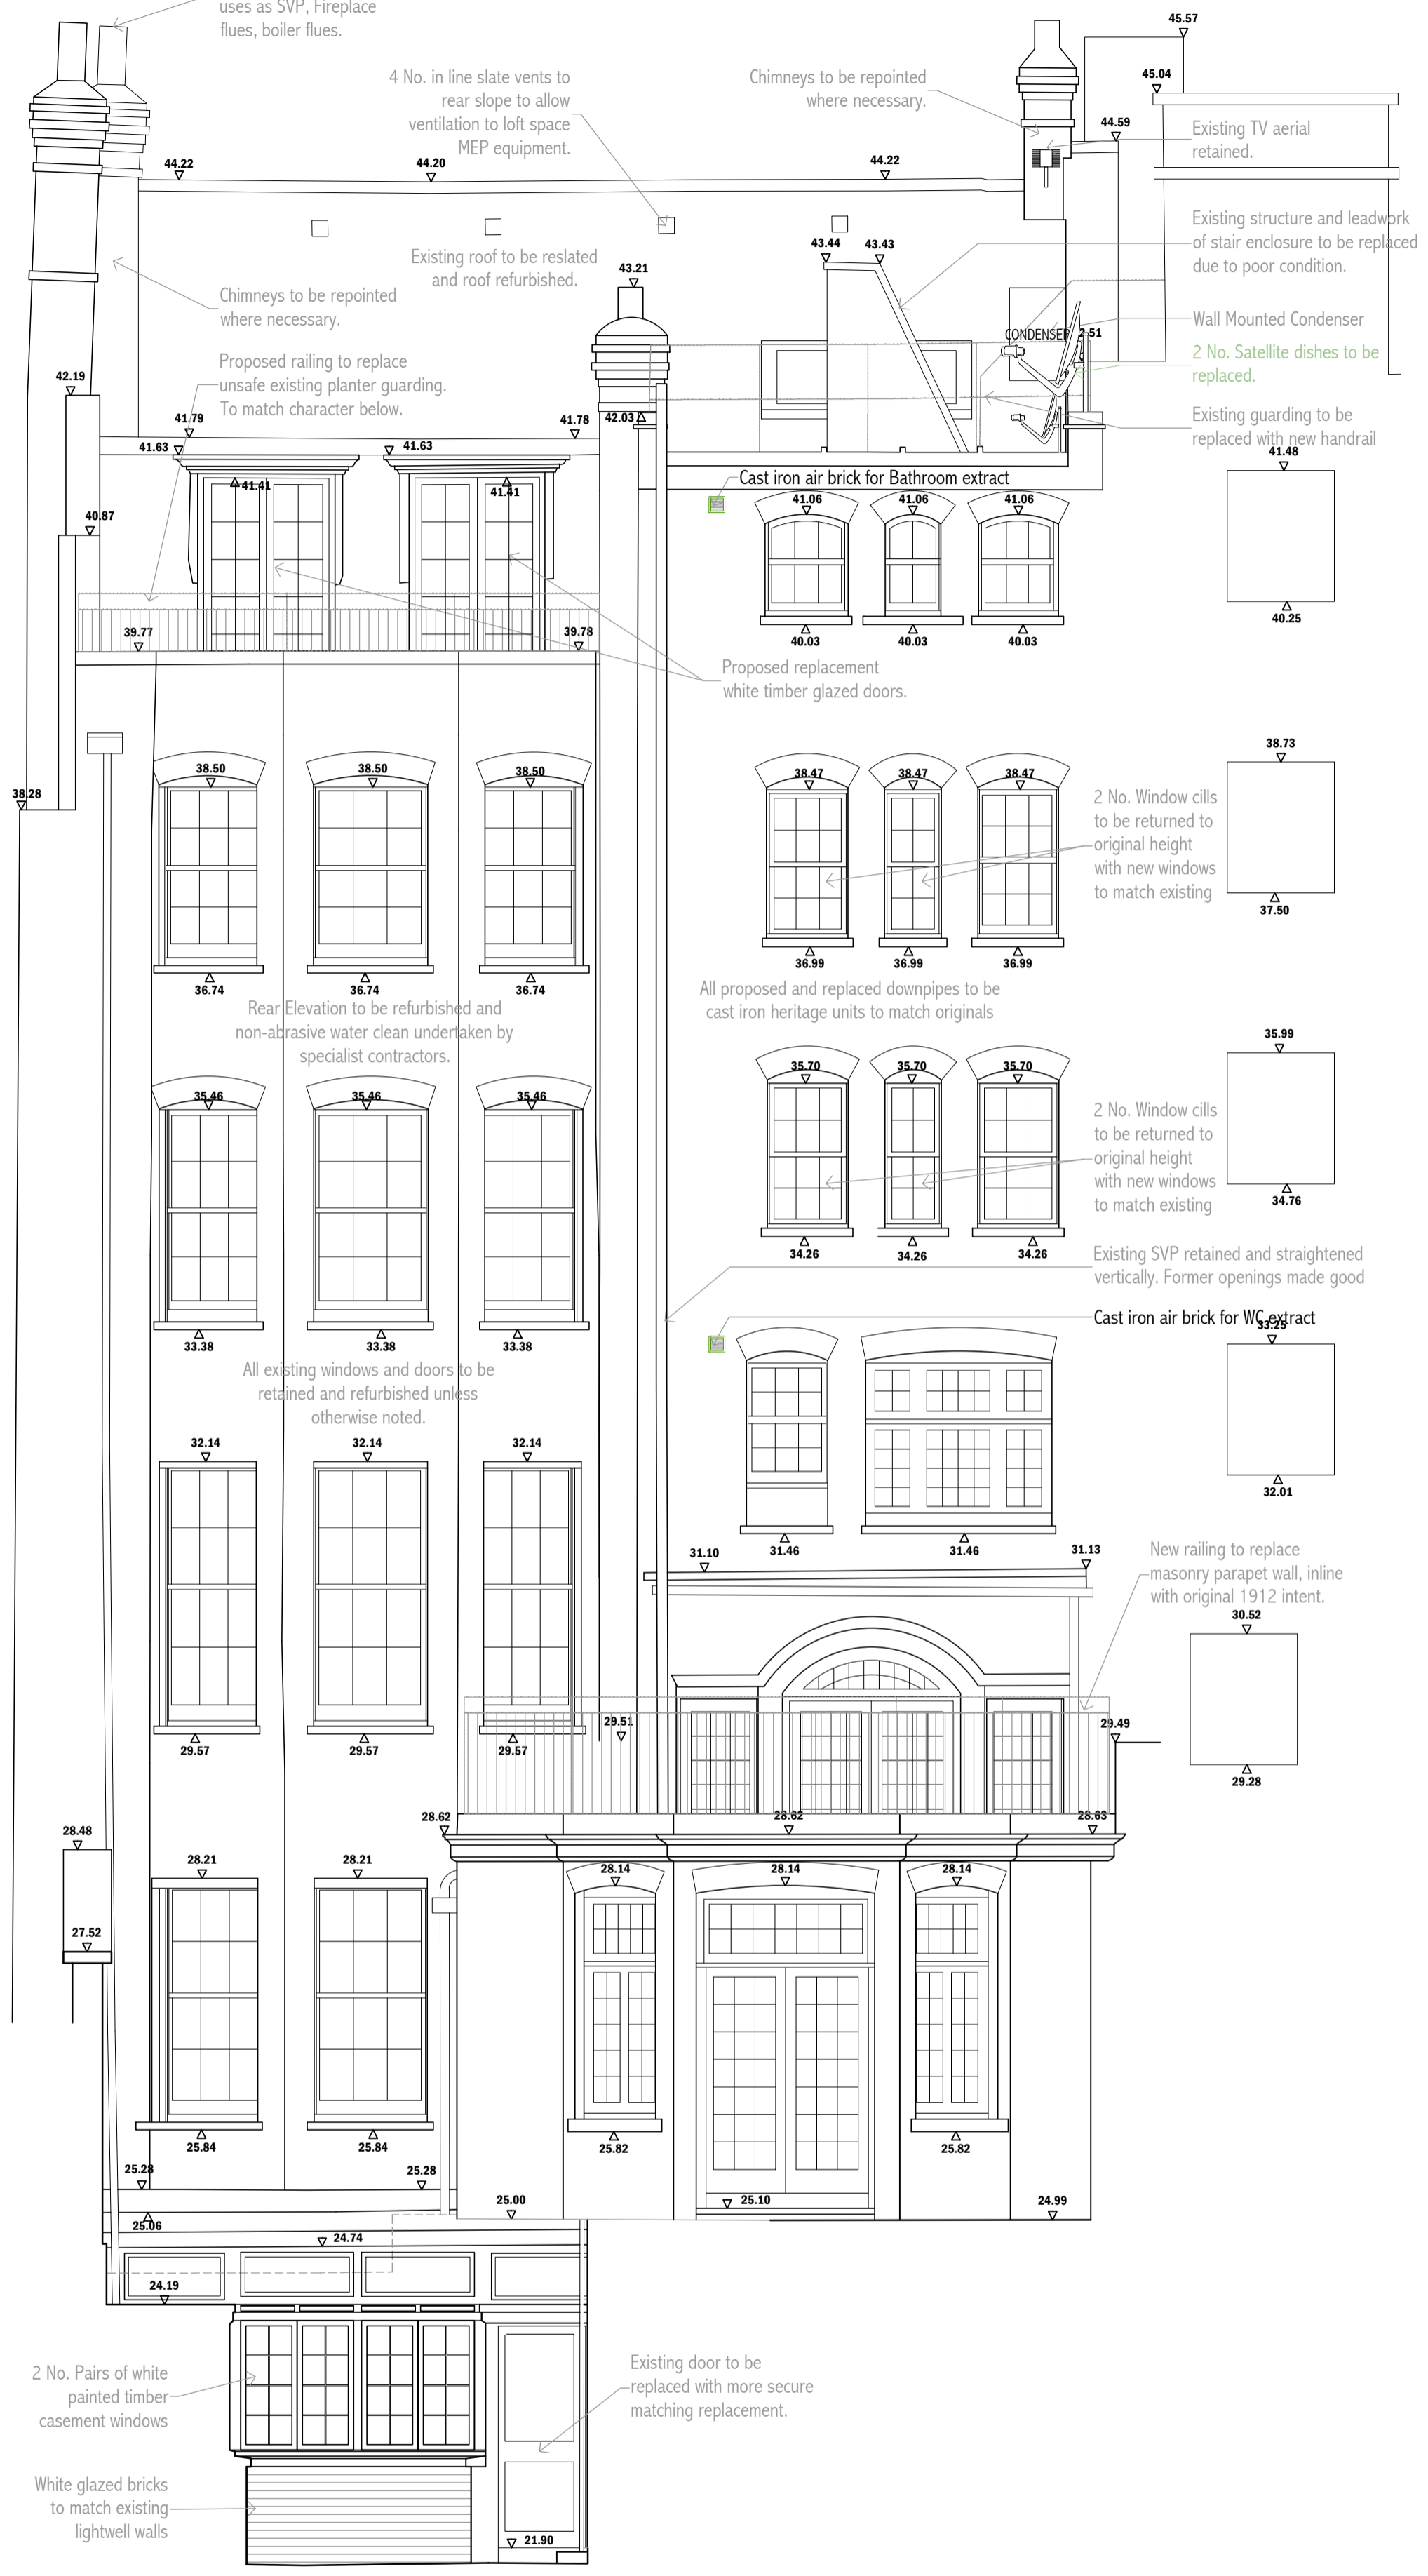

REAR ELEVATION

REVISION	BY	DATE	NO
Updated to suit ME comments. Grille to Library vent system omitted.	SO	24.06.21	P6
Updates to suit comments.	SO	18.04.21	P5
Updates to suit comments.	SO	09.04.21	P4
Issue for Comment.	SO	06.06.21	P3
Issue for Comment.	SO	04.06.21	P2
Issue for Planning.	SO	28.01.21	P1

SCALE	DATE	DRAWN
1:50@A1	22.01.21	SO

DRAWING STATUS		
PRELIMINARY	<input type="checkbox"/> TENDER	<input type="checkbox"/>
PLANNING	<input checked="" type="checkbox"/> BILLS OF QUANTITIES	<input type="checkbox"/>
BUILDING REGULATIONS	<input type="checkbox"/> CONSTRUCTION	<input type="checkbox"/>
COMMENT/APPROVAL	<input type="checkbox"/> AS BUILT	<input type="checkbox"/>

**CAMM ARCHITECTS**

Suite 2 15 Market Square  
 Bishops Stortford  
 HERTS CM23 3UT  
 t +44 (0) 1279 460048  
 f +44 (0) 1279 460048  
 e. office@cammarchitects.com

**ONLY ITEMS IDENTIFIED IN BLUE FORM PART OF THIS APPLICATION. OTHER NOTES (GREY/GREEN) ARE RELATED TO SEPARATE APPLICATIONS/APPROVALS.**

PROJECT  
 7 WIMPOLE ST, LONDON, W1G 9SN

TITLE  
 PROPOSALS  
 FRONT AND REAR  
 ELEVATIONS  
 DRAWING NO

1918-03-201

REV  
 P6