
acoustic ceiling treatment.

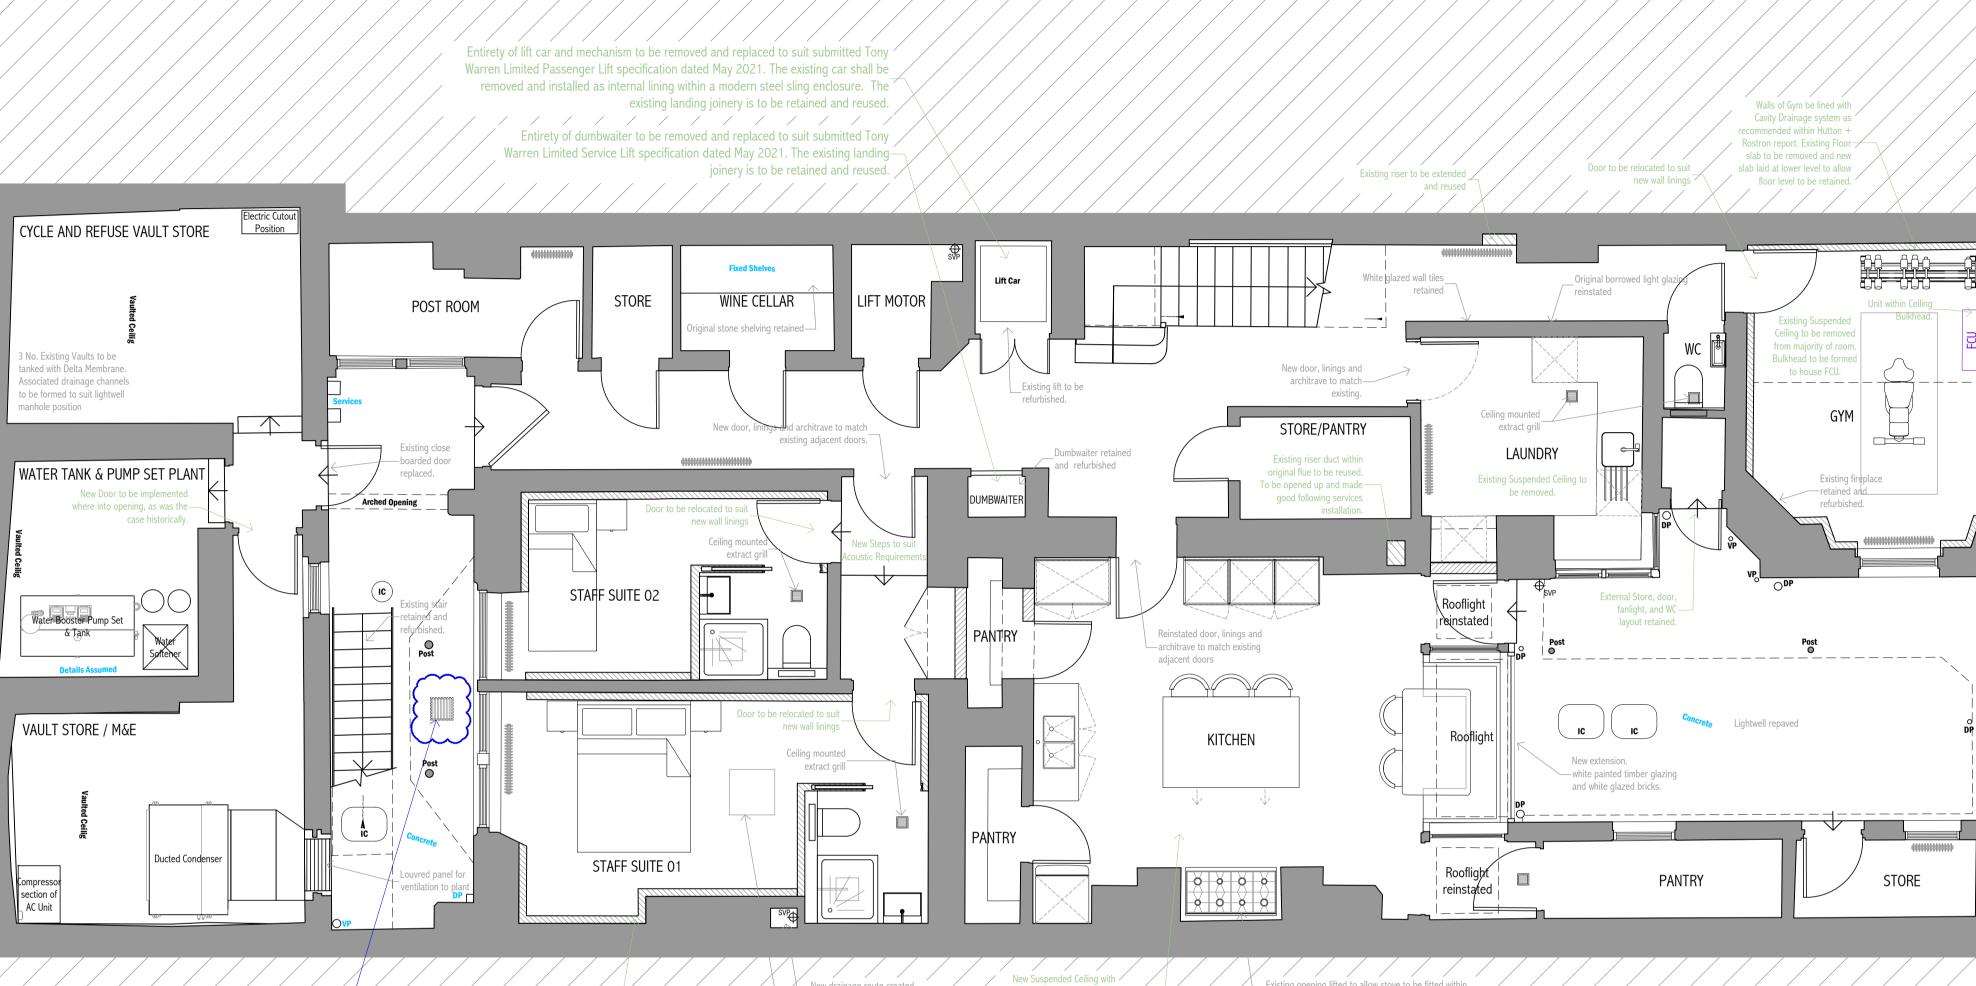

Air intake to serve the library ventilation system. Routed Proposed staff suite 01 & 02 walls to be treated to through bay window soffit, through previously proposed prove acoustic performance with independent linings dropped acoustic ceiling, through ceiling to grilles in acoustic floor build up, and proposed suspended library joinery above. Please refer to submitted RSMEP for further information.

KEY: 1. Do not scale from this drawing - use figured

2. This drawing and design are copyright - do not reproduce or pass to third parties without the written consent of the architect.

dimensions only.

3. The contractor shall verify all dimensions and levels and other relevant information before ordering materials or components or carrying out work and shall advise the architect of any discrepancies.

GREY NOTES HAVE BEEN PREVIOUSLY APPROVED IN PREVIOUS APPLICATION. REF: 21/00548/LBC & 21/00547/FULL

GREEN NOTES ARE SUBJECT TO SEPARATE APPLICATION. REF:21/03914/LBC & 21/03913/FULL

BLUE NOTES ARE NEWLY PROPOSED

New drainage route created within chimney breast to align

with flue above.

tile finish to match existing-

Existing opening lifted to allow stove to be fitted within 2m. Existing flue to be lined for use as extract.

| | | | | 1:50@A1 | 13.11.2 | 0 | SO |
|----------|----------|----------------------------------|----------------------------|-------------------------|---------|-------------------------------|----|
| | | | | | | | |
| | so | 24.06.21 | P6 | | | | |
| SO SO | SO | 18.06.21 09.06.21 04.06.21 | P5 P4 P3 P2 P1 | PRELIMINARY PLANNING | | TENDER BILLS OF QUANTITIES | |
| | so so | 04.06.21 28.01.21 | | BUILDING REGULATIONS | | CONSTRUCTION | |
| | ΒY | DATE | NO | COMMENT/APPROVAL | | AS BUILT | |
| | | | | | | | |

DATE

SCALE

REVISION

Updated to suit ME comments. Updated to reflect mosaic and tiles.


Updated to suit comments.

Lift information added.

Issued for Comment

Issued for Planning



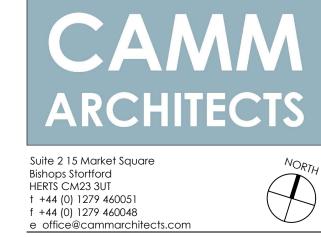

1918-03-101

DRAWING NO

REV

P6

TITLE PROPOSALS LOWER GROUND FLOOR

PROJECT 7 WIMPOLE ST, LONDON, W1G 9SN

ONLY ITEMS IDENTIFIED IN BLUE FORM PART OF THIS APPLICATION. OTHER NOTES (GREY/GREEN) ARE RELATED TO SEPARATE APPLICATIONS/APPROVALS.

