



# Sparrow Court

Lee On Solent, Hampshire.

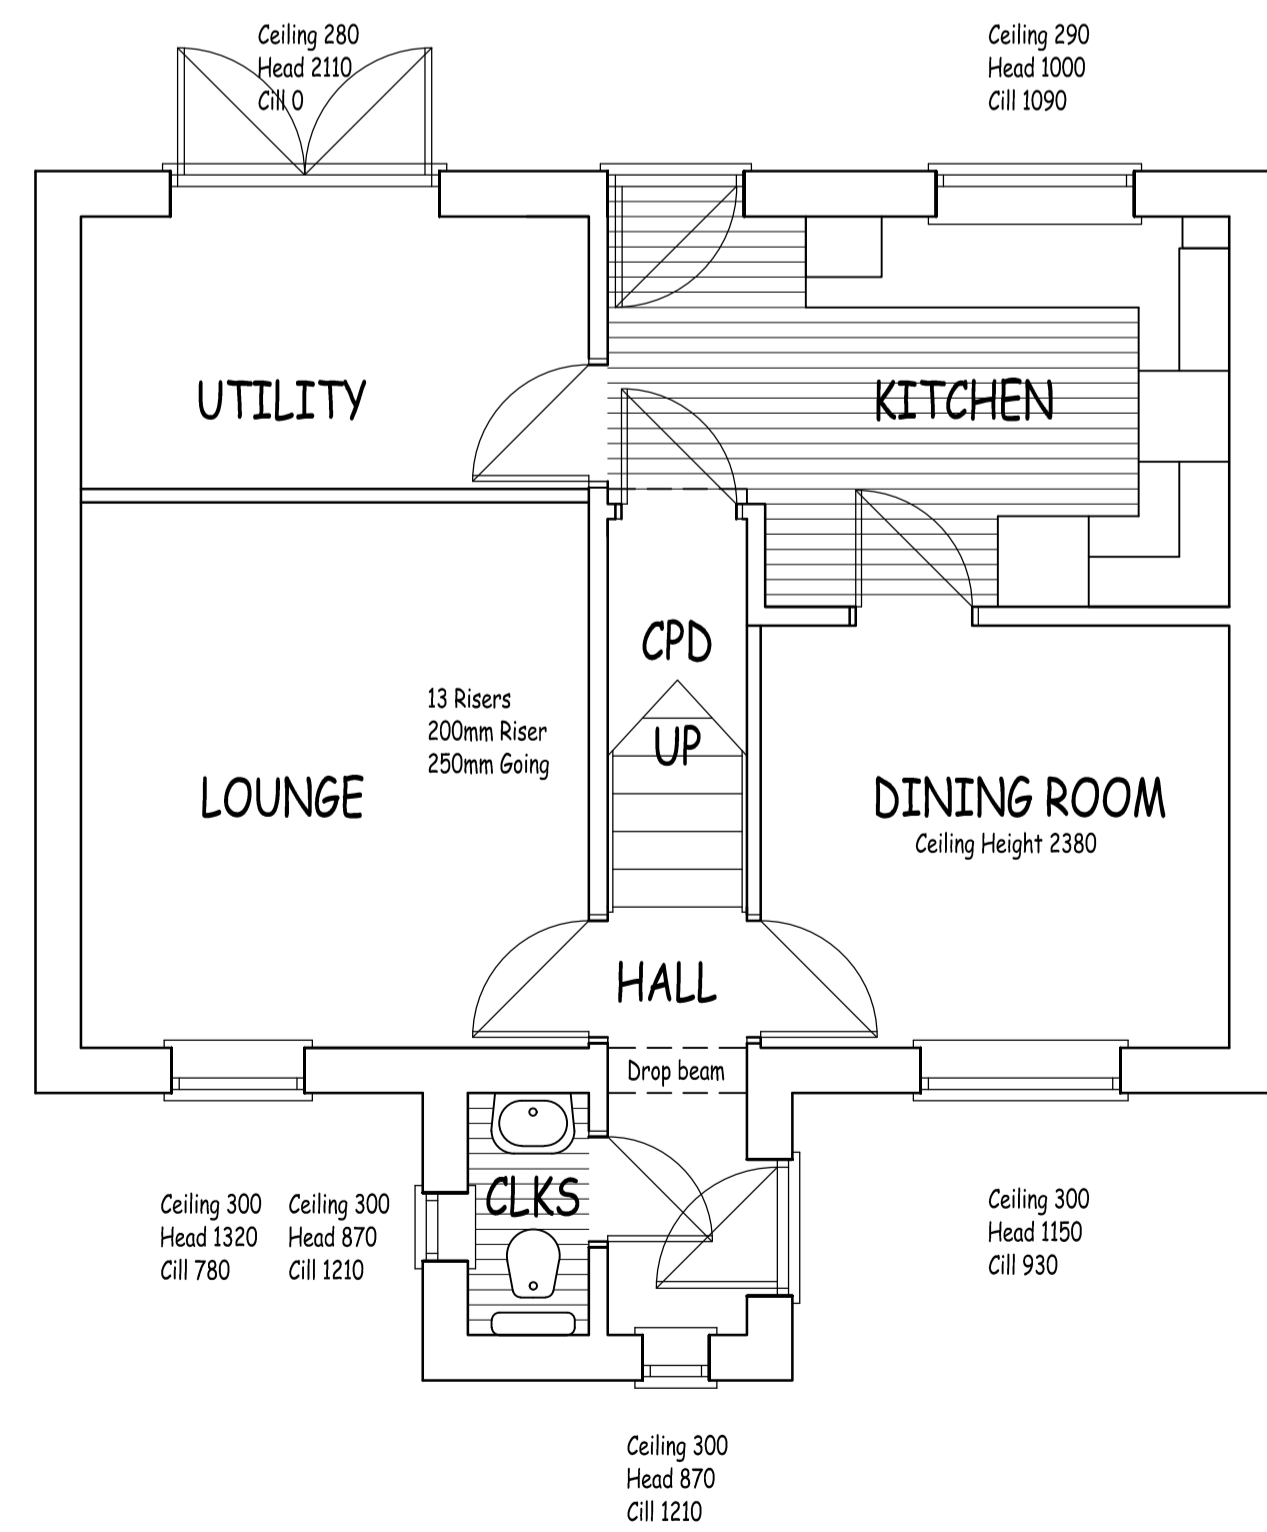

GROUND FLOOR PLAN

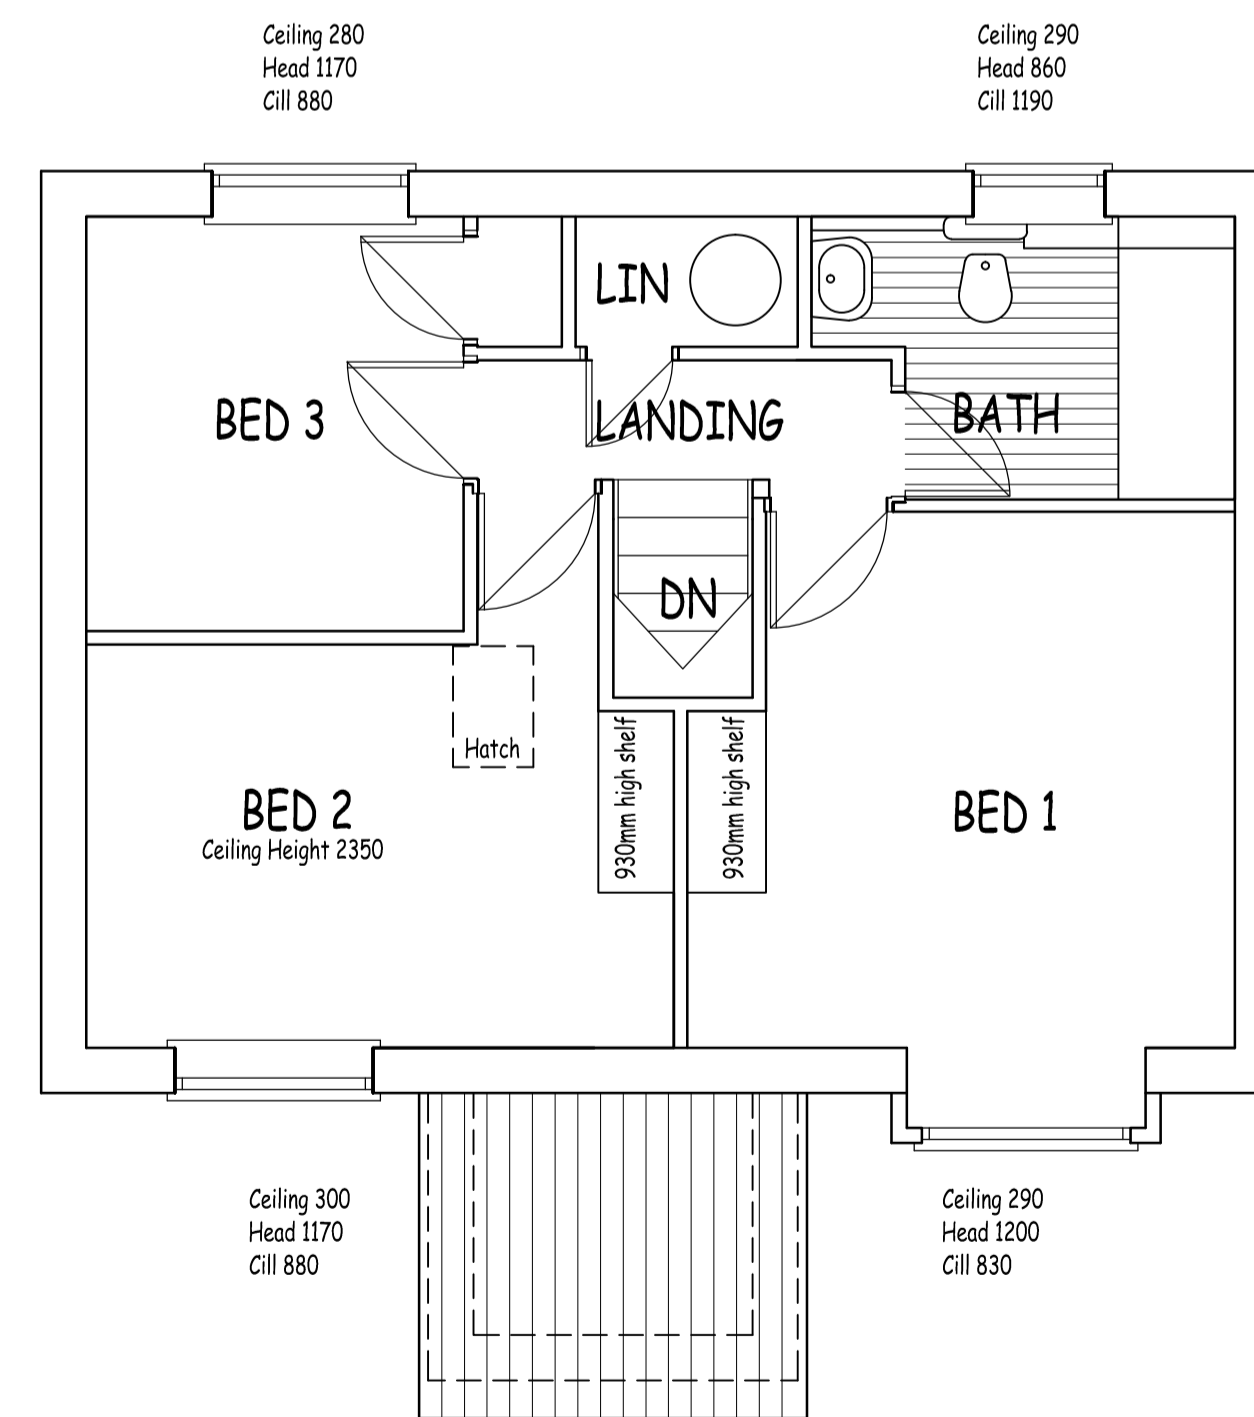

FIRST FLOOR PLAN

This drawing is protected by copyright and may not be copied or disclosed to third parties without the expressed permission of Town & Country Architecture.  
 Preferences should be given to written figured dimensions over scale measurements.  
 Discrepancies of any kind must be reported to Town & Country Architecture.

**TOWN & COUNTRY ARCHITECTURE**

ARCHITECTURAL TECHNOLOGISTS

4 FONGLOVES  
THE HEADINGS  
FAREHAM  
HAMPSHIRE PO16 8JW

TELEPHONE: (01329) 238402  
FACSIMILE: (01329) 238492

SUMMIT ROAD, DUNNIFRAVE

PROJECT  
**AS BUILT PLAN**  
 11 Sparrow Court  
 Lee On Solent  
 Hampshire

CLIENT  
 Mr. M. Sadler & Miss L. Ball

SCALE  
 1:50 1:100 (A1)

DATE  
 -

DRAWN  
 P.T.E MCIAT

CHECKED  
 -

DRWG. NO.  
**21/23/01**

REVISION  
 \* (0) (0) (0) (0) (0) (0) (0) (0) (0) (0)