

APPENDIX B

BGS borehole records

D STRATA LOG

Geological Classification (BGS only)	Description of strata	Thickness	Depth
		m	m
	TERRACE GRAVELS	8	8
	LONDON CLAY	59	67
	WR B	8	75
	THANET SANDS	9	84
	UPPER CHALK	54	138
(continue on separate page if necessary)			
	Other comments (e.g. gas encountered, saline water intercepted, etc.)		

FOR OFFICIAL USE ONLY

FILE	CONSENT NO	NGS REF NO:
LIC NO:	PURPOSE:	EA REF NO:
DATE REC:	COPY TO:	ENTERED BY:

7027/388

FORM WR - 38

Consent No: TP07/54A

BGS No:

D. STRATA LOG

Geological Classification	Description of Strata	Thickness	Depth
(BGS only)		m	m
	GRAVEL FOOTWAY		0.00
	ASH, CINDER, COKE SUB BASE		0.10
	MADE GROUND, CLAY FILL, BRICK FRAGMENTS, F/C GRAVEL		0.20
	SOFT BROWN SANDY GRAVELY CLAY		1.30
	BROWN SANDY F/M/C GRAVEL		1.70
	FIRM / STIFF BROWN SANDY CLAY		8.80 ?
	LONDON CLAY		9.00 }
	LAMBETH BEDS		53.00
	THANET SANDS		65.00
	FLINT		82.00
	CHALK		87.00
	CHALK & FLINT		90.00
			150.00
	[continue on separate page if necessary]		
	Other Comments (eg gas encountered, saline water intercepted, etc)		

FOR OFFICIAL USE ONLY

FILE CONSENT NO BGS REF NO

LICENCE NO USE OF BH NGR.....

7027/389

FORM WR - 38

Consent No: TP07/54A

BGS No:

D. STRATA LOG

Geological Classification	Description of Strata	Thickness	Depth
(BGS only)		m	m
	GRAVEL FOOTPATH		0.00
	ASH, CINDER, COKE CINDER, SUB BASE		0.10
	MADE GROUND, BROWN SLIGHTLY CLAY ASH, CINDER, BRICK		0.25
	MADE GROUND, SOFT / FIRM GREY CLAY FILL, BRICK, GRAVEL		2.30
	BROWN SANDY F/C GRAVEL		2.50
	BROWN SANDY GRAVELY CLAY		4.30
	STIFF BROWN - GREY / BROWN SANDY SLIGHTLY GRAVELY CLAY		7.90 }
	LONDON CLAY		8.50 }
	LAMBETH BEDS		53.00
	THANET SANDS WITH FLINT		67.30
	FLINT		83.50
	CHALK WITH FLINT		87.10
			151.00
	[continue on separate page if necessary]		
	Other Comments (eg gas encountered, saline water intercepted, etc)		

FOR OFFICIAL USE ONLY

FILE CONSENT NO BGS REF NO

LICENCE NO USE OF BH NGR.....

KW-2009-533



DRILLING RECORD

**SITE ADDRESS; 21 WILTON STREET
BELGRAVIA
LONDON
SW1X 7AX.**

GEOLOGICAL FORMATION.

MADE-UP GROUND. -----900mm Thick.

KEMPTON GRAVEL -----9.200 metres Thick

DARK GREY LONDON CLAY -----32.800 metres Thick

SILT / SAND SMALL AMOUNT OF GRAVEL---42.900 metres.



BOREHOLE FINISHED DEPTH 48 metres

M. J. Strong
Civil Water Engineer

MJS Civil Water Engineers
Lythcott House, Rick, Dorset

APPENDIX C

Structural Engineer's Marked-up Drawings

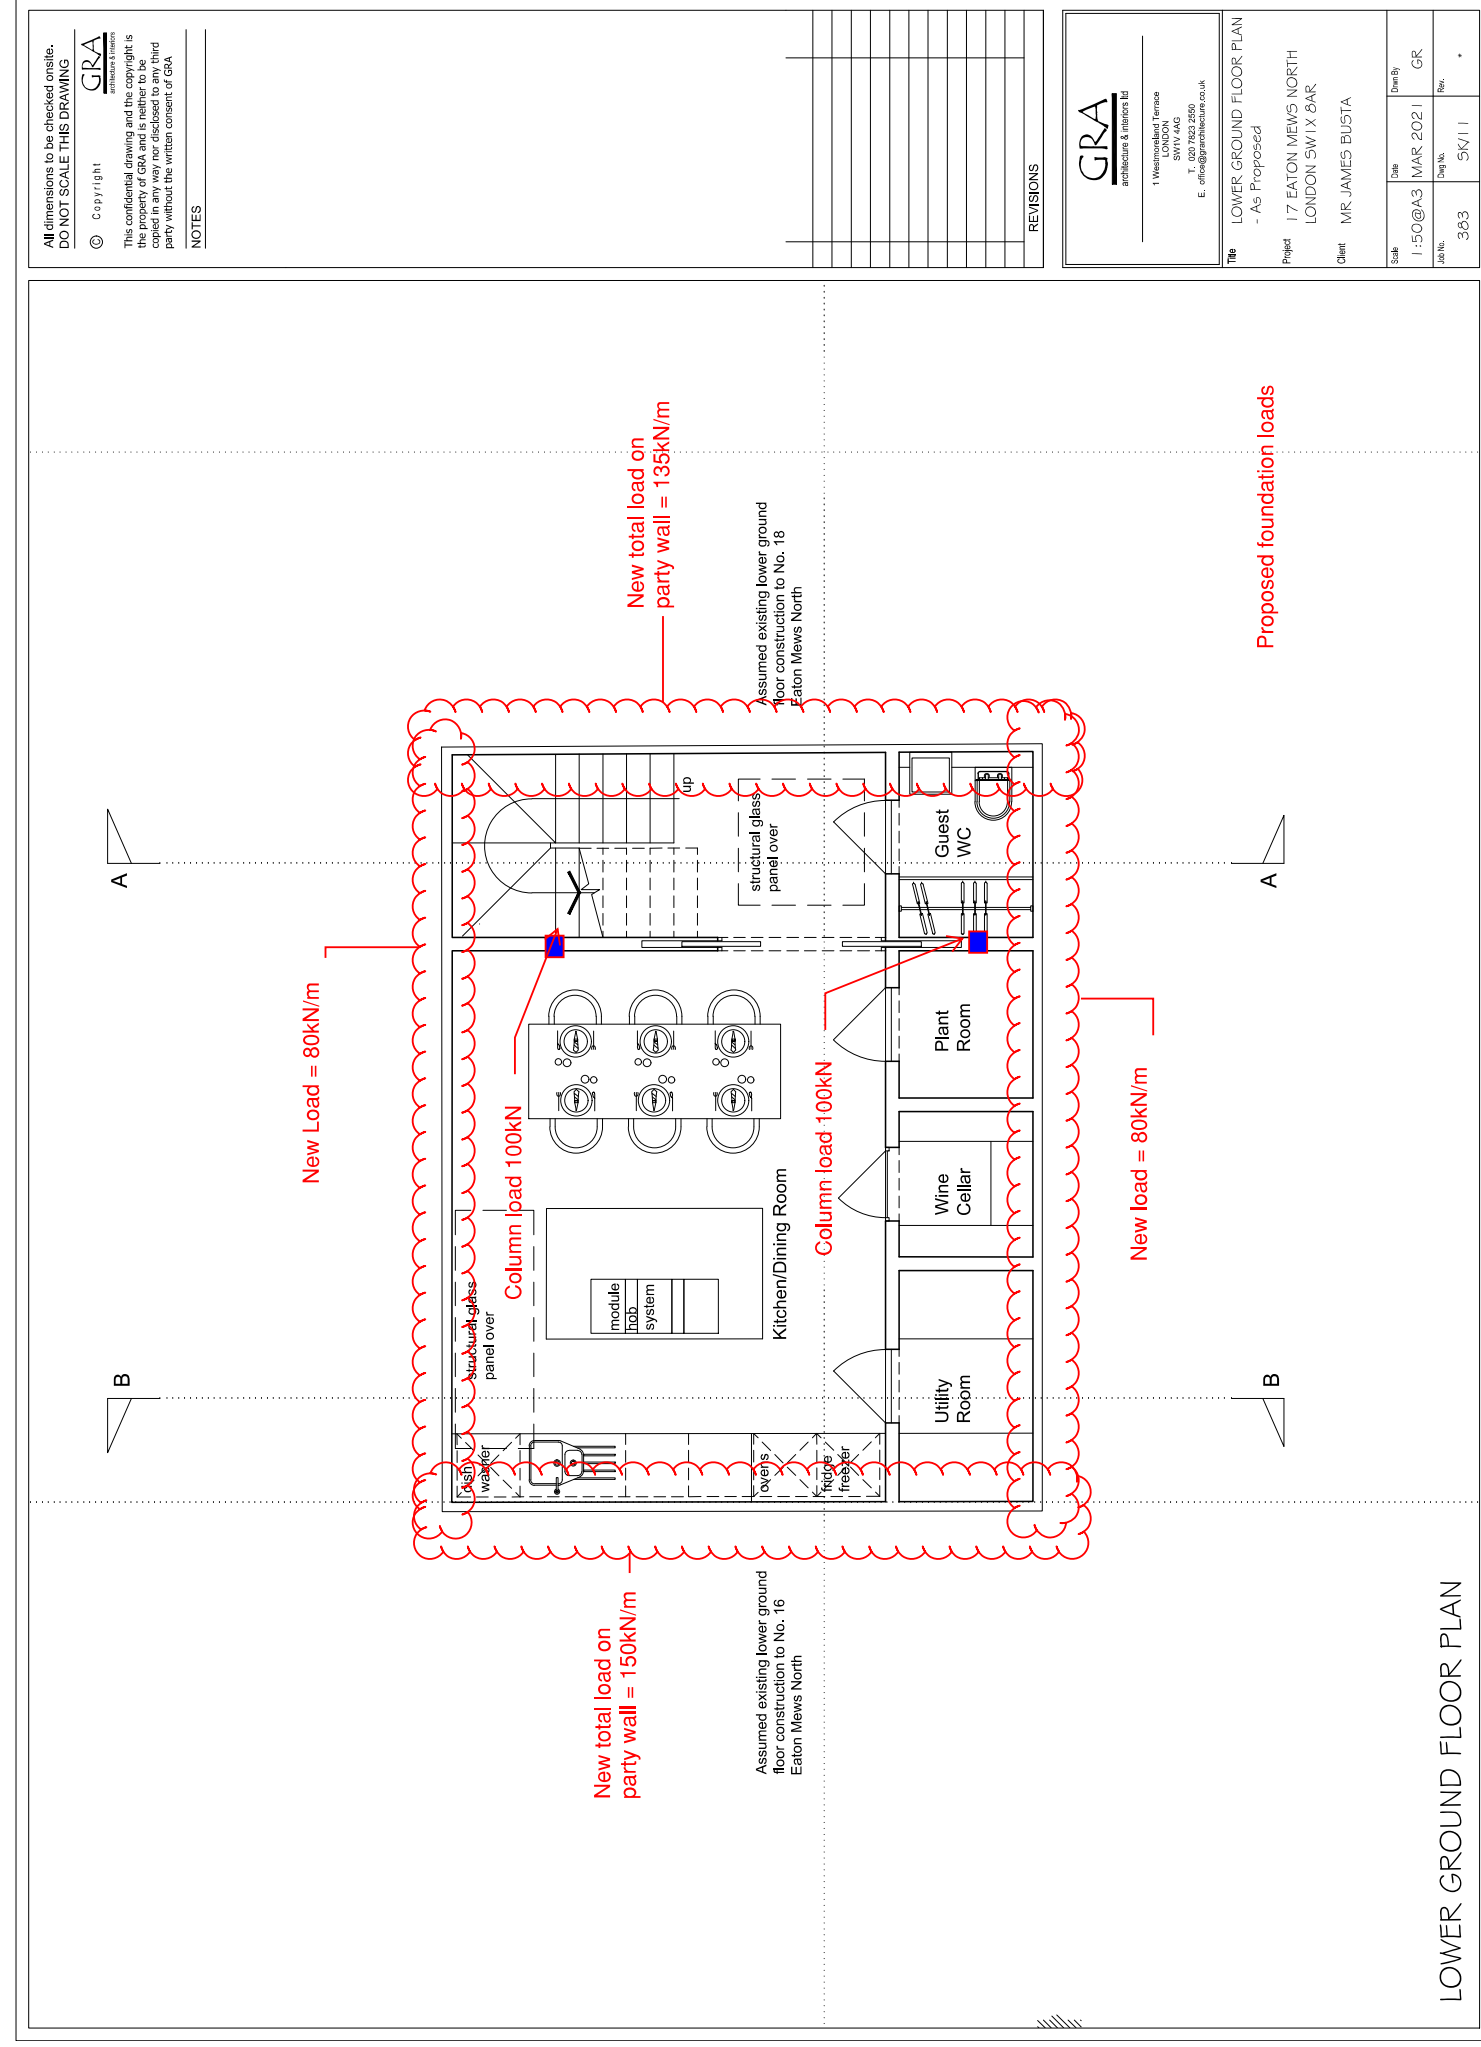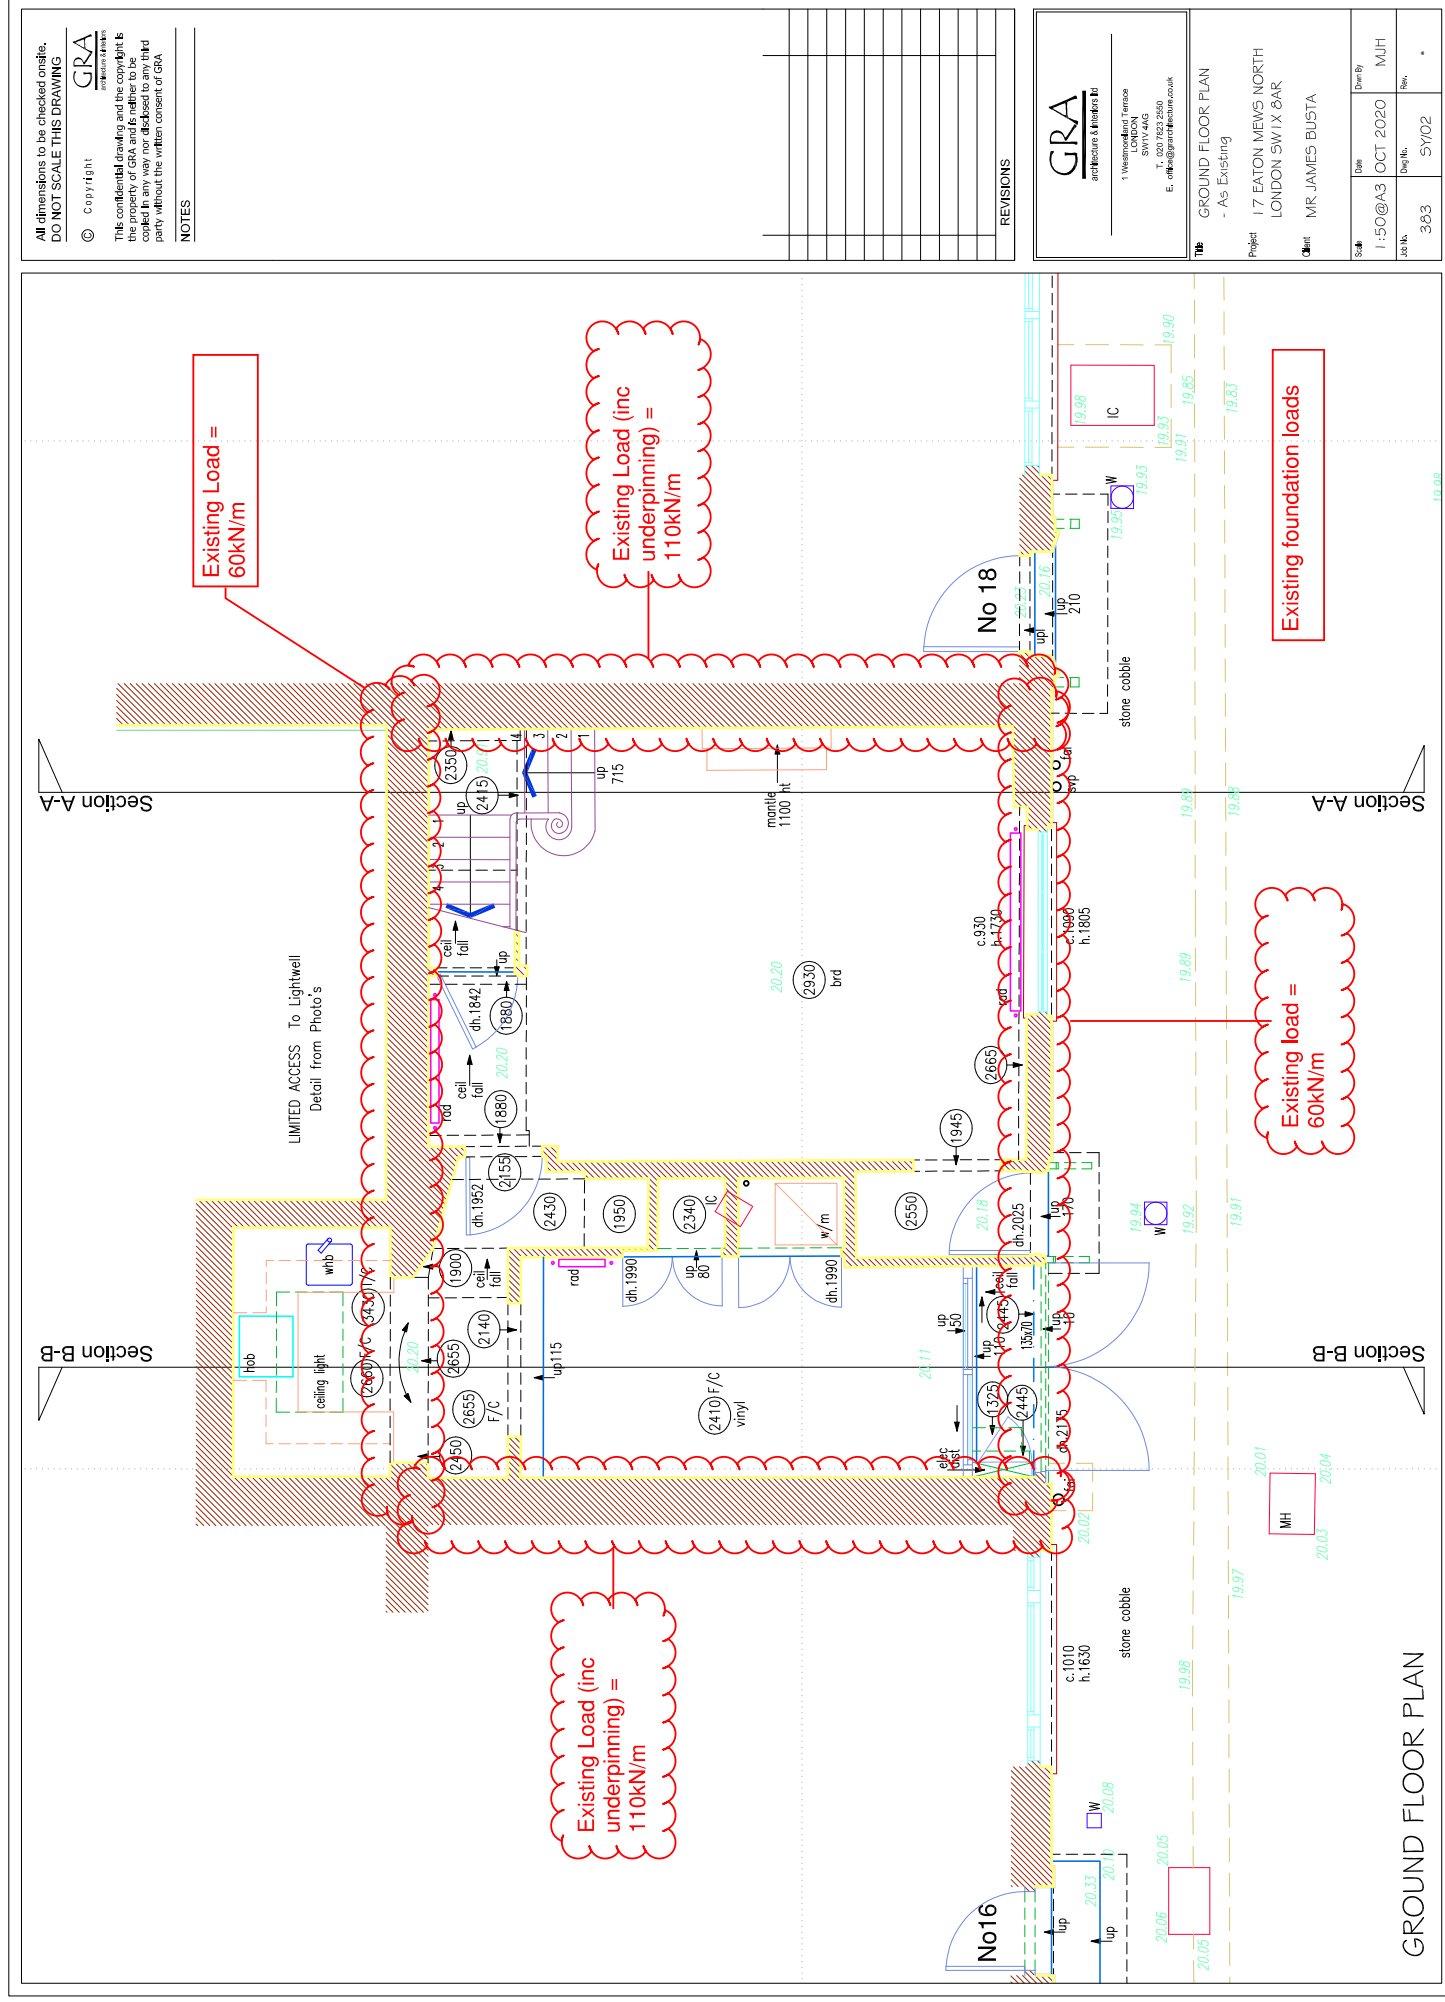


All dimensions to be checked onsite.
DO NOT SCALE THIS DRAWING

© Copyright
GRA
architects & interior designers
1 Westminster Terrace
LONDON
SW1V 4AG
T: 020 7600 2525
E: office@grainstitute.co.uk

This confidential drawing and the copyright is the property of GRA and is neither to be copied in any way nor disclosed to any third party without the written consent of GRA

NOTES

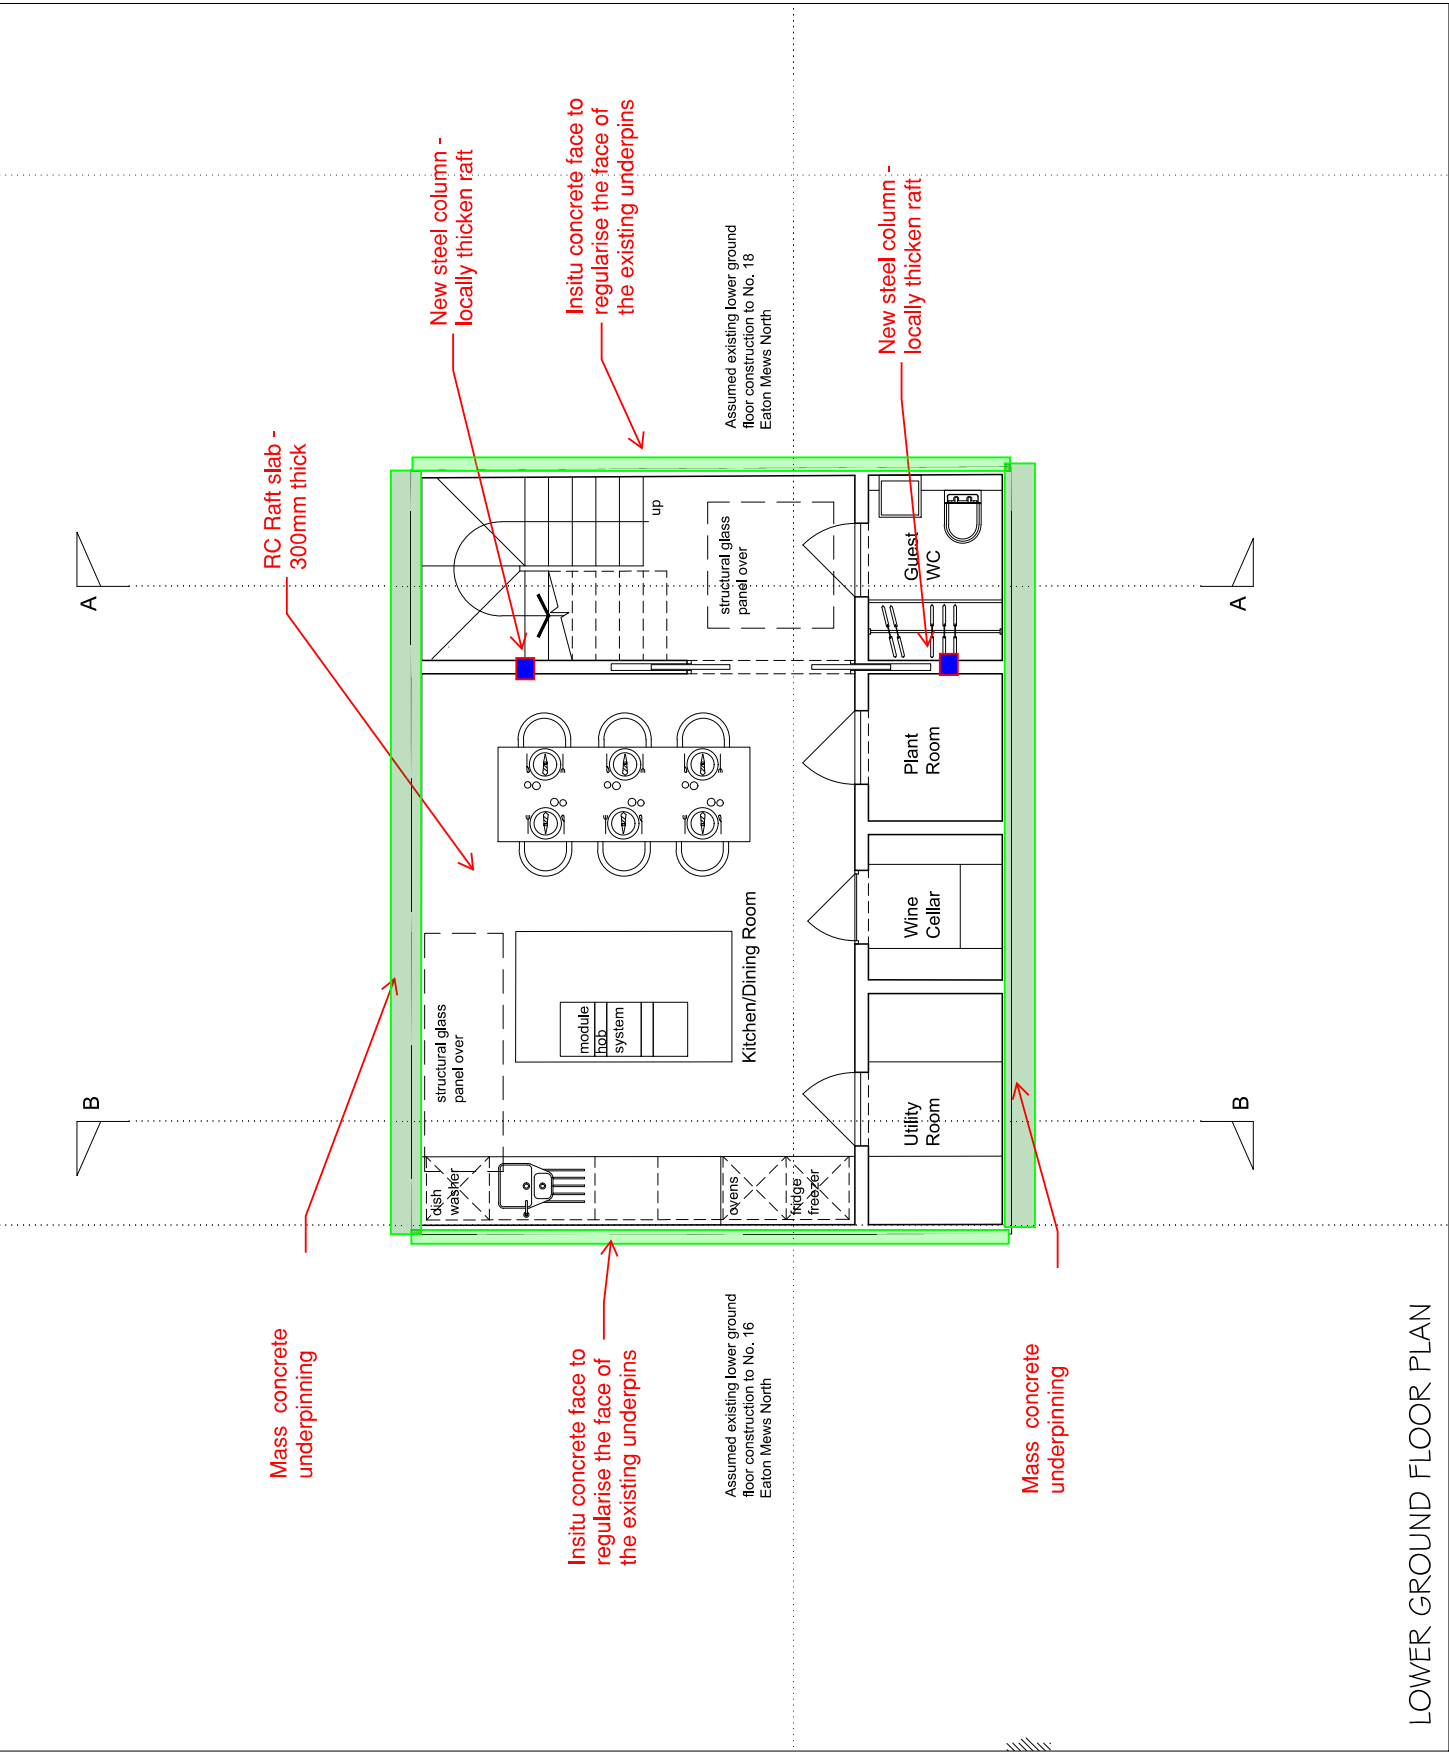

GRA
architects & interior designers
1 Westminster Terrace
LONDON
SW1V 4AG
T: 020 7600 2525
E: office@grainstitute.co.uk

LOWER GROUND FLOOR PLAN
- As Proposed

Project: 17 EATON MEWS NORTH LONDON SW1X 8AR
Client: MR JAMES BUSTA


Scale: 1:50@A3
Date: MAR 2021
Dwg No.: 363
Rev.: *

All dimensions to be checked onsite.
DO NOT SCALE THIS DRAWING

© Copyright
GRA
architects & interior designers
1 Westminster Terrace
LONDON
SW1V 4AG
T: 020 7600 2525
E: office@grainstitute.co.uk

This confidential drawing and the copyright is the property of GRA and is neither to be copied in any way nor disclosed to any third party without the written consent of GRA

NOTES

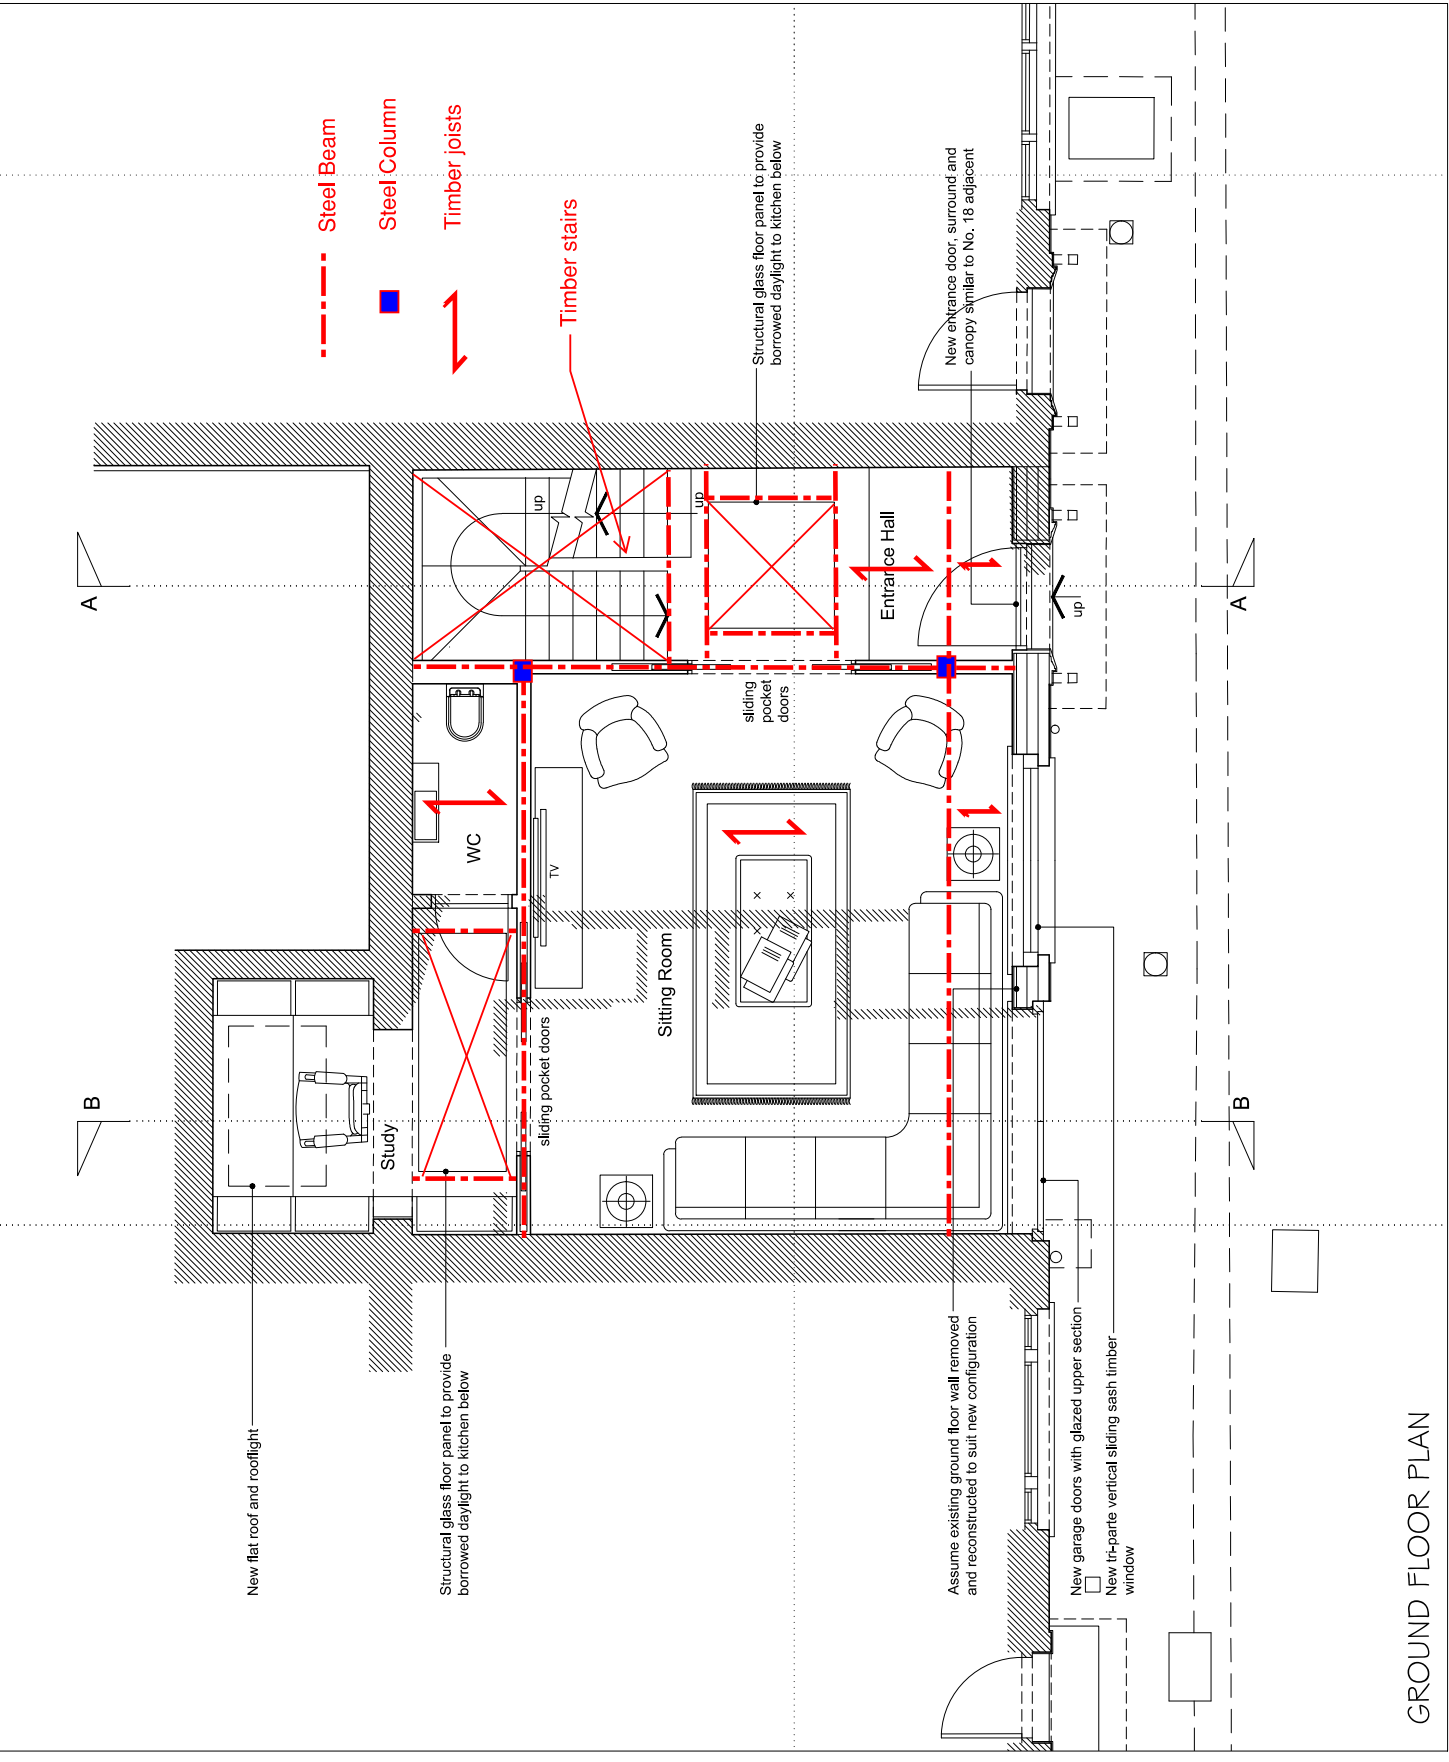

GRA
architects & interior designers
1 Westminster Terrace
LONDON
SW1V 4AG
T: 020 7600 2525
E: office@grainstitute.co.uk

GROUND FLOOR PLAN
- As Proposed

Project: 17 EATON MEWS NORTH LONDON SW1X 8AR
Client: MR JAMES BUSTA


Scale: 1:50@A3
Date: MAR 2021
Dwg No.: 363
Rev.: *

All dimensions to be checked onsite.
DO NOT SCALE THIS DRAWING

© Copyright
GRA
architects & interior designers

This confidential drawing and the copyright is the property of GRA and is neither to be copied in any way nor disclosed to any third party without the written consent of GRA

NOTES

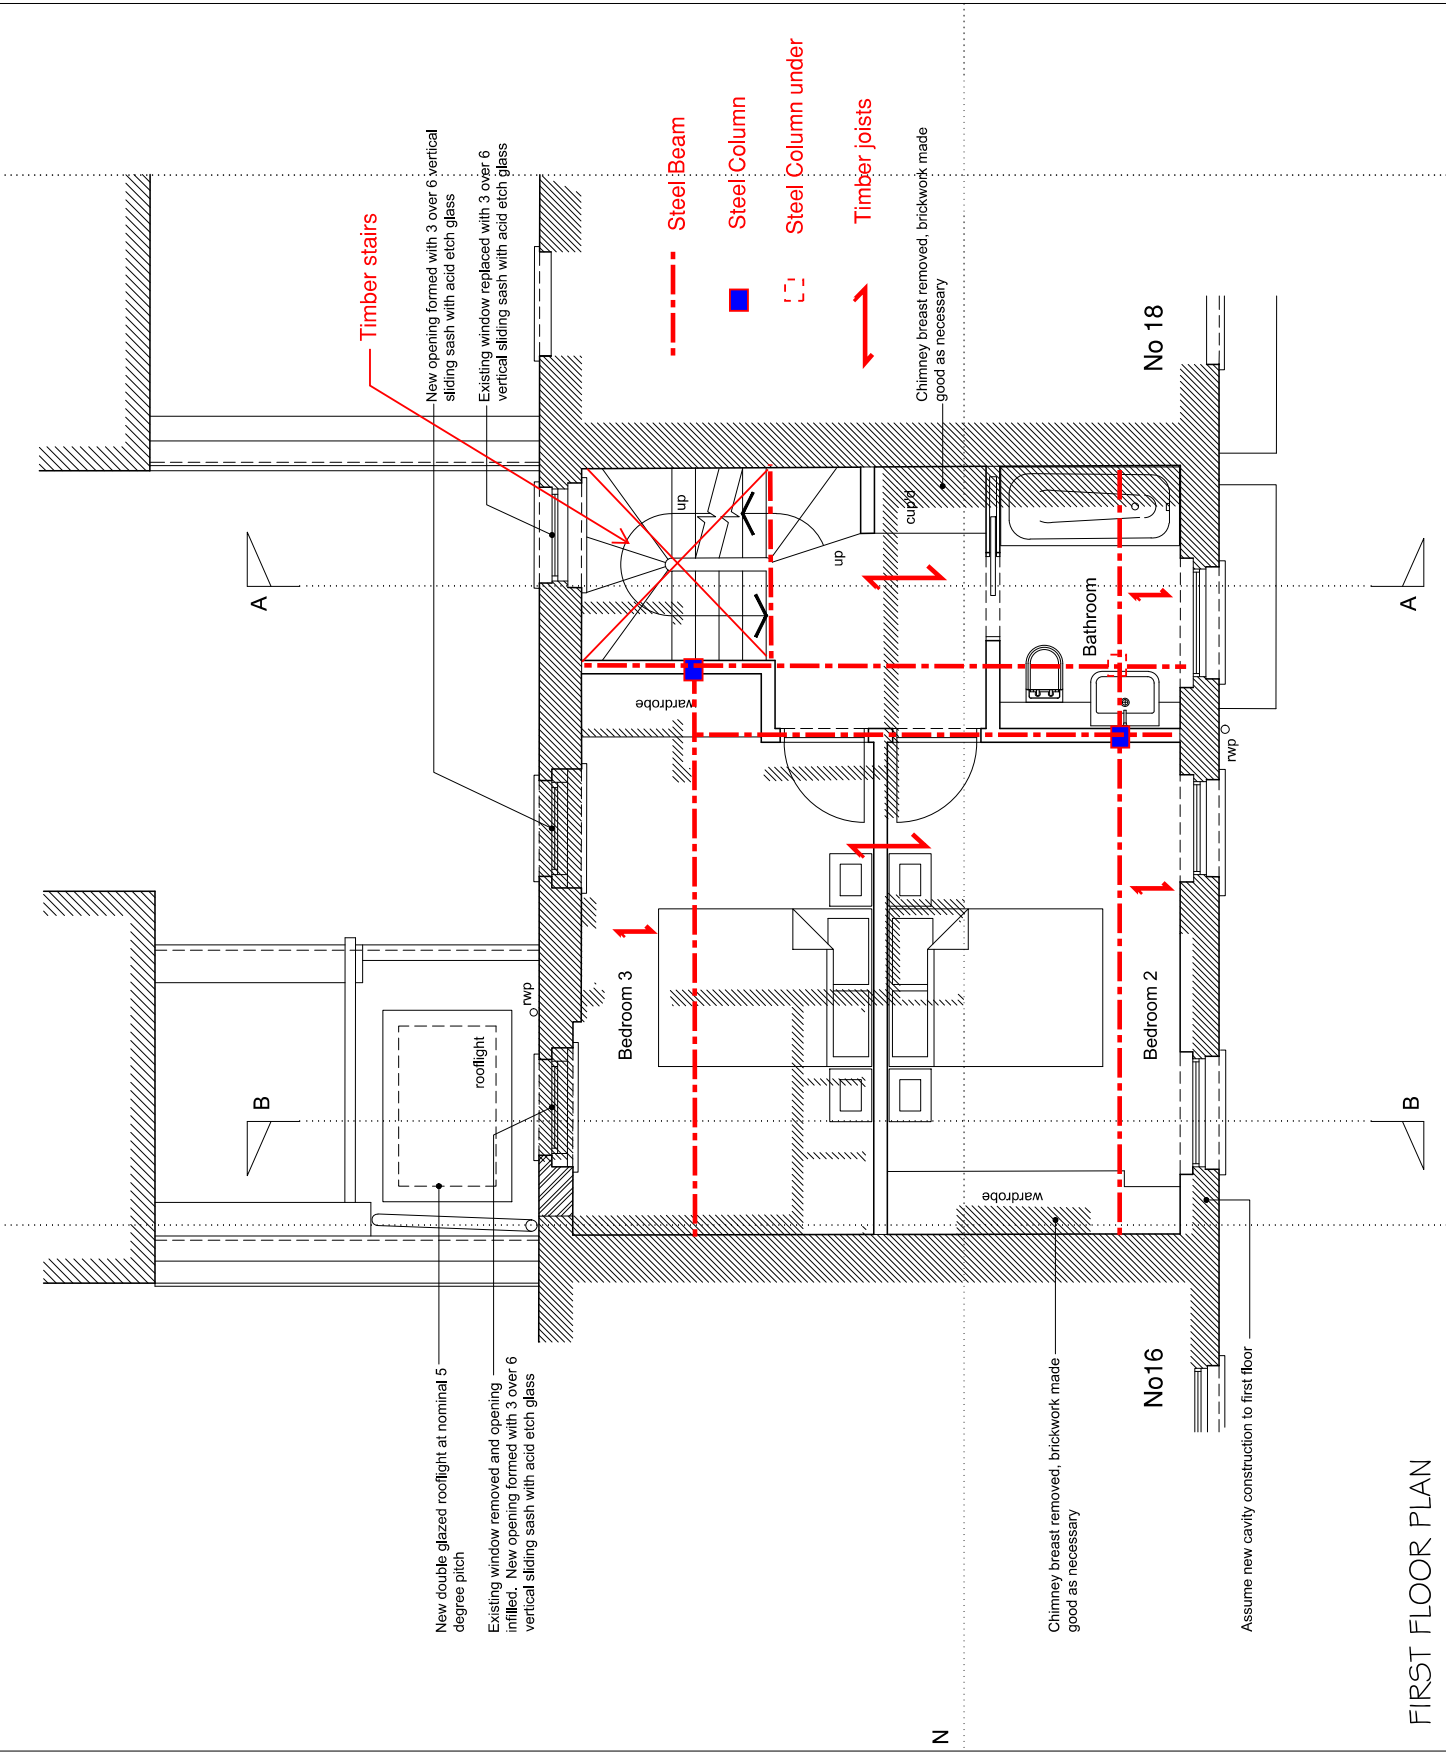

REVISIONS

GRA
architects & interior designers

1 Westmead Terrace
SW1V 4AG
T: 020 7592 2525
E: office@gradesigns.co.uk

Title
FIRST FLOOR PLAN
- As Proposed

Project
17 EATON MEWS NORTH
LONDON SW1X 8AR

Client
MR JAMES BUSTA


Scale	Date	Drawn By	Rev.
1:50@A3	MAR 2021	GR	
Job No.	Draw No.	Rev.	
363	SK/13		*

All dimensions to be checked onsite.
DO NOT SCALE THIS DRAWING

© Copyright
GRA
architects & interior designers

This confidential drawing and the copyright is the property of GRA and is neither to be copied in any way nor disclosed to any third party without the written consent of GRA

NOTES

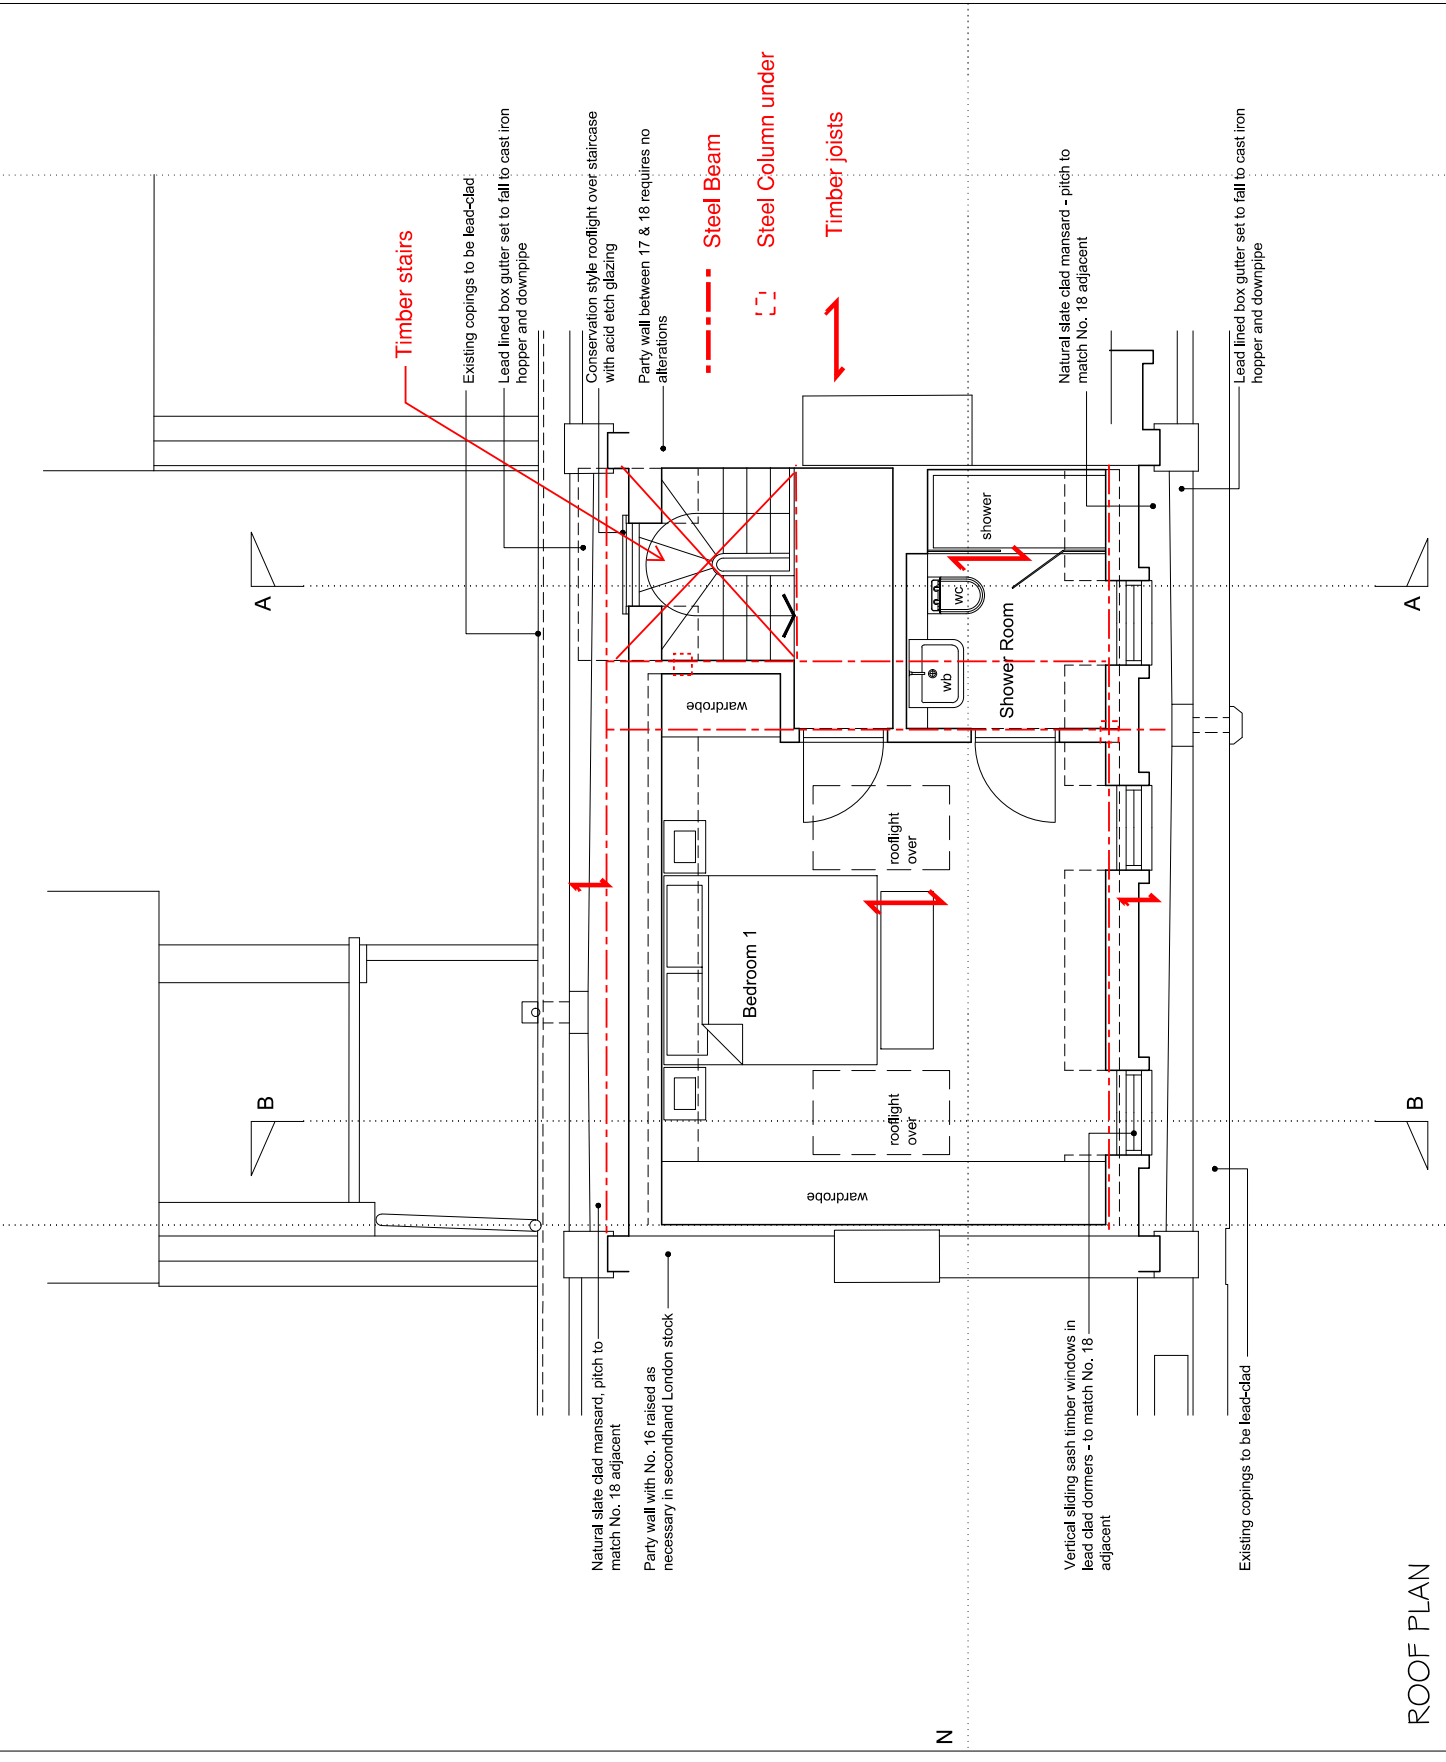

GRA
architects & interior designers


1 Westmead Terrace
SW1V 4AG
T: 020 7592 2525
E: office@gradesigns.co.uk

Title
MANSARD FLOOR PLAN
- As Proposed

Project
17 EATON MEWS NORTH
LONDON SW1X 8AR

Client
MR JAMES BUSTA

Scale	Date	Drawn By	Rev.
1:50@A3	MAR 2021	GR	
Job No.	Draw No.	Rev.	
363	SK/14		*

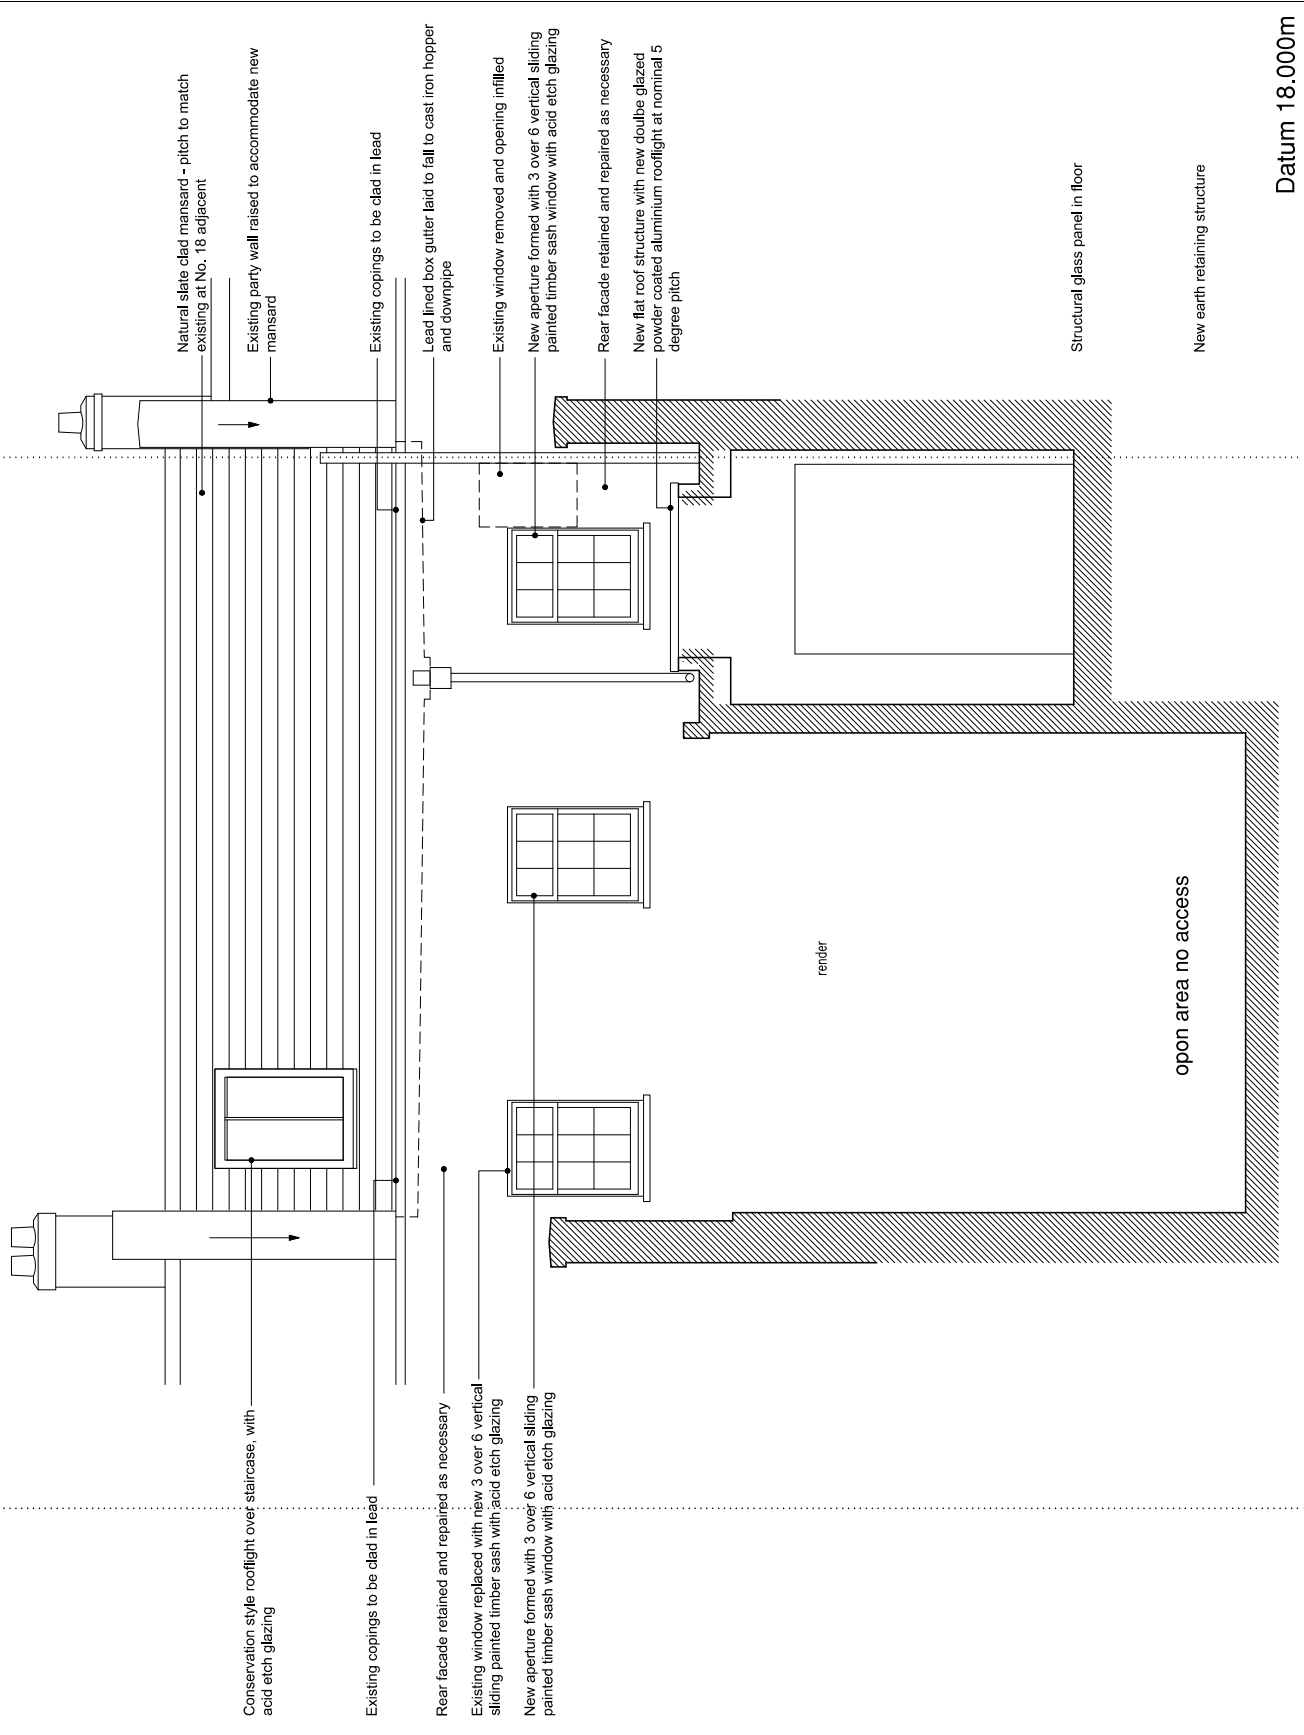

REAR ELEVATION

REVISIONS	

GRA
architects & interior designers

17 Eaton Mews North
LONDON
SW1X 8AR
T: 020 7580 2500
E: office@grarchitects.co.uk


Title
REAR ELEVATION
- As Proposed

Project
17 EATON MEWS NORTH
LONDON SW1X 8AR

Client
MR JAMES BUSTA

Scale	Date	Drawn
1:50@A3	OCT 2020	GR

Job No.	Draw No.	Rev.
363	SK/19	*

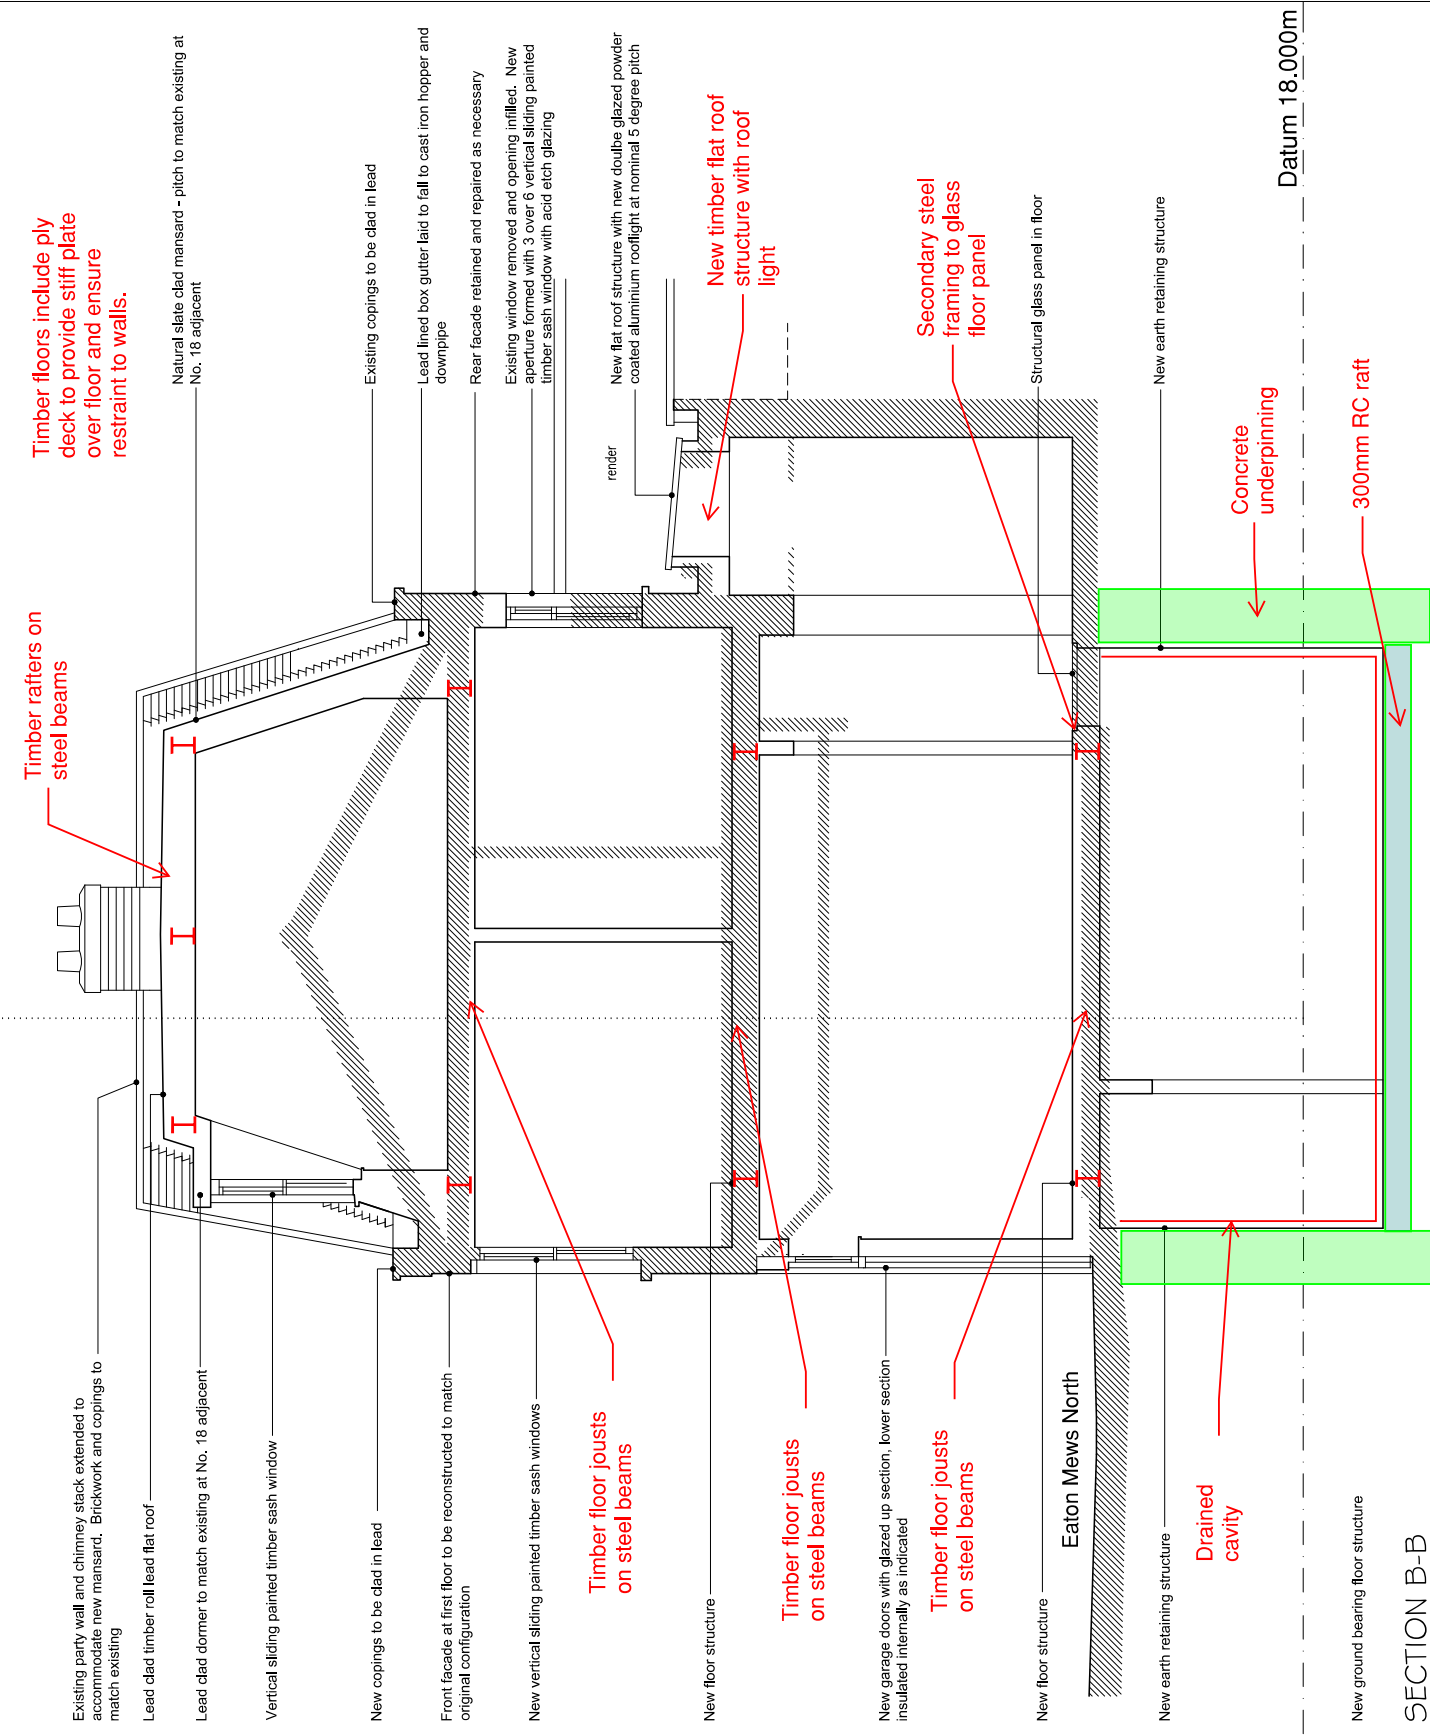

SECTION B-B

REVISIONS	

GRA
architects & interior designers

17 Eaton Mews North
LONDON
SW1X 8AR
T: 020 7580 2500
E: office@grarchitects.co.uk

Title
SECTION B-B
- As Proposed

Project
17 EATON MEWS NORTH
LONDON SW1X 8AR

Client
MR JAMES BUSTA

Scale	Date	Drawn
1:50@A3	OCT 2020	GR

Job No.	Draw No.	Rev.
363	SK/17	*

© Copyright GRA

This confidential drawing and the copyright is

NOTES

NOTES

architecture & interiors ltd

SECTION A-A

Proposed
 ION A-A

DON SWIX 8AR

Date	
------	--

Dwg No.	SK11C
Rev	

SECTION A-A

© Copyright GRA

the property of GRA and is neither to be copied in any way nor disclosed to any third party without the written consent of GRA

1

architecture & interiors ltd

POINT ELEVATION

Proposed

DON SWIX 8AF

Date	
------	--

Dwg No. SK18

1000

FRONT ELEVATION

No 18