
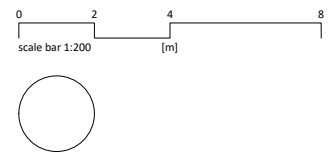


PLANNING

- Note:
- For planning purposes only
 - Levels may vary by +/-25cm

- Key:
- Site Boundary
 - ▨ Location of amendment
 - ← Amendment notes

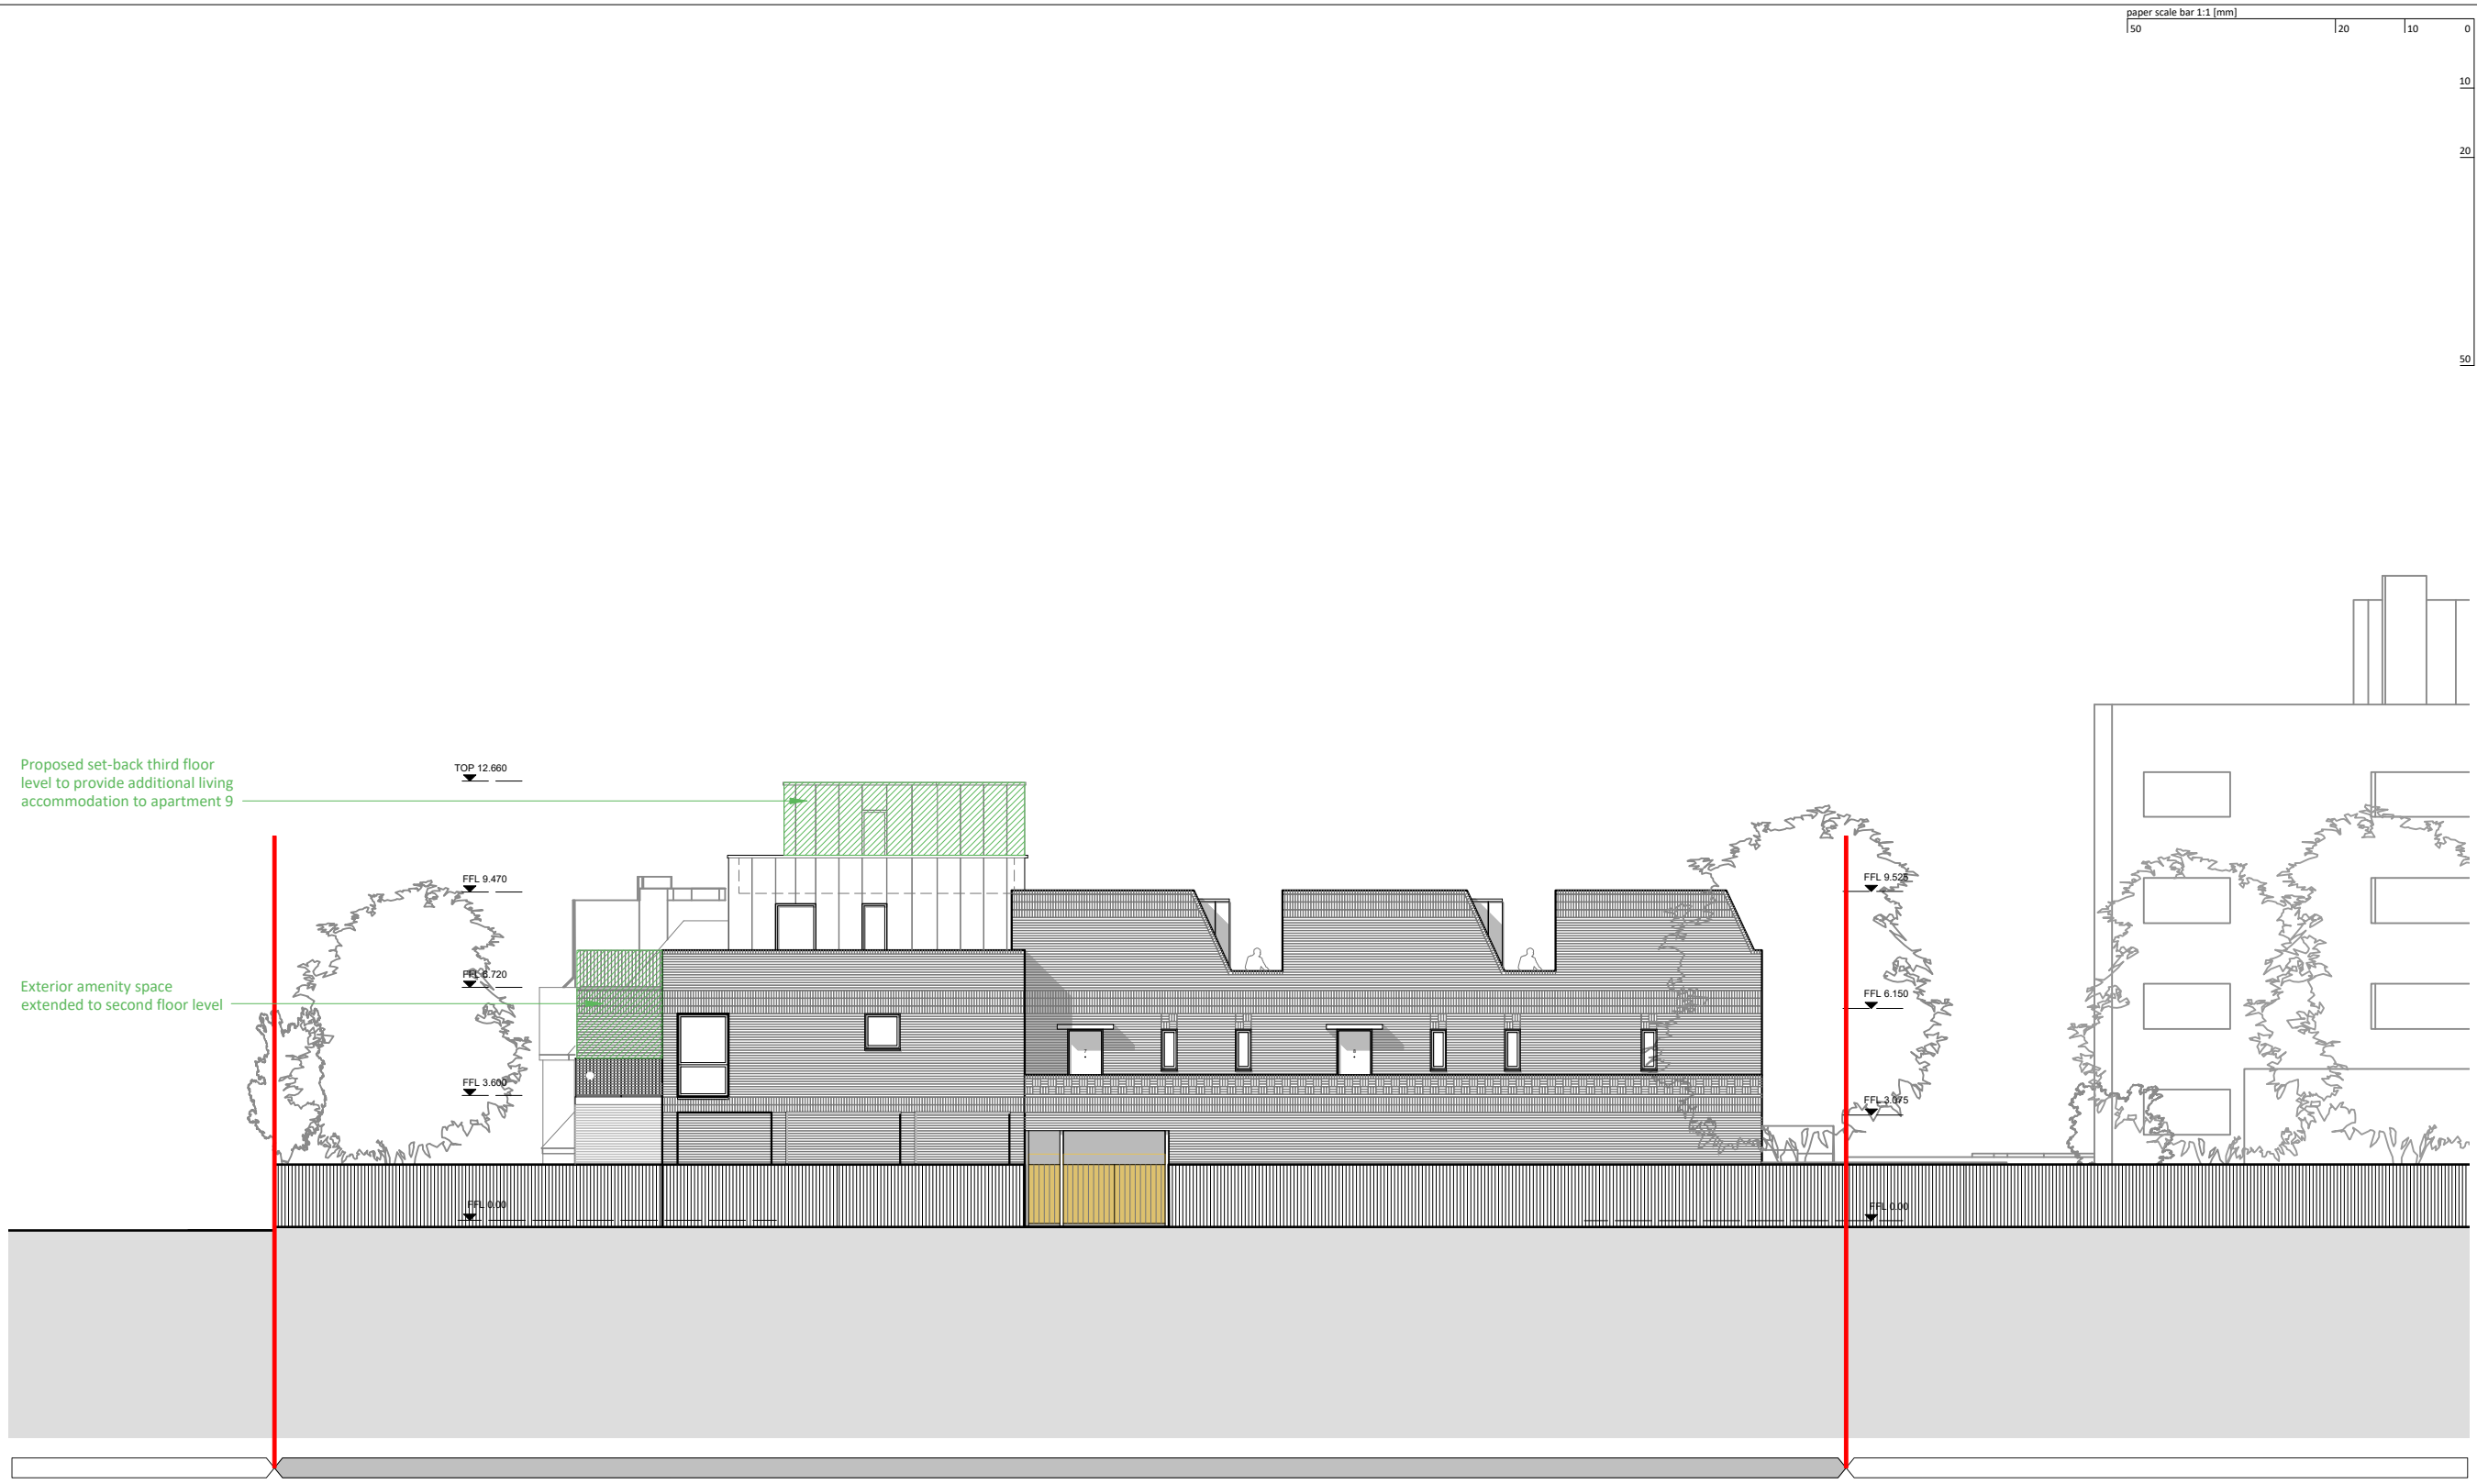

Rev.	Date	Description
P1	13.05.21	Planning application issue

BELLINGHAM ROAD

APPLICATION SITE

PASSFIELDS ESTATE

DRAWING MARKED-UP TO SHOW PROPOSED AMENDMENTS

NEWTON
ARCHITECTURE LTD

e. alistair@newtonarchitecture.co.uk

Project 4 Bellingham Road		
Title Proposed West Elevation		
Drawing no. 2002 - M - 623		
Date 13.05.21	Rev. P1	Scale 1:200@A3/1:100@A1
© Newton Architecture Ltd		