



PLANNING

Note:

- For planning purposes only
- Levels may vary by +/-25cm

Key:

- Site Boundary
- ▨ Location of amendment
- ← Amendment notes

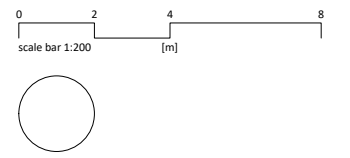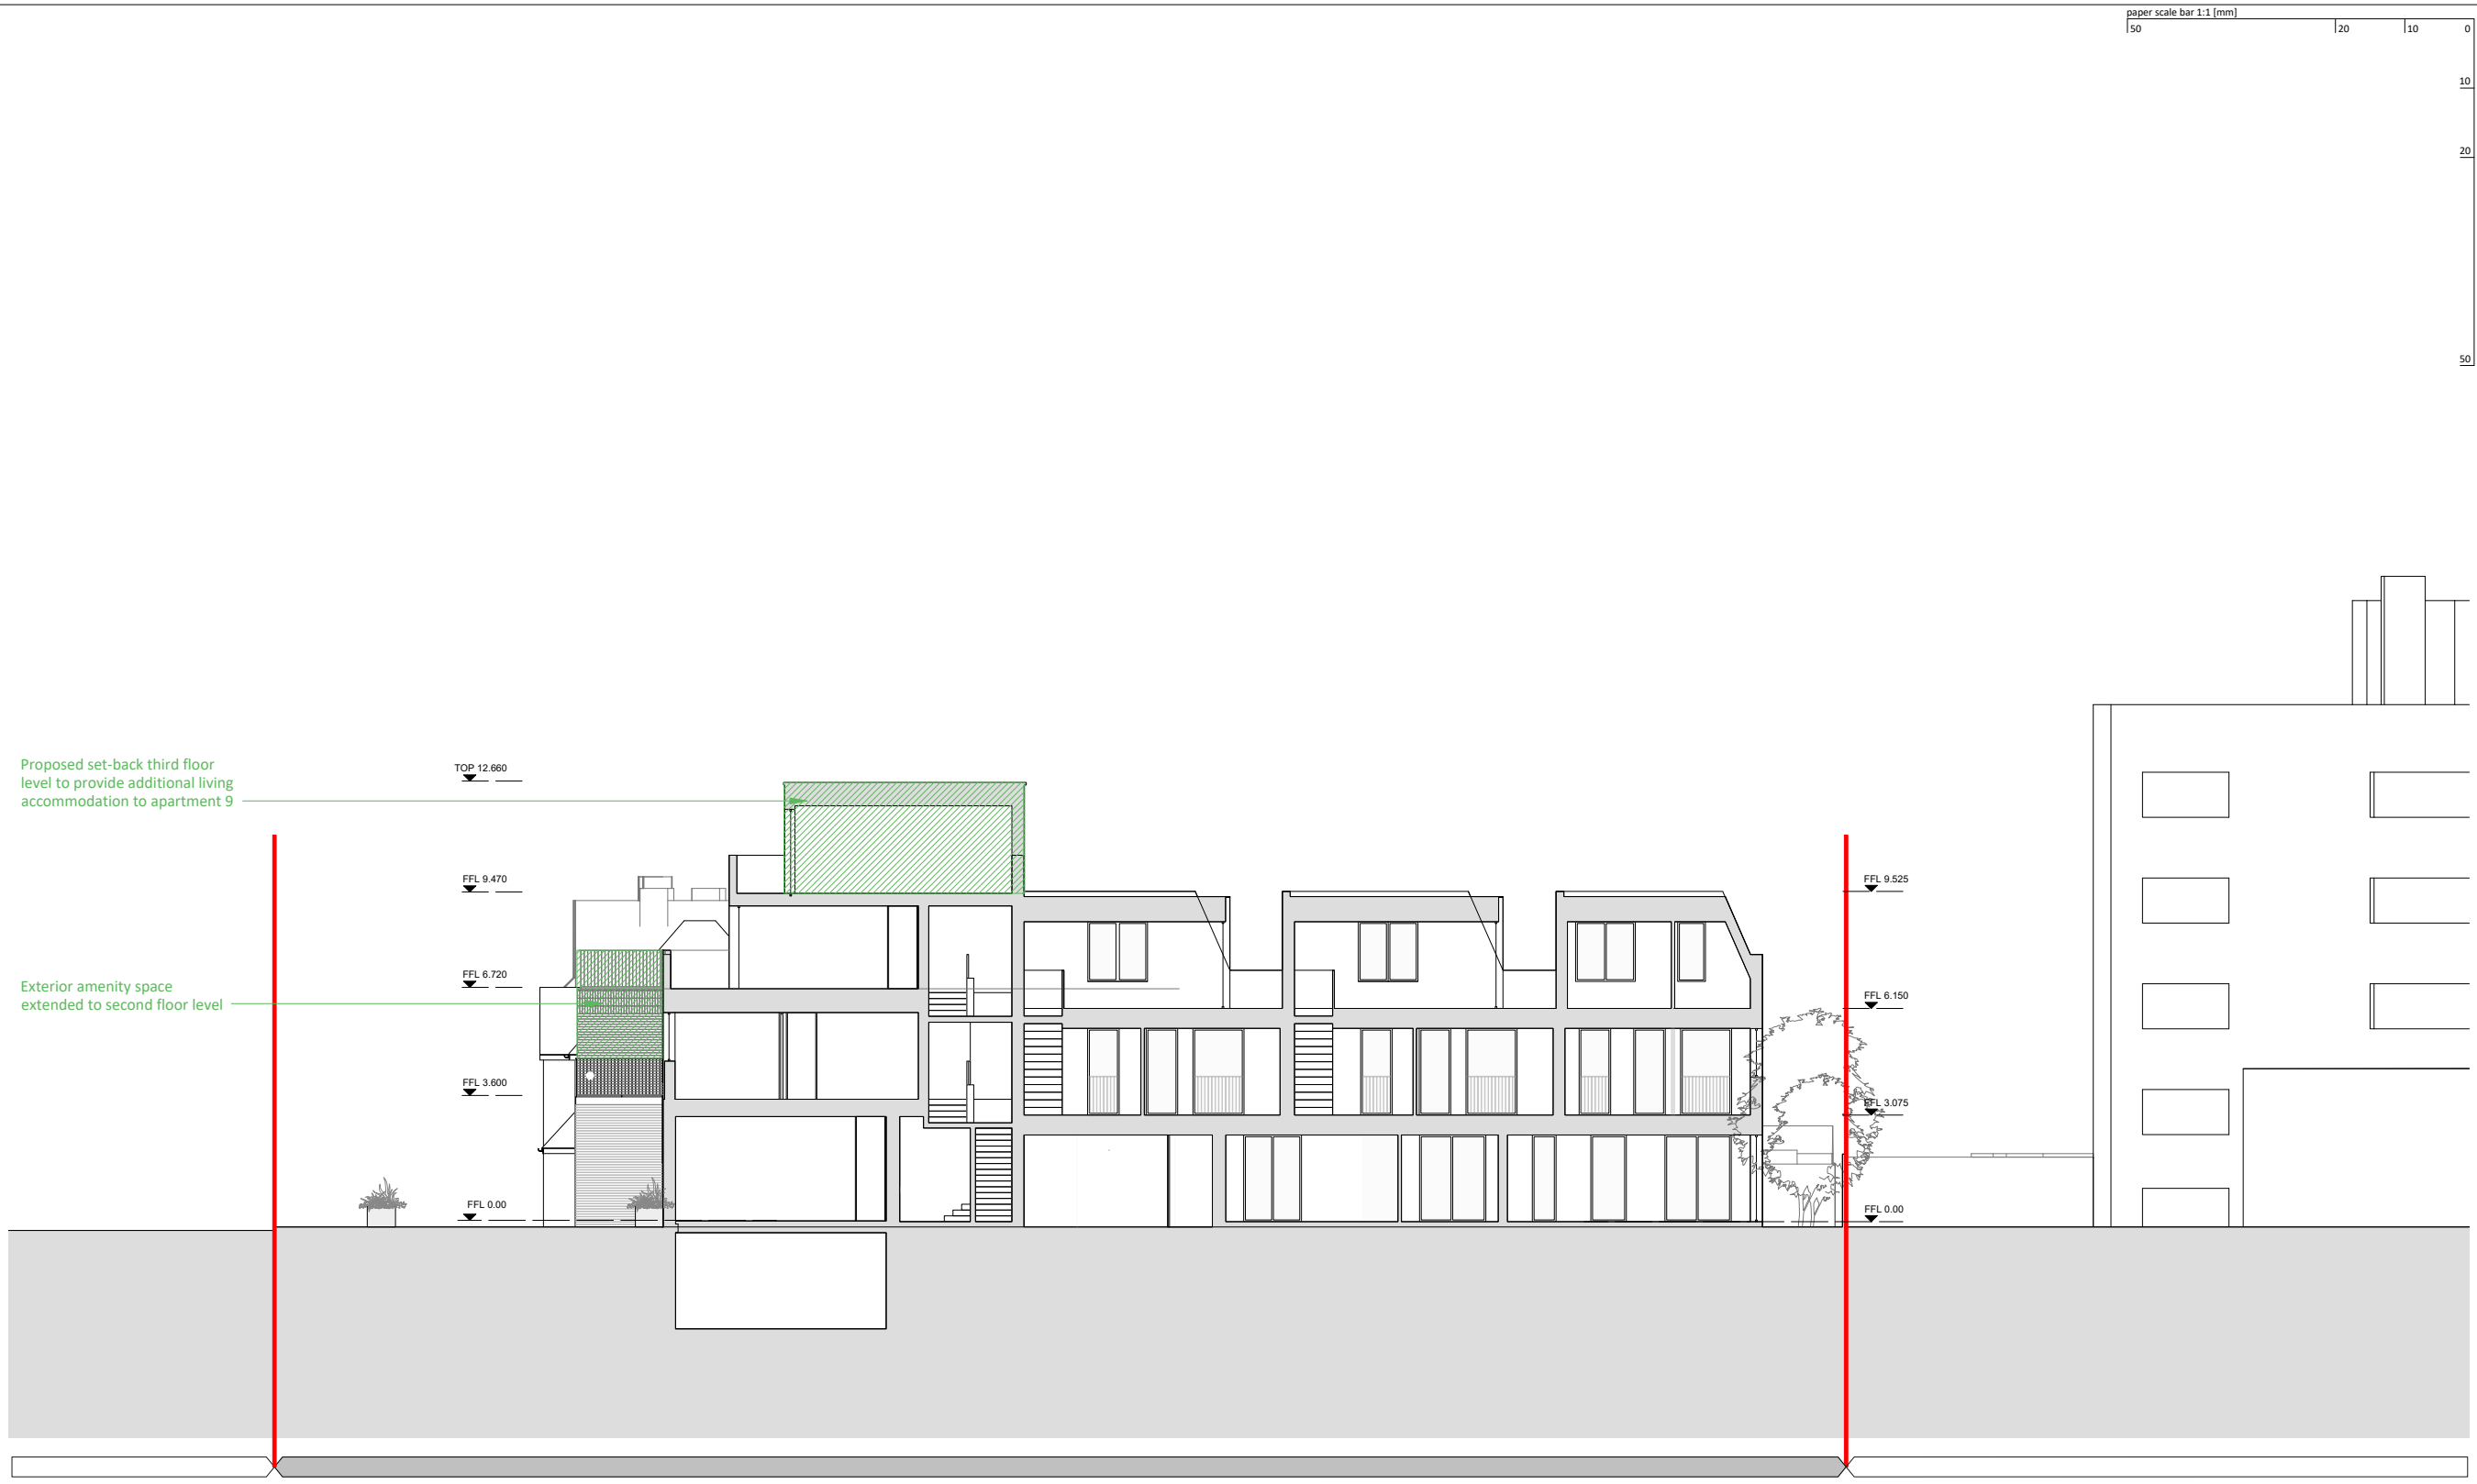

Rev.	Date	Description
P1	13.05.21	Planning application issue

BELLINGHAM ROAD

APPLICATION SITE

PASSFIELDS ESTATE

DRAWING MARKED-UP TO SHOW PROPOSED AMENDMENTS

NEWTON

ARCHITECTURE LTD

e. alistair@newtonarchitecture.co.uk

Project
4 Bellingham Road

Title
Proposed Section AA

Drawing no.
2002 - M - 630

Date	Rev.	Scale
13.05.21	P1	1:200@A3/1:100@A1

© Newton Architecture Ltd