


# PLANNING

Note:



- For planning purposes only
- Levels may vary by +/-25cm

Key:

- Site Boundary
- ▨ Location of amendment
- ← Amendment notes

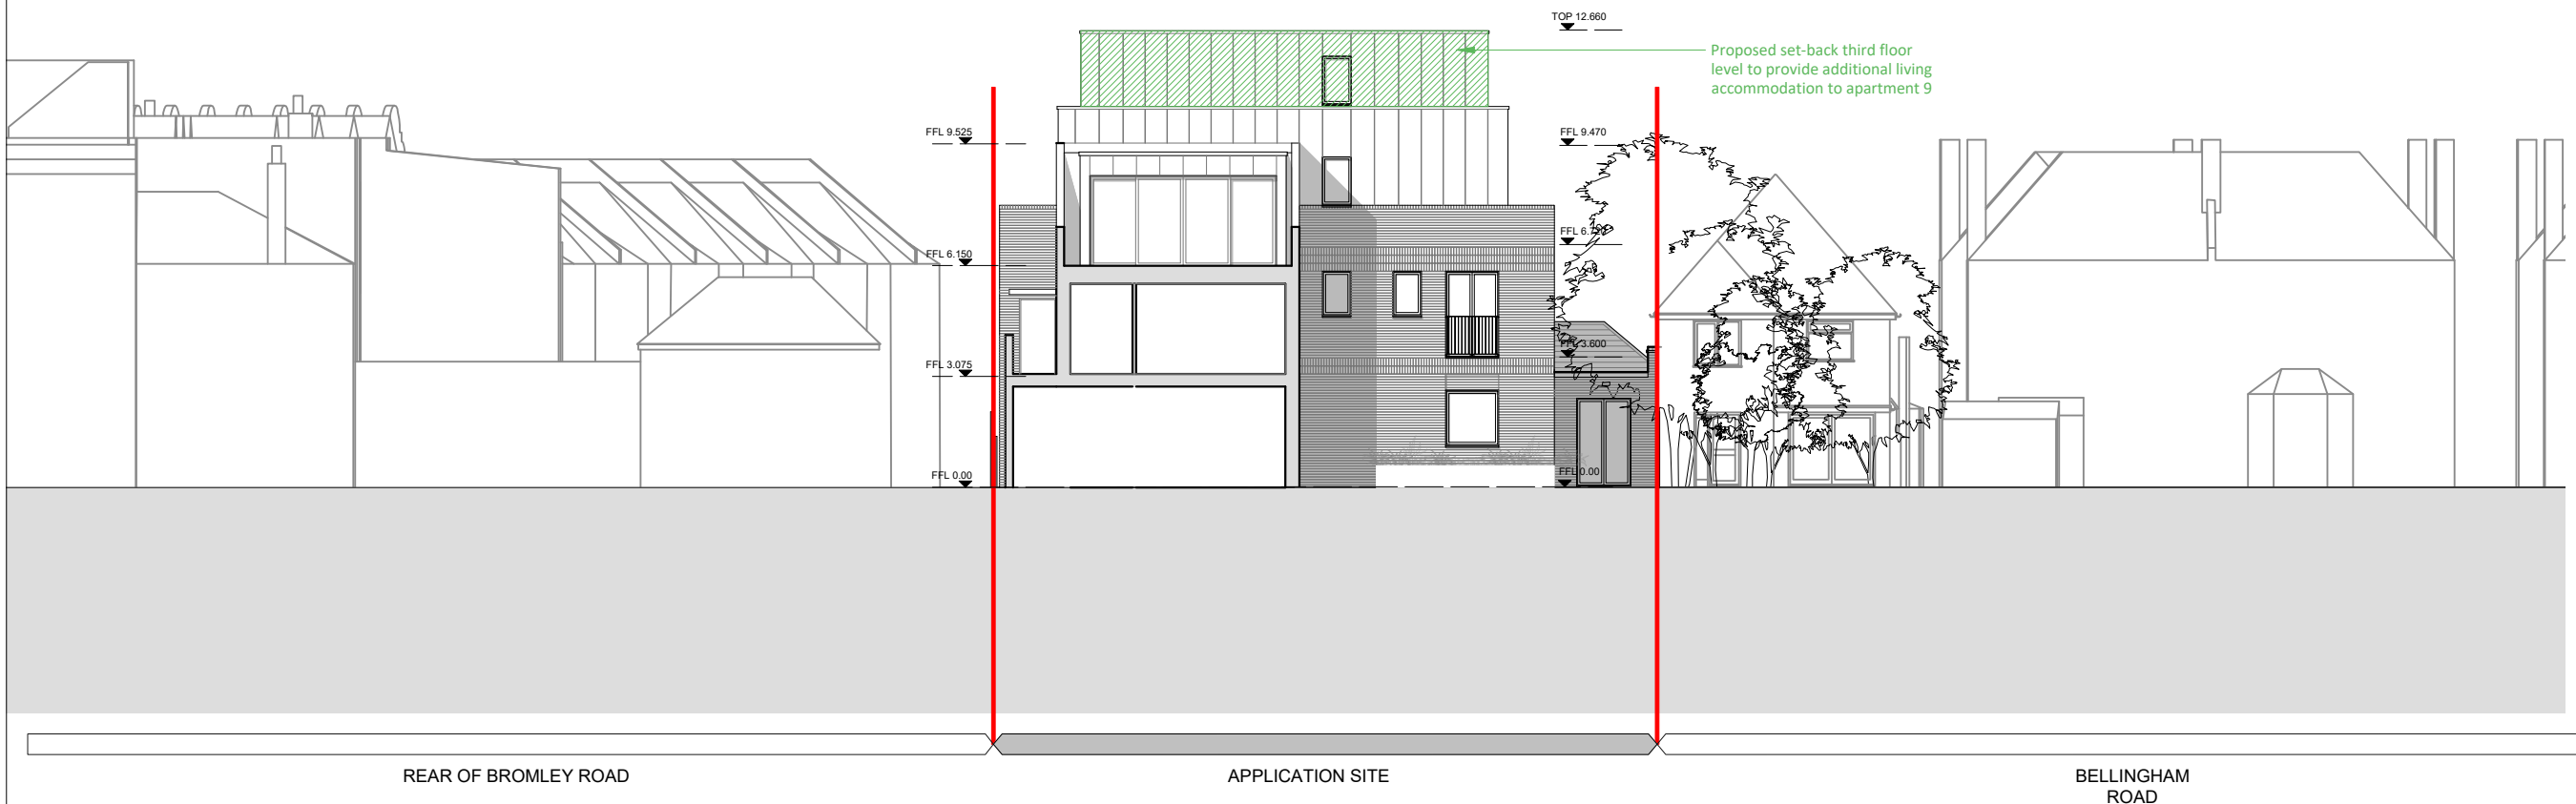

Proposed set-back third floor level to provide additional living accommodation to apartment 9

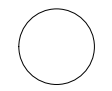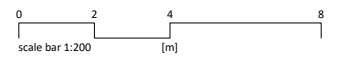

| Rev. | Date     | Description                |
|------|----------|----------------------------|
| P1   | 13.05.21 | Planning application issue |

## NEWTON ARCHITECTURE LTD

e. alistair@newtonarchitecture.co.uk

|                               |            |                            |
|-------------------------------|------------|----------------------------|
| Project<br>4 Bellingham Road  |            |                            |
| Title<br>Proposed Section BB  |            |                            |
| Drawing no.<br>2002 - M - 631 |            |                            |
| Date<br>13.05.21              | Rev.<br>P1 | Scale<br>1:200@A3/1:100@A1 |
| © Newton Architecture Ltd     |            |                            |

DRAWING MARKED-UP TO SHOW PROPOSED AMENDMENTS