




PLANNING

Note:

- For planning purposes only
- Levels may vary by +/-25cm

Key:

- Site Boundary
- ▨ Location of amendment
- ← Amendment notes

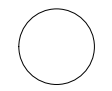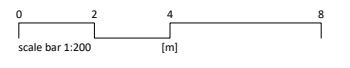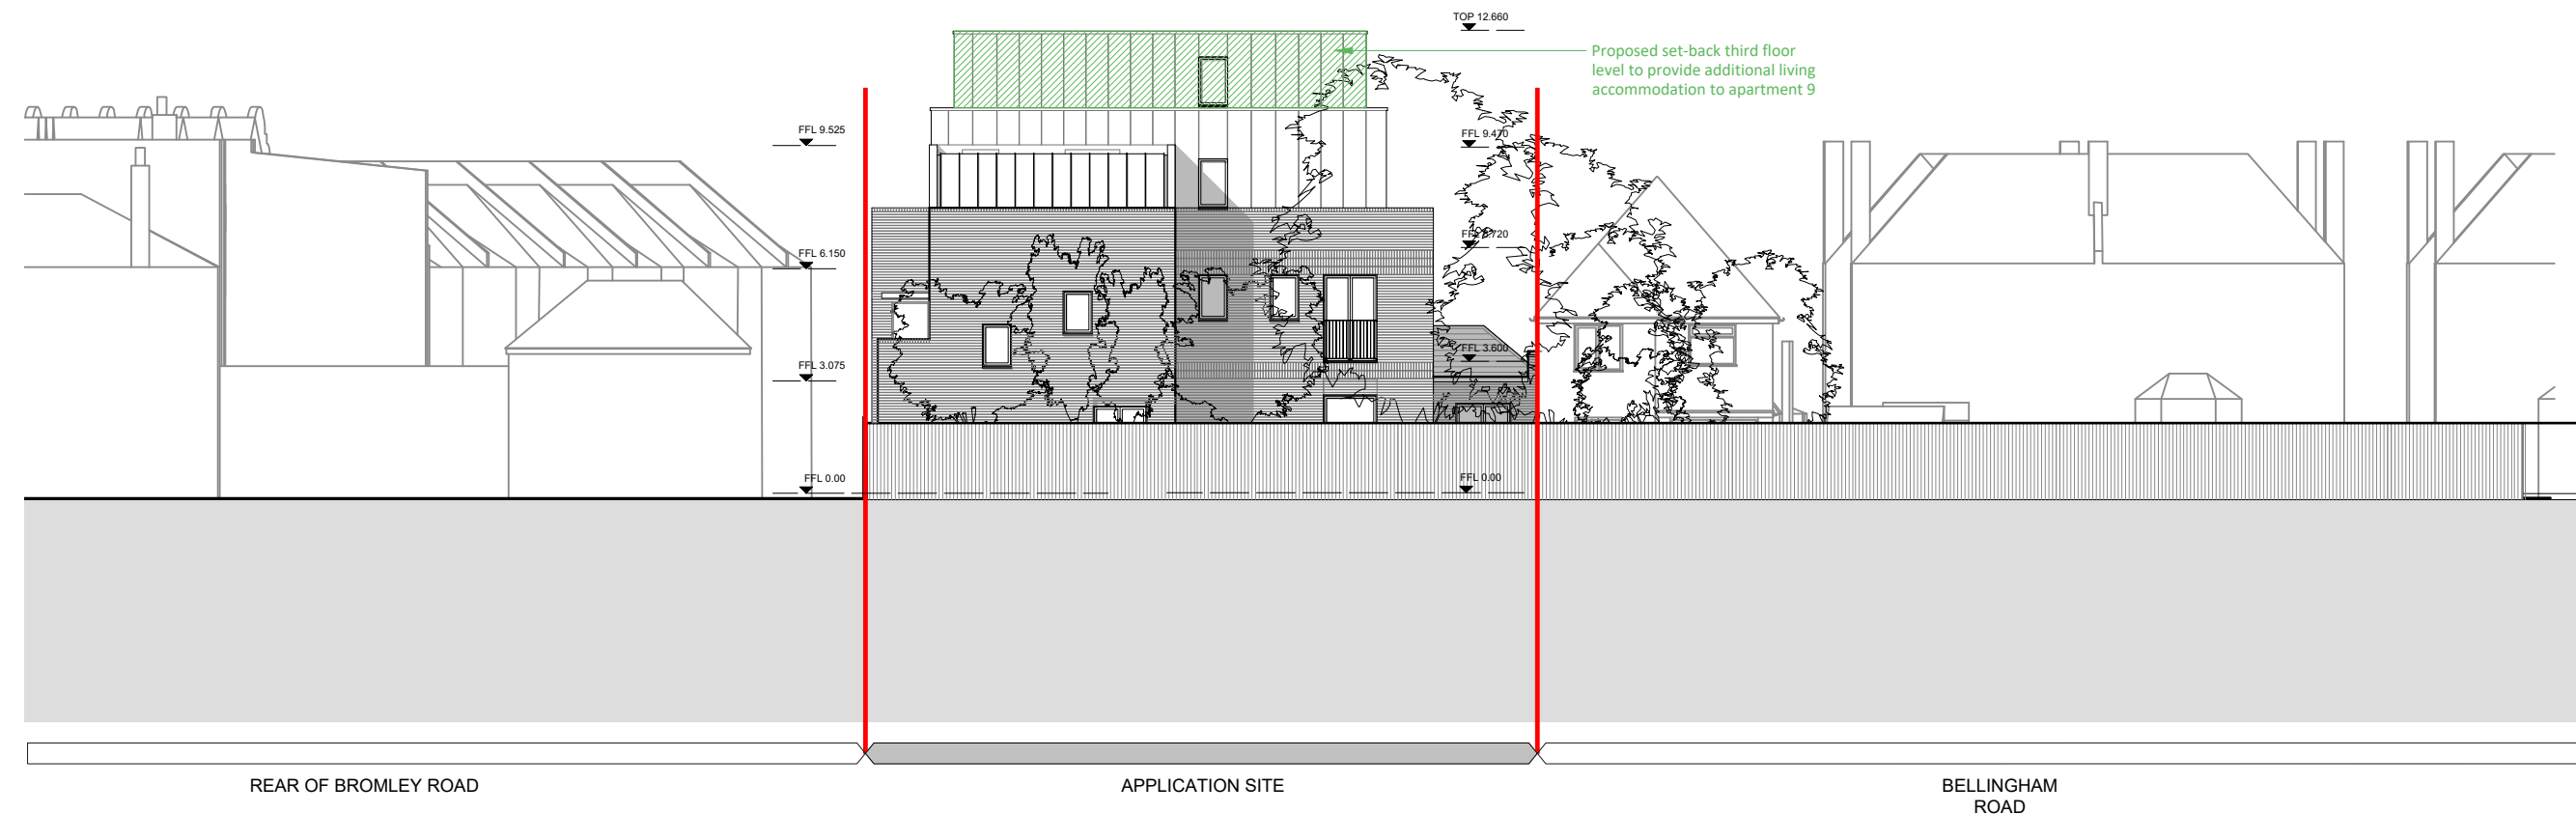

Rev.	Date	Description
P1	13.05.21	Planning application issue

NEWTON ARCHITECTURE LTD

e. alistair@newtonarchitecture.co.uk

Project 4 Bellingham Road		
Title Proposed South Elevation		
Drawing no. 2002 - M - 622		
Date 13.05.21	Rev. P1	Scale 1:200@A3/1:100@A1
© Newton Architecture Ltd		

DRAWING MARKED-UP TO SHOW PROPOSED AMENDMENTS