


EXISTING SAND - RELOCATED AND GRANTED UNDER APPLICATION R/00065/HOUSE

- NEW TUBER FENCE
 - 100VIBRAN CONCRETE POSTS, PAINTED BLACK
 - 300mm CONCRETE PANEL BANDS (600mm WERE RETAINING WALL DEMOLISHED). PAINTED BLACK
 - LATTICE TOP TUBER FENCE PANELS HEIGHT VARIES 1.8m - 2.4m
- PROPOSED SCREENING
 - SUMMER + WINTER SHADE (BATHOUSE/BRUSH BIN/SHEDS) PLANTED IN FRONT (PADDOCK) OF TUBER FENCE.
 - MAXIMUM OVERALL HEIGHT TRAINED TO GROW 3m AND SPREAD ALONG FENCE

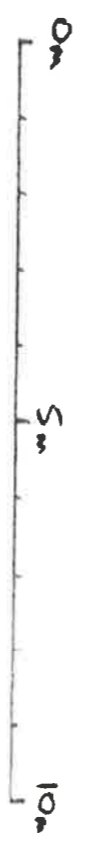

BOLD OUTLINE - ORIGINAL FOOTPRINT

NEW EXTENSION - GRANTED UNDER APPLICATION R/00065/HOUSE

SITE / BLOCK PLAN
 AS BUILT & PROPOSED

71, NEWLANDS COTTAGES
 STONES CROSS RD
 CLACKEN HILL B28 8LT
 MAT 21 - REV SUR 21

SCALE 1:100 AT A3