

INFORMATION	
CLIENT APPROVAL	
BUILDING WARRANT	
PLANNING	X
LISTED BUILDING	
TENDER	
CONSTRUCTION	
AS BUILT	
FEASIBILITY	



GENERAL NOTES




ELEVATION A- SCALE 1:100




ELEVATION B- SCALE 1:100

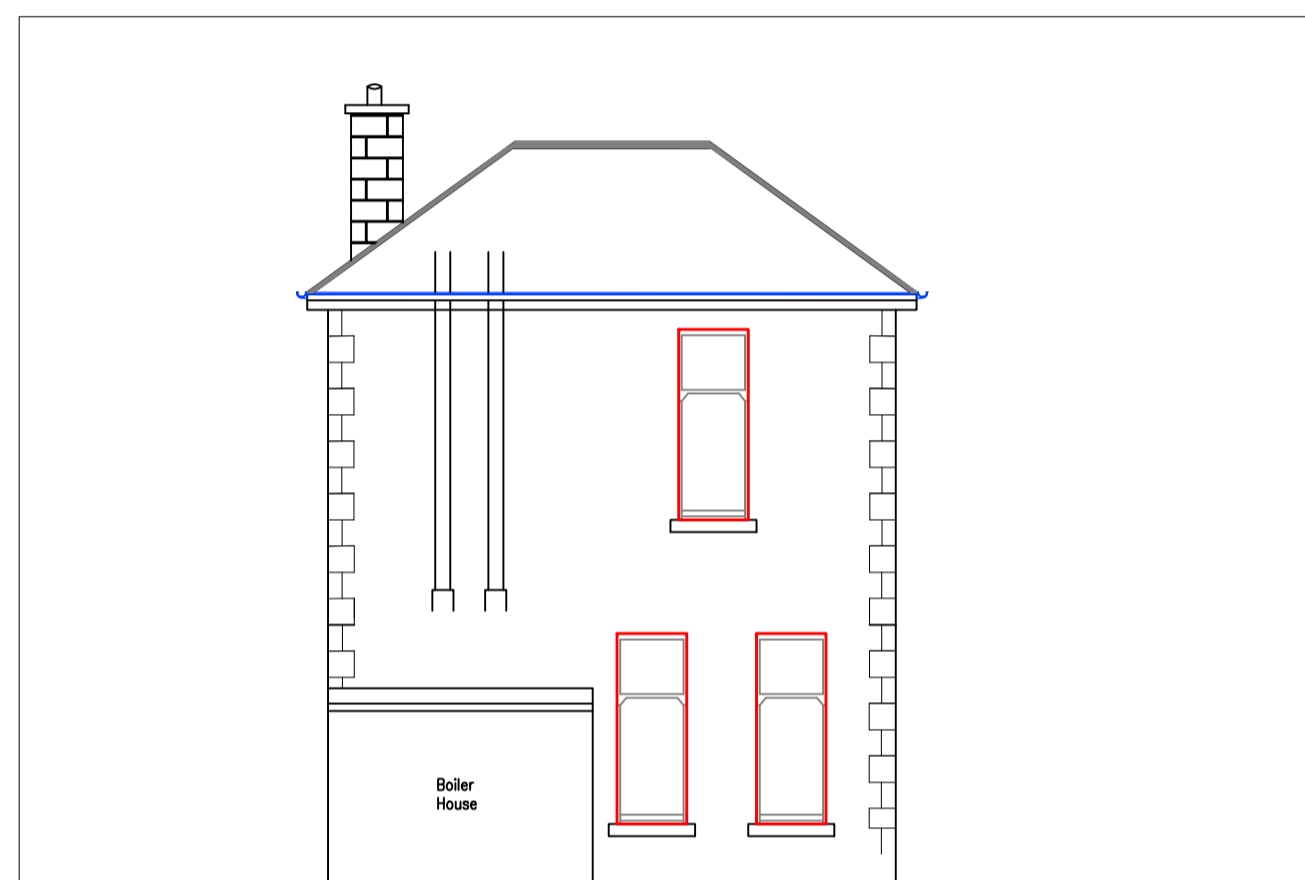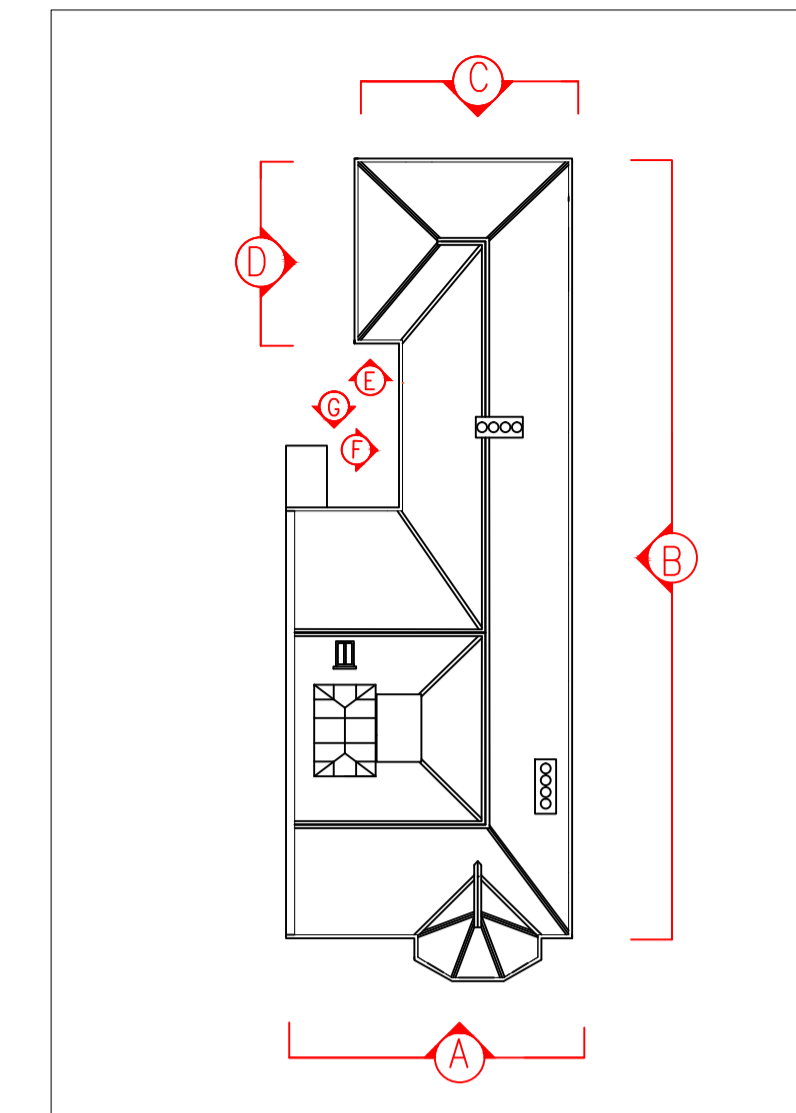


ELEVATION C- SCALE 1:100

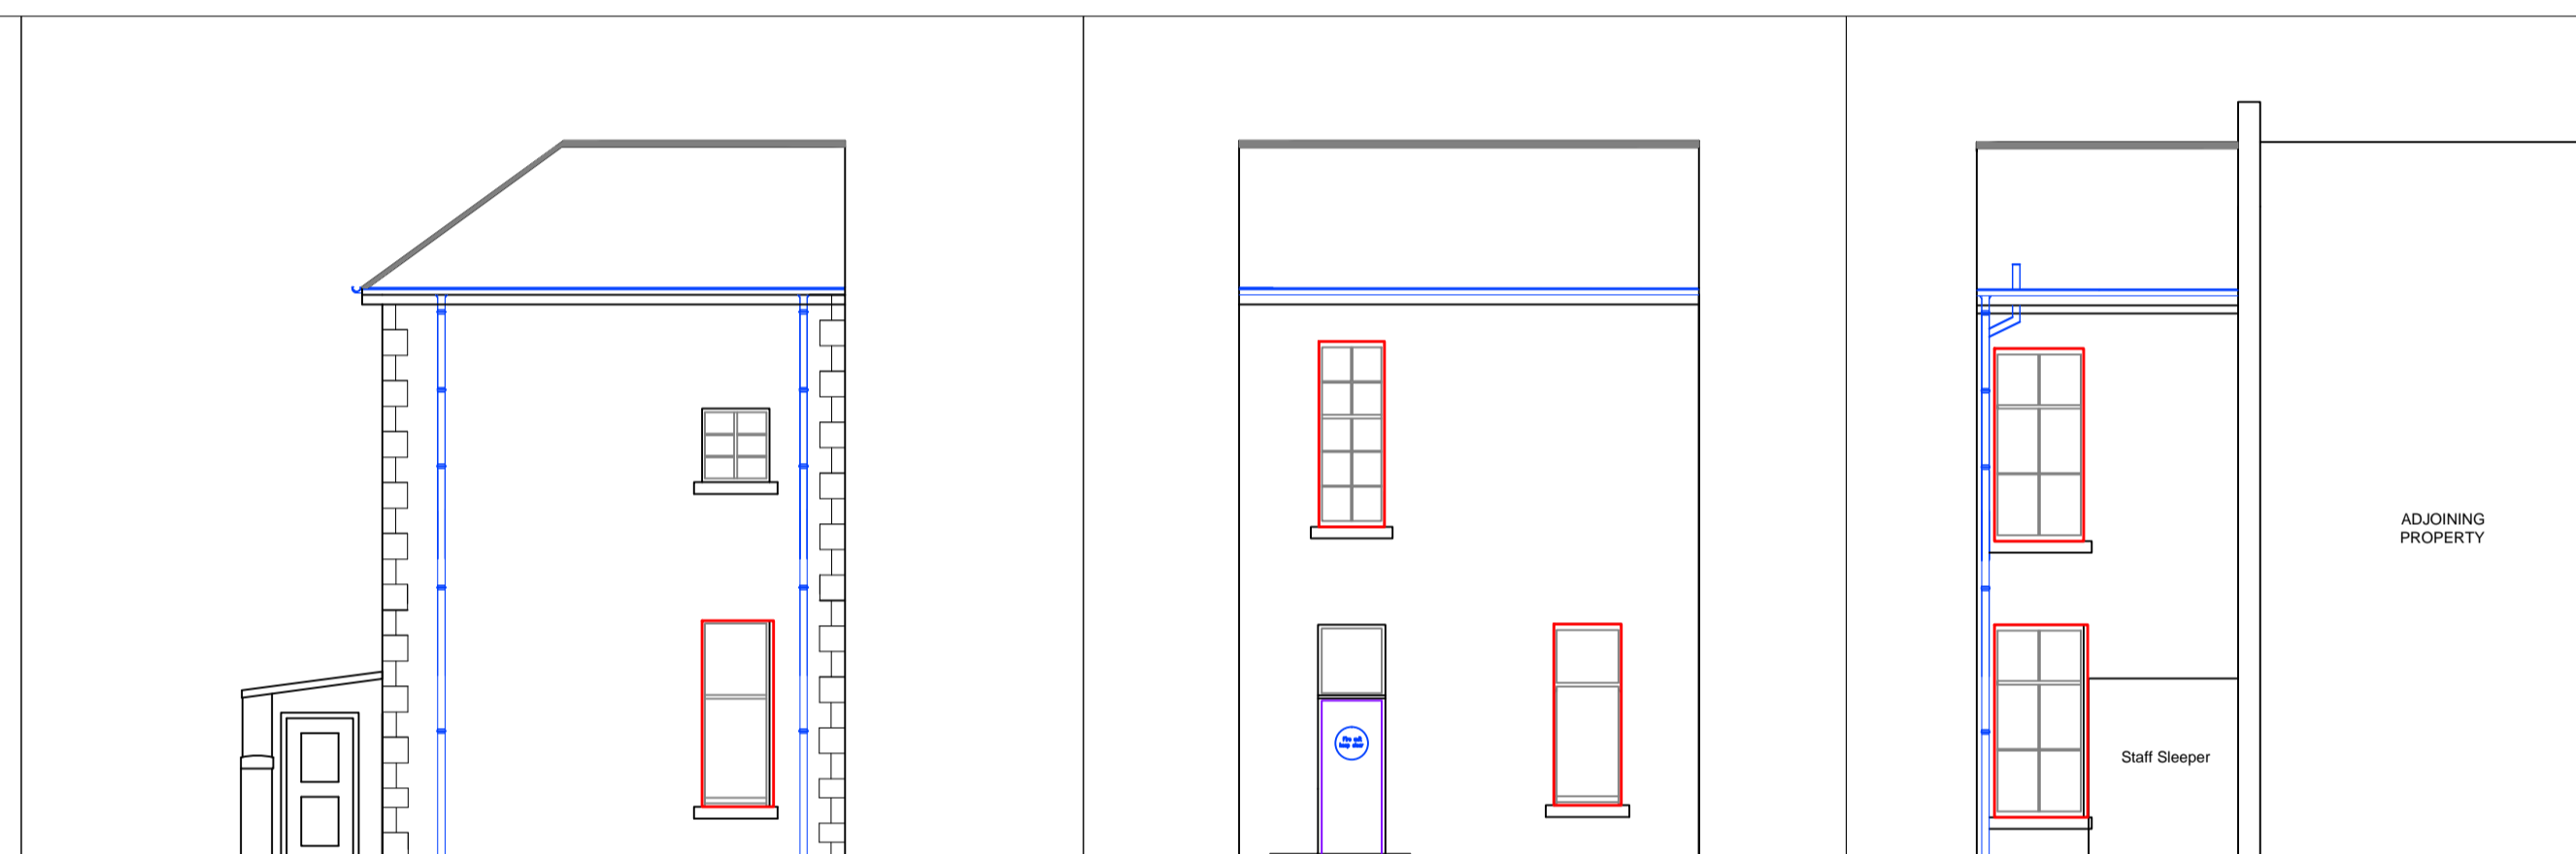

ELEVATION D- SCALE 1:100

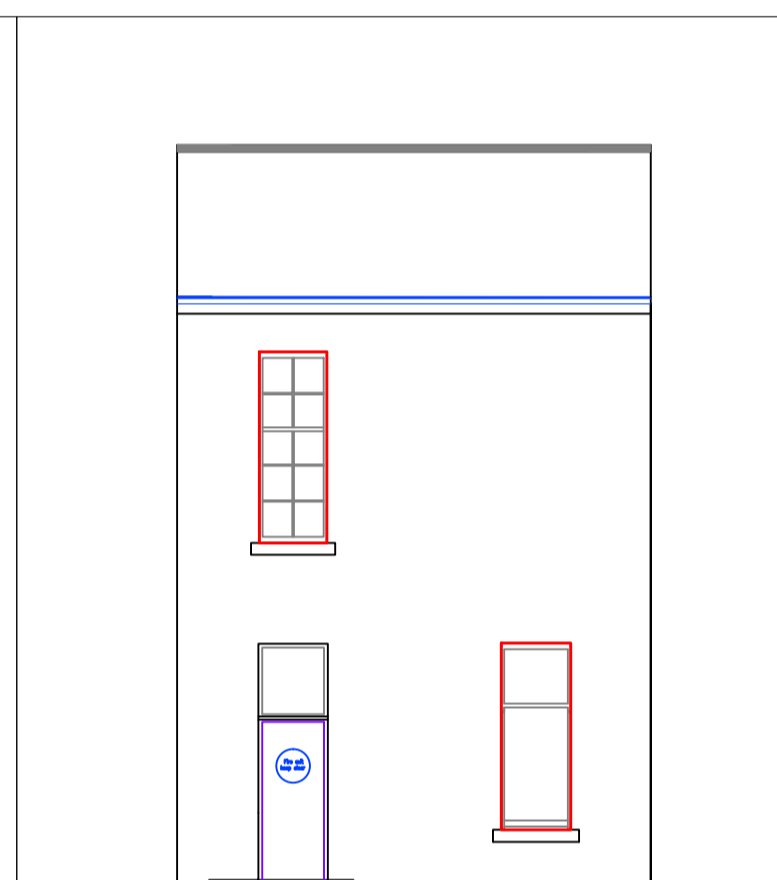


ELEVATION F- SCALE 1:100

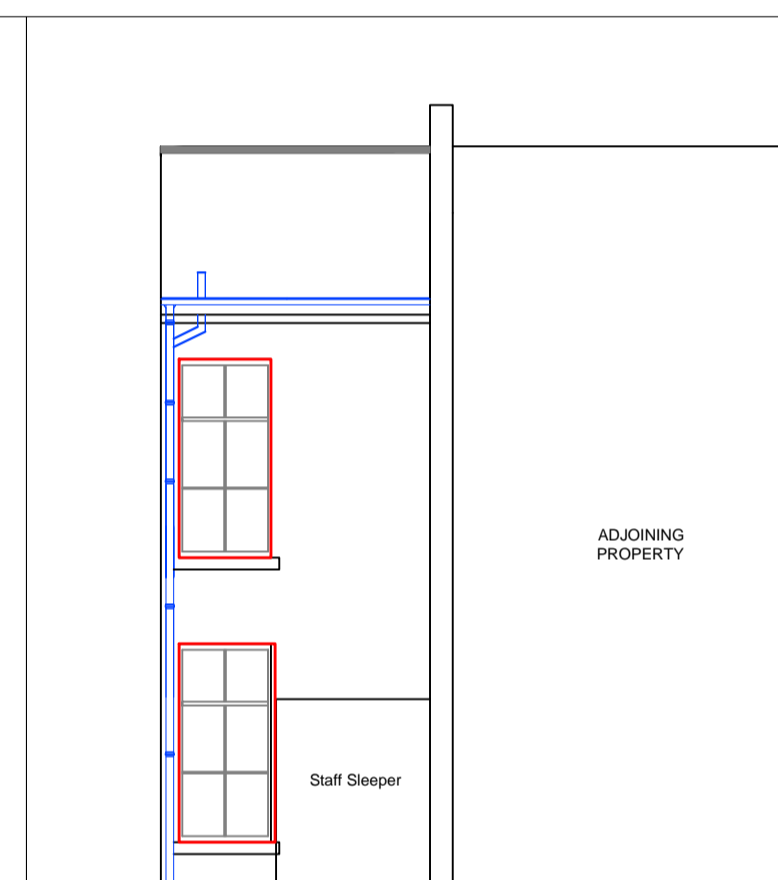


ELEVATION G- SCALE 1:100

WINDOWS:
Down takings:
 Carefully takeout and remove the existing windows. Make good the surrounds leaving ready to receive the new windows.

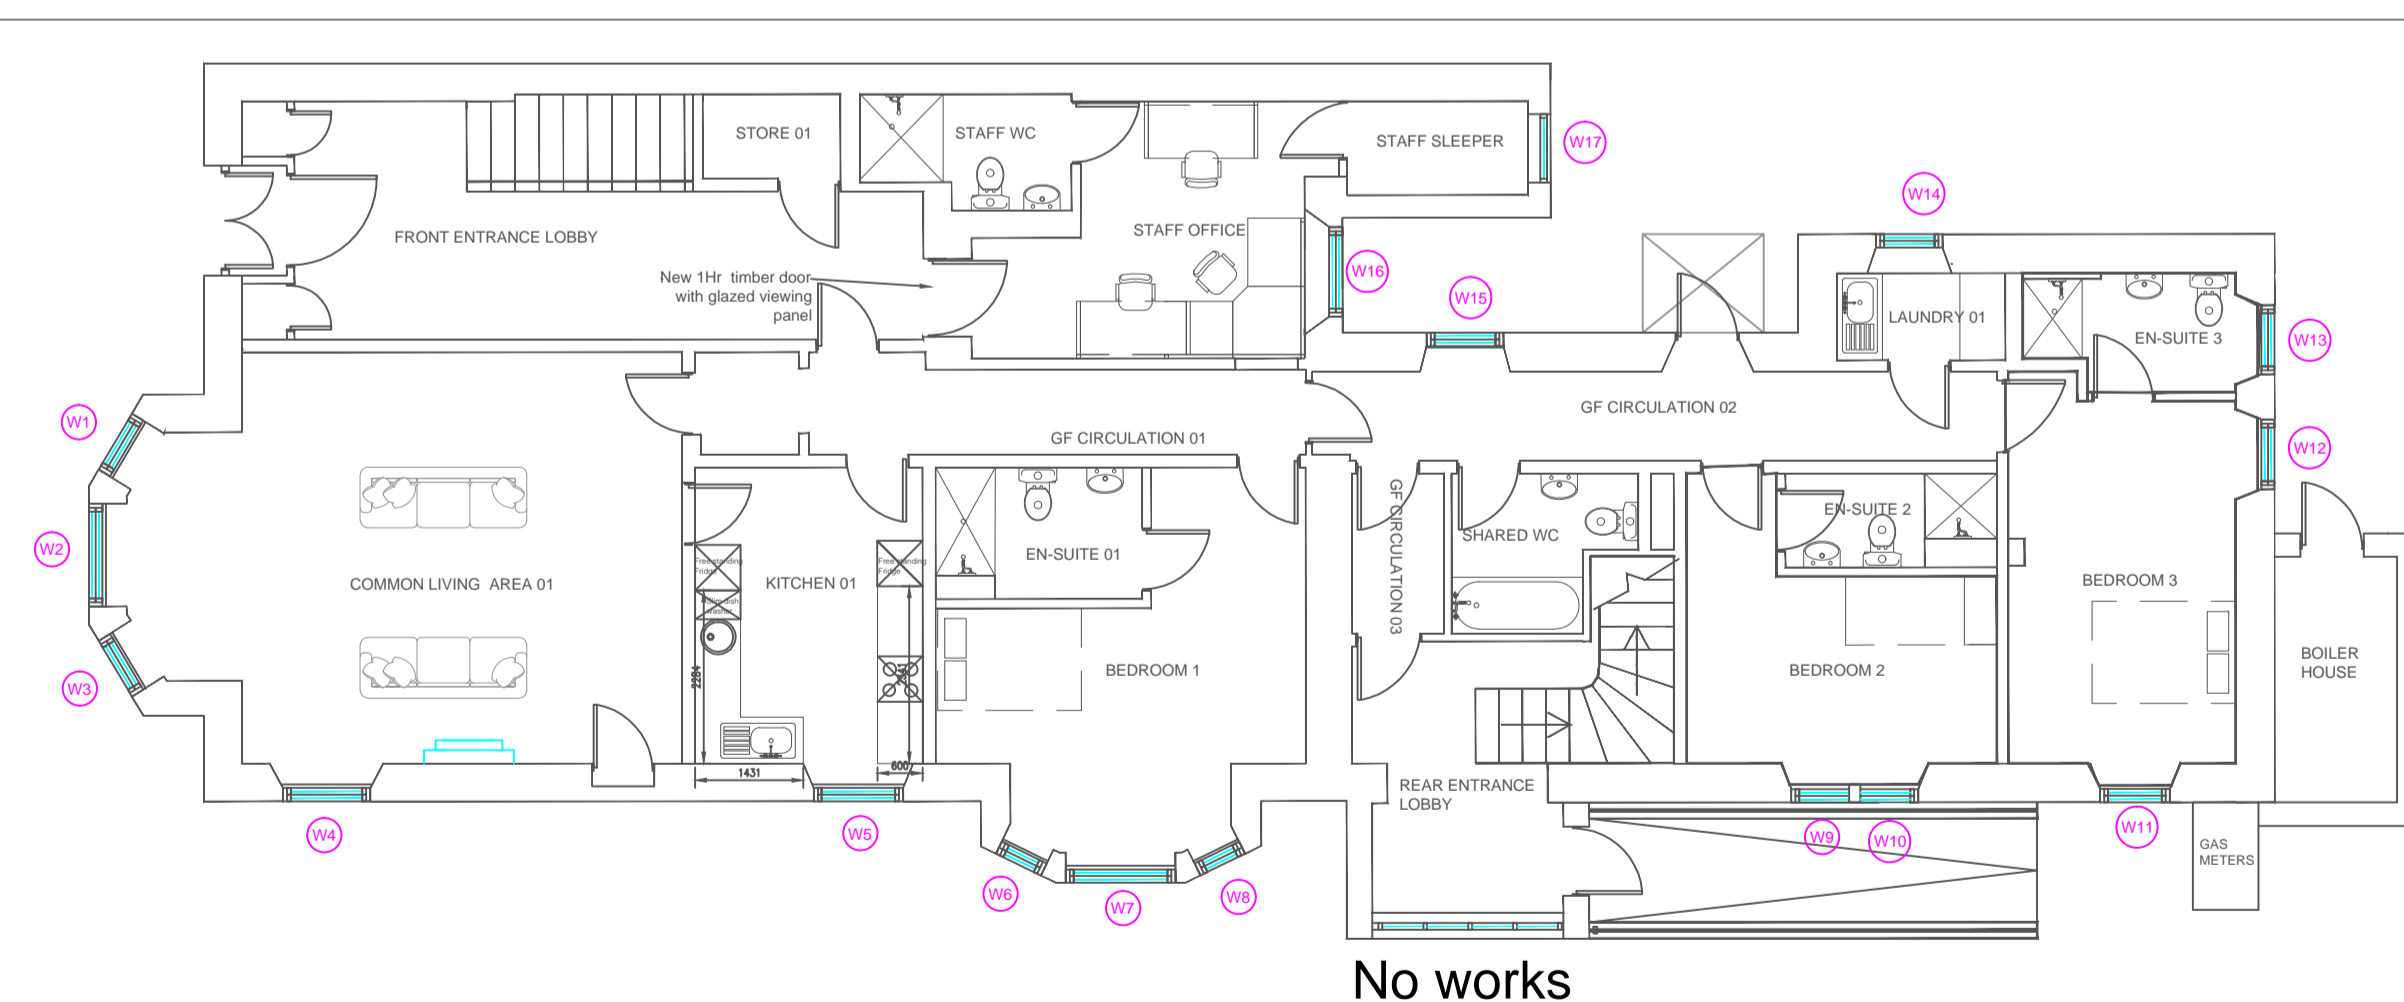

Window Reference	Opening Size (mm)	Location	Window Type	Double glazed	Internal Colour	External Colour	Trickle Vent	Lock	Restrictor	Glass type
W1	2753x887	Ground Floor Common Living 1	Bar's Timber Sash and Casement	Yes	White	White	Yes	Yes	Yes	Safety
W2	2753x1305	Ground Floor Common Living 1	Bar's Timber Sash and Casement	Yes	White	White	Yes	Yes	Yes	Safety
W3	2753x887	Ground Floor Common Living 1	Bar's Timber Sash and Casement	Yes	White	White	Yes	Yes	Yes	Safety
W4	2753x1156	Ground Floor Common Living 1	Bar's Timber Sash and Casement	Yes	White	White	Yes	Yes	Yes	Safety
W5	2751x1190	Ground Floor Kitchen 01	Bar's Timber Sash and Casement	Yes	White	White	Yes	Yes	Yes	Safety
W6	2756x858	Ground Floor Bedroom 01	Bar's Timber Sash and Casement	Yes	White	White	Yes	Yes	Yes	Safety
W7	2756x1448	Ground Floor Bedroom 01	Bar's Timber Sash and Casement	Yes	White	White	Yes	Yes	Yes	Safety
W8	2757x858	Ground Floor Bedroom 01	Bar's Timber Sash and Casement	Yes	White	White	Yes	Yes	Yes	Safety
W9	2867x822	Ground Floor Bedroom 02	Bar's Timber Sash and Casement	Yes	White	White	Yes	Yes	Yes	Safety
W10	2867x822	Ground Floor Bedroom 02	Bar's Timber Sash and Casement	Yes	White	White	Yes	Yes	Yes	Safety
W11	2420x922	Ground Floor Bedroom 03	Bar's Timber Sash and Casement	Yes	White	White	Yes	Yes	Yes	Safety
W12	2522x922	Ground Floor Bedroom 03	Bar's Timber Sash and Casement	Yes	White	White	Yes	Yes	Yes	Safety
W13	2521x913	Ground Floor En-Suite 03	Bar's Timber Sash and Casement	Yes	White	White	Yes	Yes	Yes	Safety obscured
W14	2525x880	Ground Floor Laundry 01	Bar's Timber Sash and Casement	Yes	White	White	Yes	Yes	Yes	Safety
W15	2620x1010	Ground Floor GF Circulation 02	Bar's Timber Sash and Casement	Yes	White	White	Yes	Yes	Yes	Safety
W16	2618x1184	Ground Floor Staff Office	Bar's Timber Sash and Casement	Yes	White	White	Yes	Yes	Yes	Safety
W17	1575x805	Ground Floor Staff Sleeper	Bar's Timber Sash and Casement	Yes	White	White	Yes	Yes	Yes	Safety

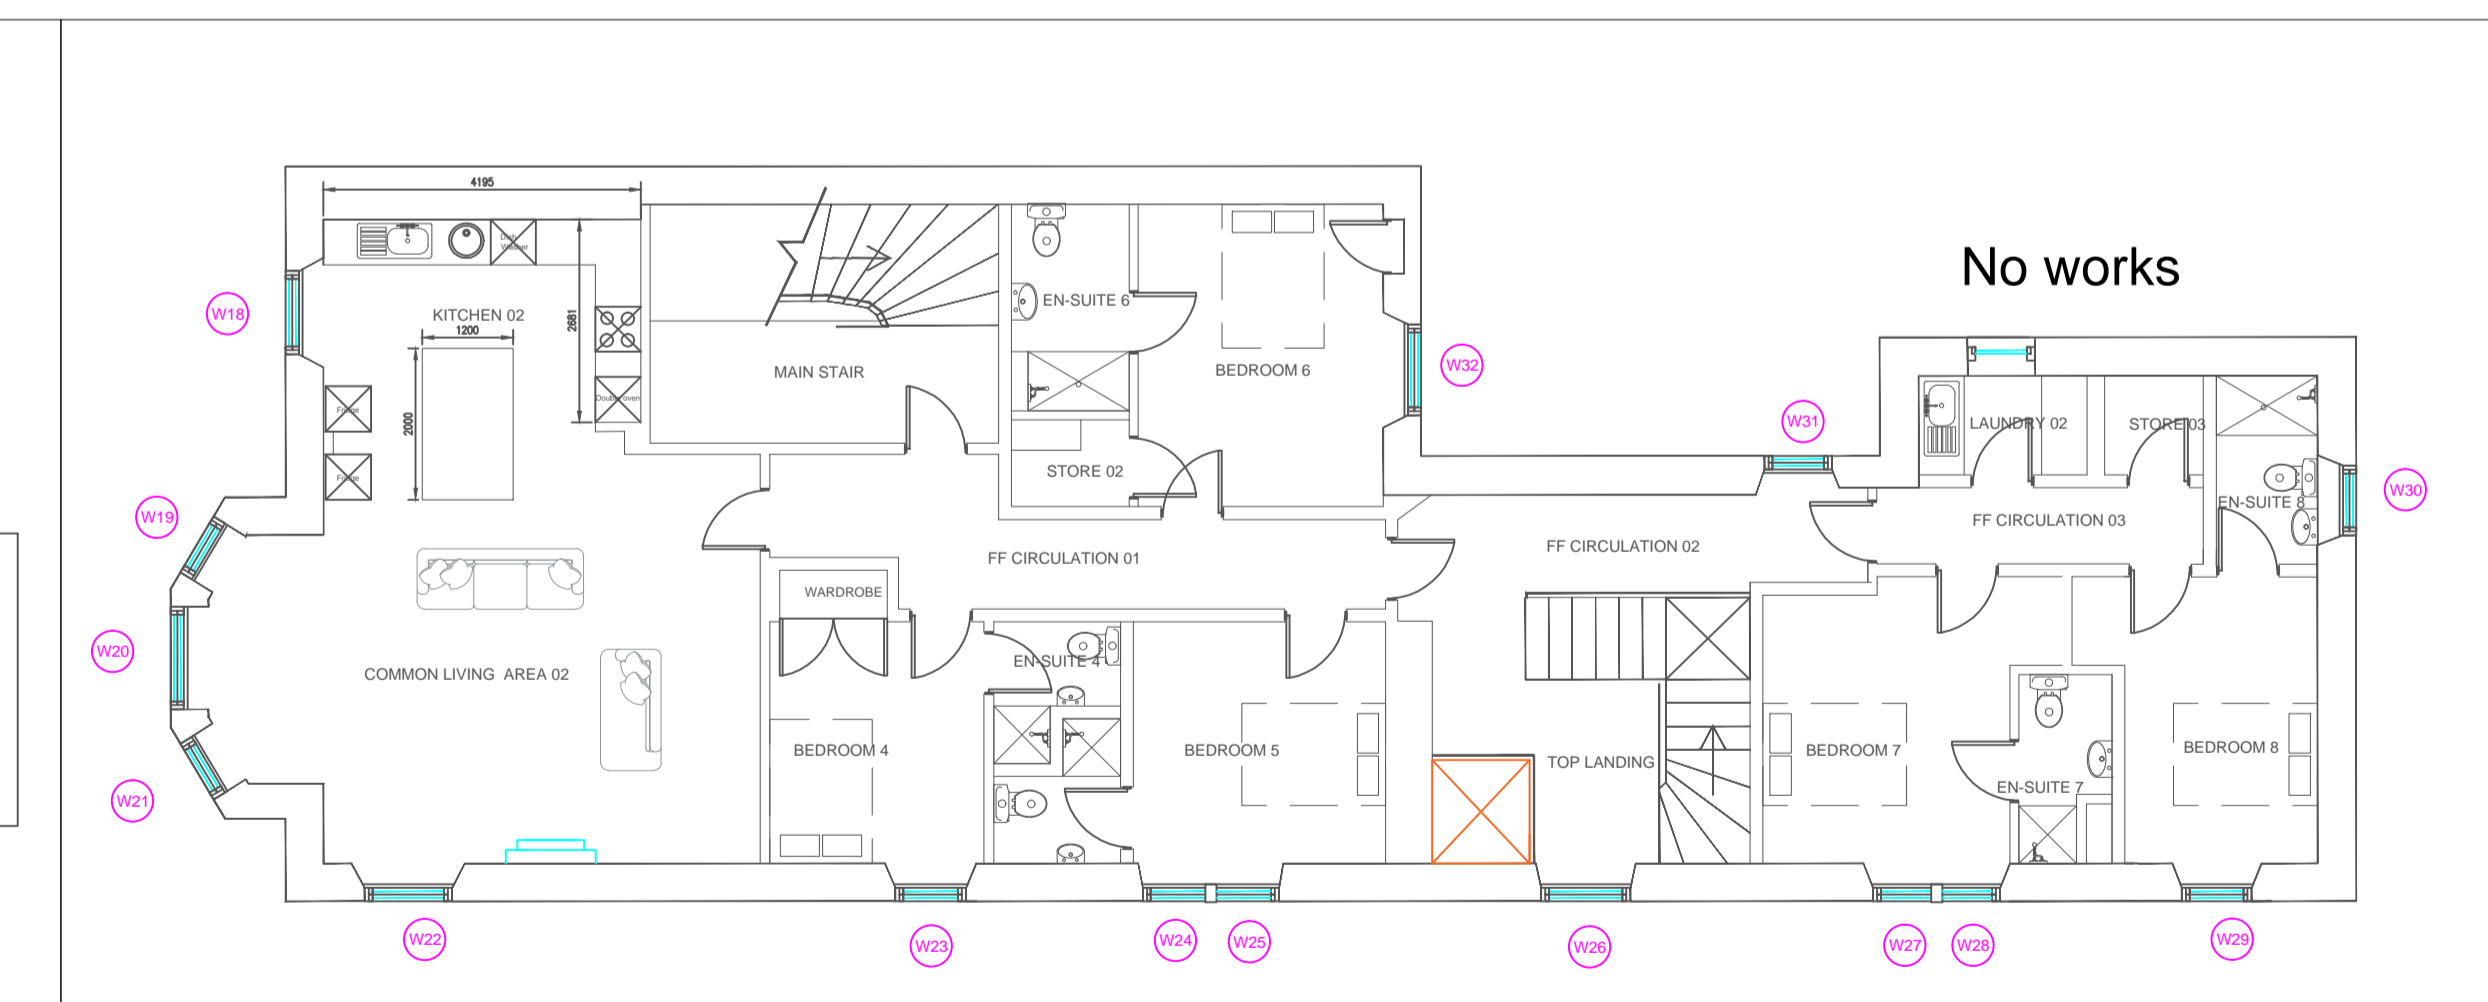

Window Reference	Opening Size (mm)	Location	Window Type	Double glazed	Internal Colour	External Colour	Trickle Vent	Lock	Restrictor	Glass type
W18	2587x1099	First Floor Kitchen 02	Bar's Timber Sash and Casement	Yes	White	White	Yes	Yes	Yes	Safety
W19	2587x887	First Floor Common Living 02	Bar's Timber Sash and Casement	Yes	White	White	Yes	Yes	Yes	Safety
W20	2587x1305	First Floor Common Living 02	Bar's Timber Sash and Casement	Yes	White	White	Yes	Yes	Yes	Safety
W21	2587x887	First Floor Common Living 02	Bar's Timber Sash and Casement	Yes	White	White	Yes	Yes	Yes	Safety
W22	2587x1157	First Floor Common Living 02	Bar's Timber Sash and Casement	Yes	White	White	Yes	Yes	Yes	Safety
W23	2740x824	First Floor Bedroom 04	Bar's Timber Sash and Casement	Yes	White	White	Yes	Yes	Yes	Safety
W24	2740x850	First Floor Bedroom 05	Bar's Timber Sash and Casement	Yes	White	White	Yes	Yes	Yes	Safety
W25	2740x850	First Floor Bedroom 05	Bar's Timber Sash and Casement	Yes	White	White	Yes	Yes	Yes	Safety
W26	2740x1190	First Floor FF Circulation 02	Bar's Timber Sash and Casement	Yes	White	White	Yes	Yes	Yes	Safety
W27	2740x800	First Floor Bedroom 07	Bar's Timber Sash and Casement	Yes	White	White	Yes	Yes	Yes	Safety
W28	2740x800	First Floor Bedroom 07	Bar's Timber Sash and Casement	Yes	White	White	Yes	Yes	Yes	Safety
W29	2740x823	First Floor Bedroom 08	Bar's Timber Sash and Casement	Yes	White	White	Yes	Yes	Yes	Safety
W30	2740x823	First Floor Bedroom 08	Bar's Timber Sash and Casement	Yes	White	White	Yes	Yes	Yes	Safety
W31	2525x880	First Floor FF Circulation 02	Bar's Timber Sash and Casement	Yes	White	White	Yes	Yes	Yes	Safety obscured
W32	2548x1200	First Floor Bedroom 06	Bar's Timber Sash and Casement	Yes	White	White	Yes	Yes	Yes	Safety

08-06-21	Planning Issue	AN	SS	AN
----------	----------------	----	----	----

CLIENT :
The Richmond Fellowship Scotland

PROJECT :
10 Oakley Terrace

TITLE :
Existing Windows



THIS DRAWING IS THE PROPERTY OF
BROWN+WALLACE
 22 James Morrison Street
 GLASGOW
 G1 5PE

TEL: 0141 552 8881 FAX: 0141 552 8882
 COPYRIGHT IS RESERVED BY THEM AND THE DRAWING IS ISSUED ON THE
 CONDITION THAT IT IS NOT COPIED, REPRODUCED, RETAINED OR DISCLOSED TO
 ANY UNAUTHORIZED PERSON, EITHER WHOLLY OR IN PART WITHOUT THE CONSENT
 IN WRITING OF BROWN + WALLACE.

PROJECT No.	DRAWING No.	REVISION
3203	018	

EXISTING