

NOTES

Rev.	Amendments	Date	Chkd.

Client
Mr Mohammad Farooq Azami

STS Structural Engineering Ltd
 58 Crossway, Welwyn Garden City, Hertfordshire, AL8 7EE
 Tel: 01707 695466 Fax: 01707 692006
 Web: www.sts-se.co.uk Email: sia@sts-se.co.uk


Project
27 Burdon Lane, Cheam, Sutton, London SM2 7PP

Title
Second Floor Plan - As Built

Drawn	NK	Date	Jul'21	Scale
Checked	MN, DS	Date	Jul'21	1 : 50
Approved	SS	Date	Jul'21	Size A1

Drawing No. 1910-1220-403 Rev. →

7/22/2021 5:05:56 PM

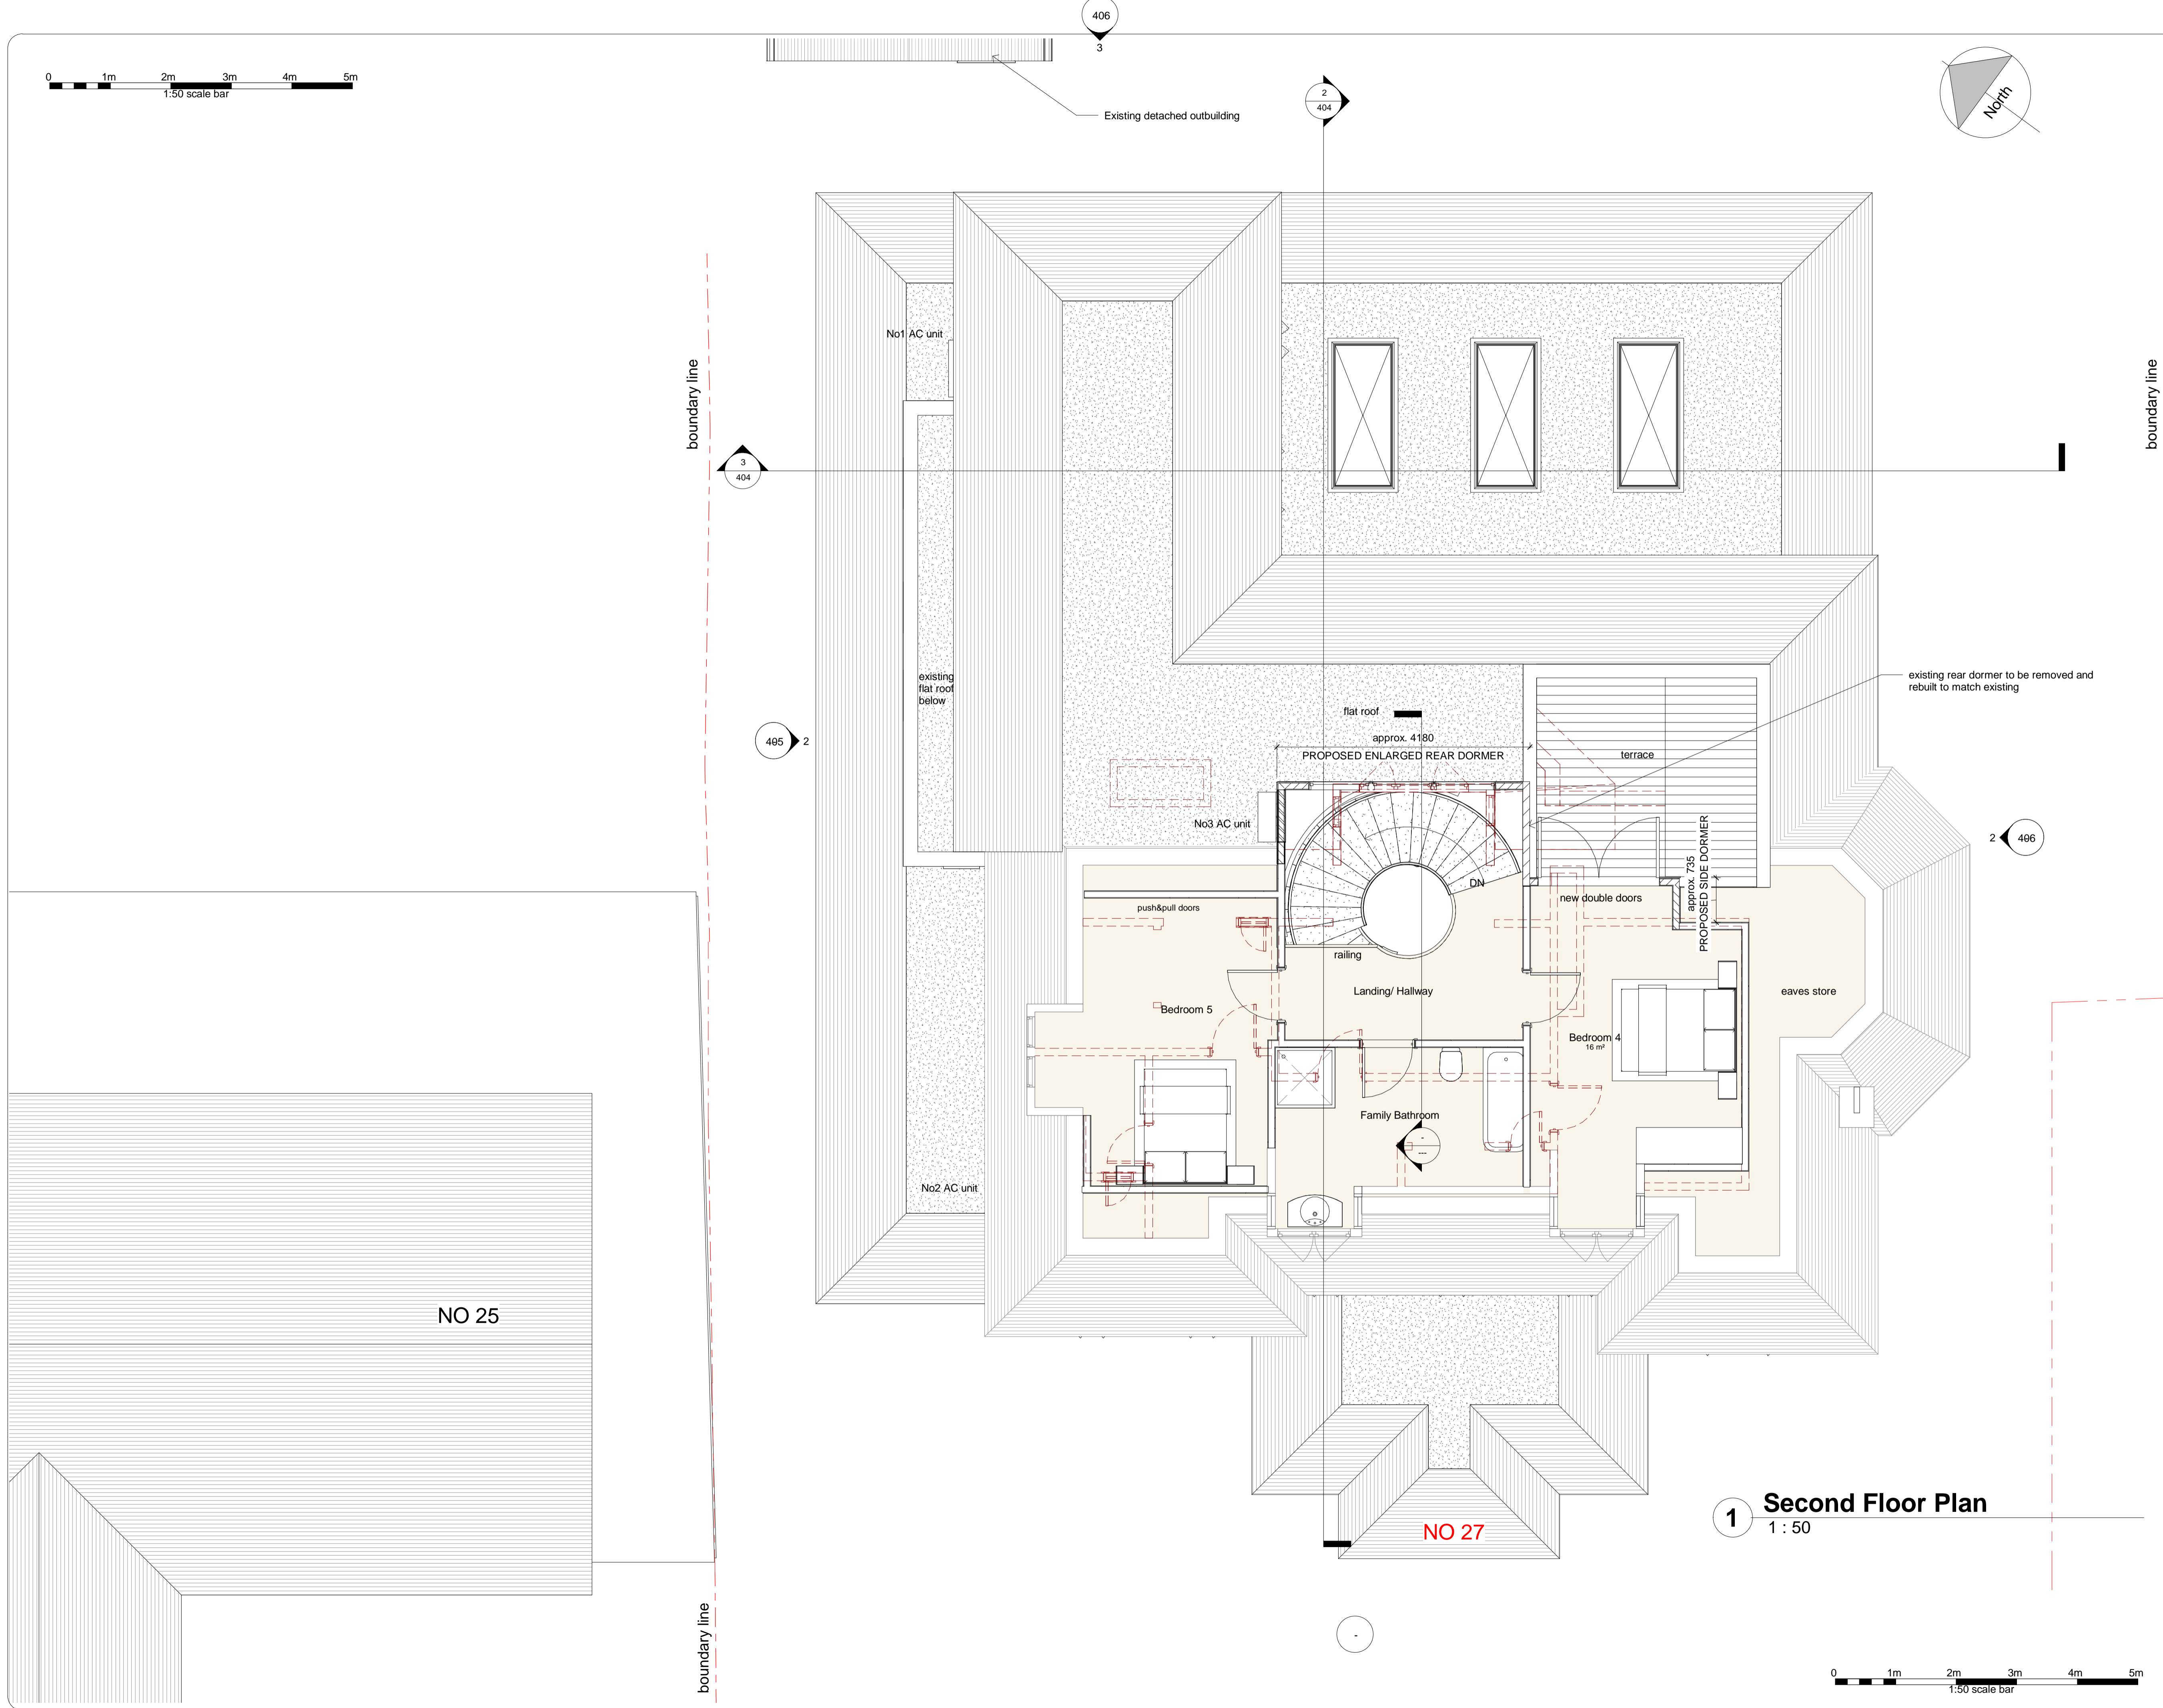

NO 25

NO 27

1 Second Floor Plan
1 : 50