



NOTES

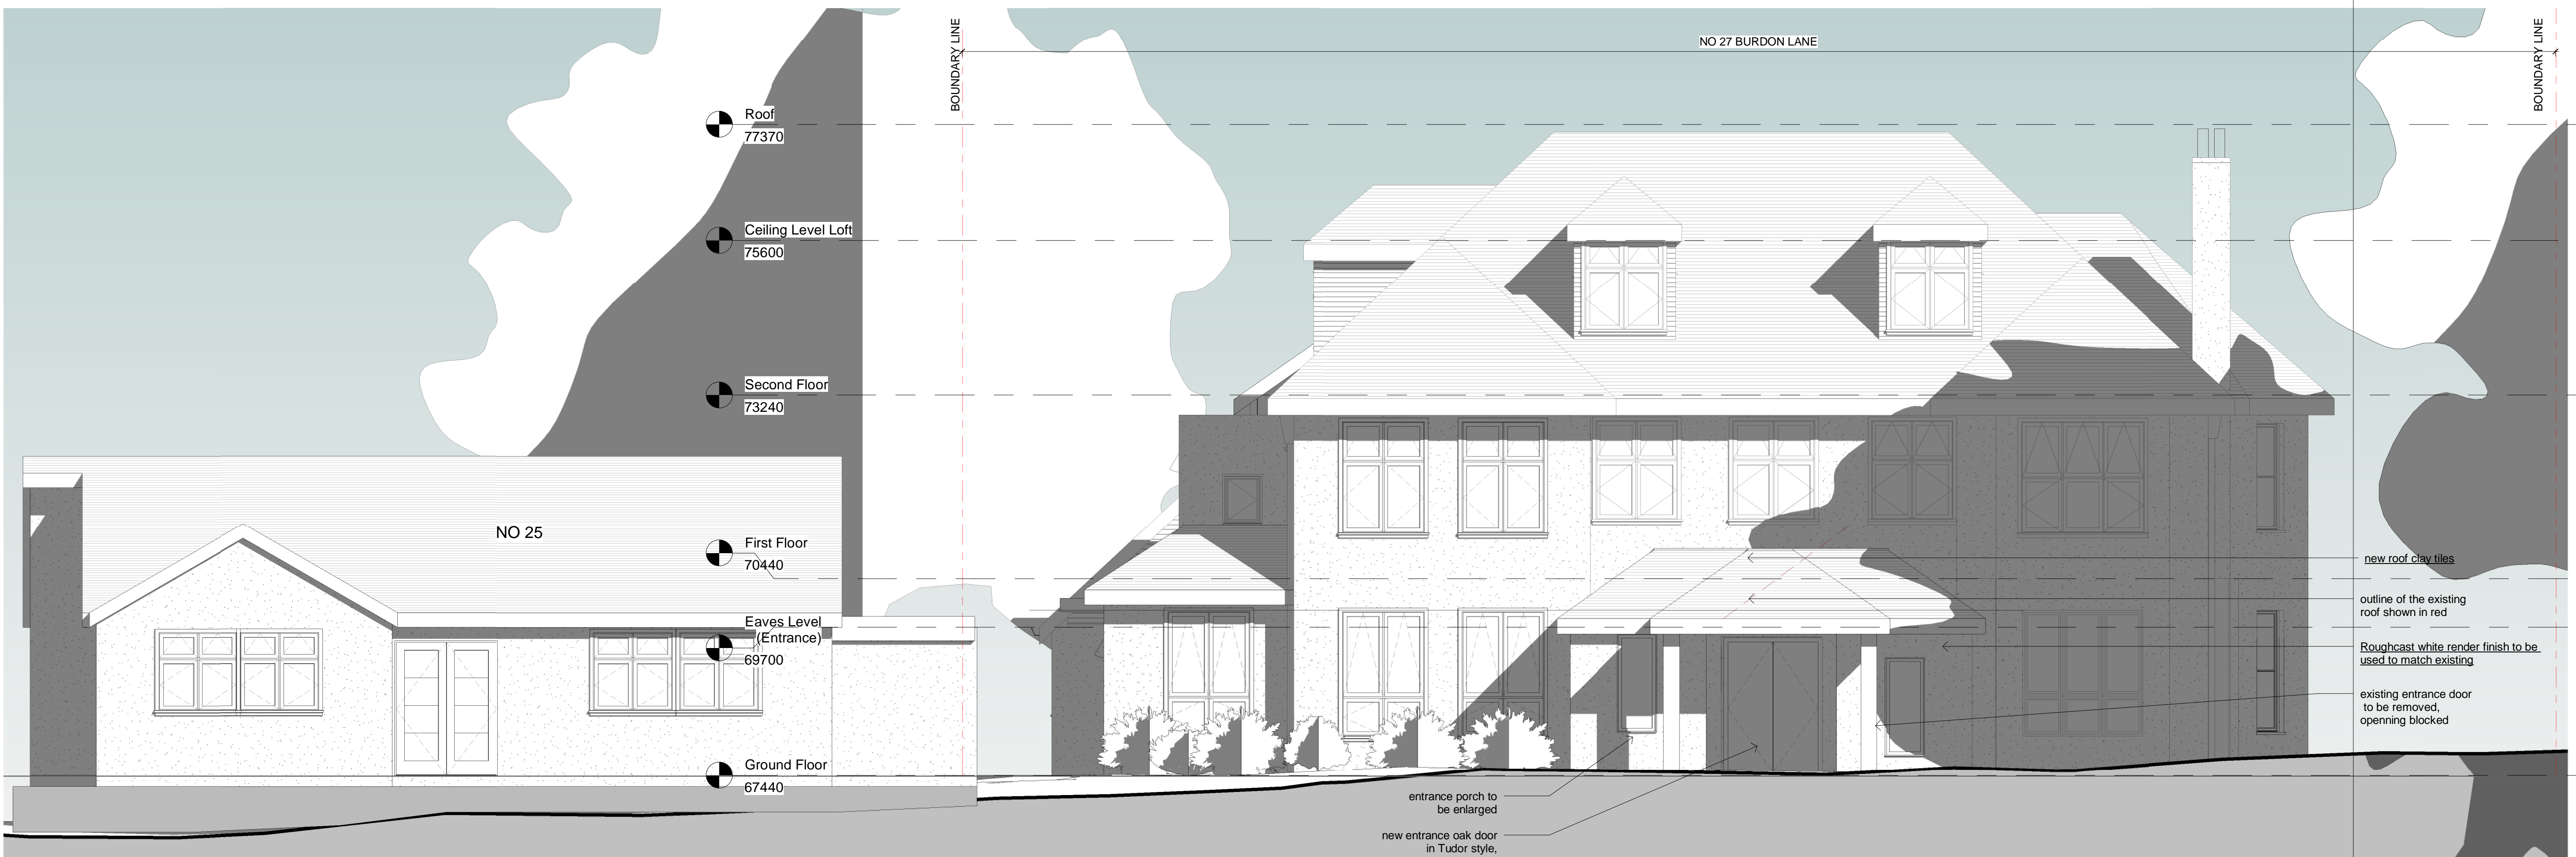

1 Proposed Front Elevation
1 : 50

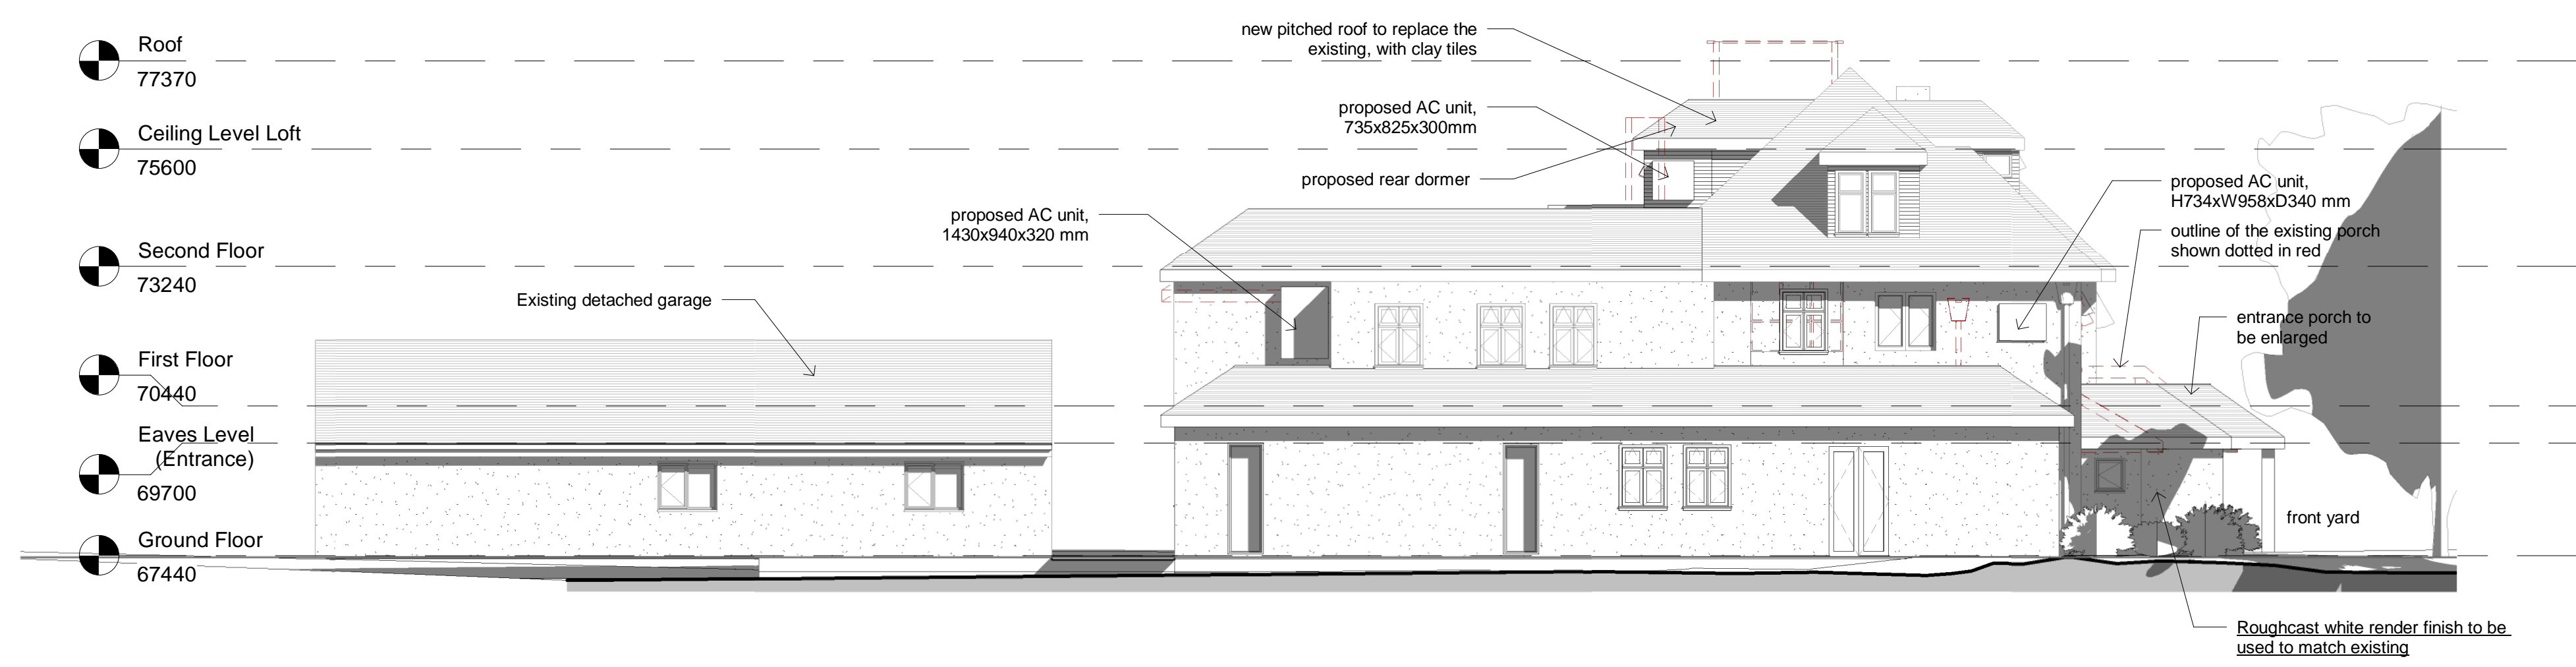

2 Proposed Side Elevation (North)
1 : 100

Rev.	Amendments	Date	Chkd.

Client
Mr Mohammad Farooq Azami

STS Structural Engineering Ltd
58 Crossway, Welwyn Garden City, Hertfordshire, AL8 7EE
Tel: 01707 695466 Fax: 01707 692006
Web: www.sts-se.co.uk Email: sia@sts-se.co.uk

Project
27 Burdon Lane, Cheam, Sutton, London SM2 7PP

Title
As Built Front and Side Elevations

Drawn	NK	Date	Jul'21	Scale	AS indicated
Checked	DS, MN	Date	Jul'21		
Approved	SS	Date	Jul'21	Size	A1

Drawing No.
1910-1220-405

